

PREPARED FOR
SHOREWEST
REALTORS

ORDERED BY
CAROL STANCZAK



PLAT OF SURVEY

- OF -

PARCEL 1: Lots 16 and 17, Block 12, Skansen Swedish
Tribune-News Subdivision, being part of the Southwest 1/4 of
Government Lot 6 in Section 9, Town 3 North, Range 15 East,
Town of Richmond, Walworth County, Wisconsin.

PARCEL 2: Lots 18 and 19, Block 12, Skansen Swedish
Tribune-News Subdivision, being part of the Southwest 1/4 of
Government Lot 6 in Section 9, Town 3 North, Range 15 East,
Town of Richmond, Walworth County, Wisconsin.

PATHFINDER SURVEYING
(a NMB Company)
P.O BOX 322
LAKE GENEVA, WI. 53147
WWW.PATHFINDERSURVEYING.NET
262-248-8303

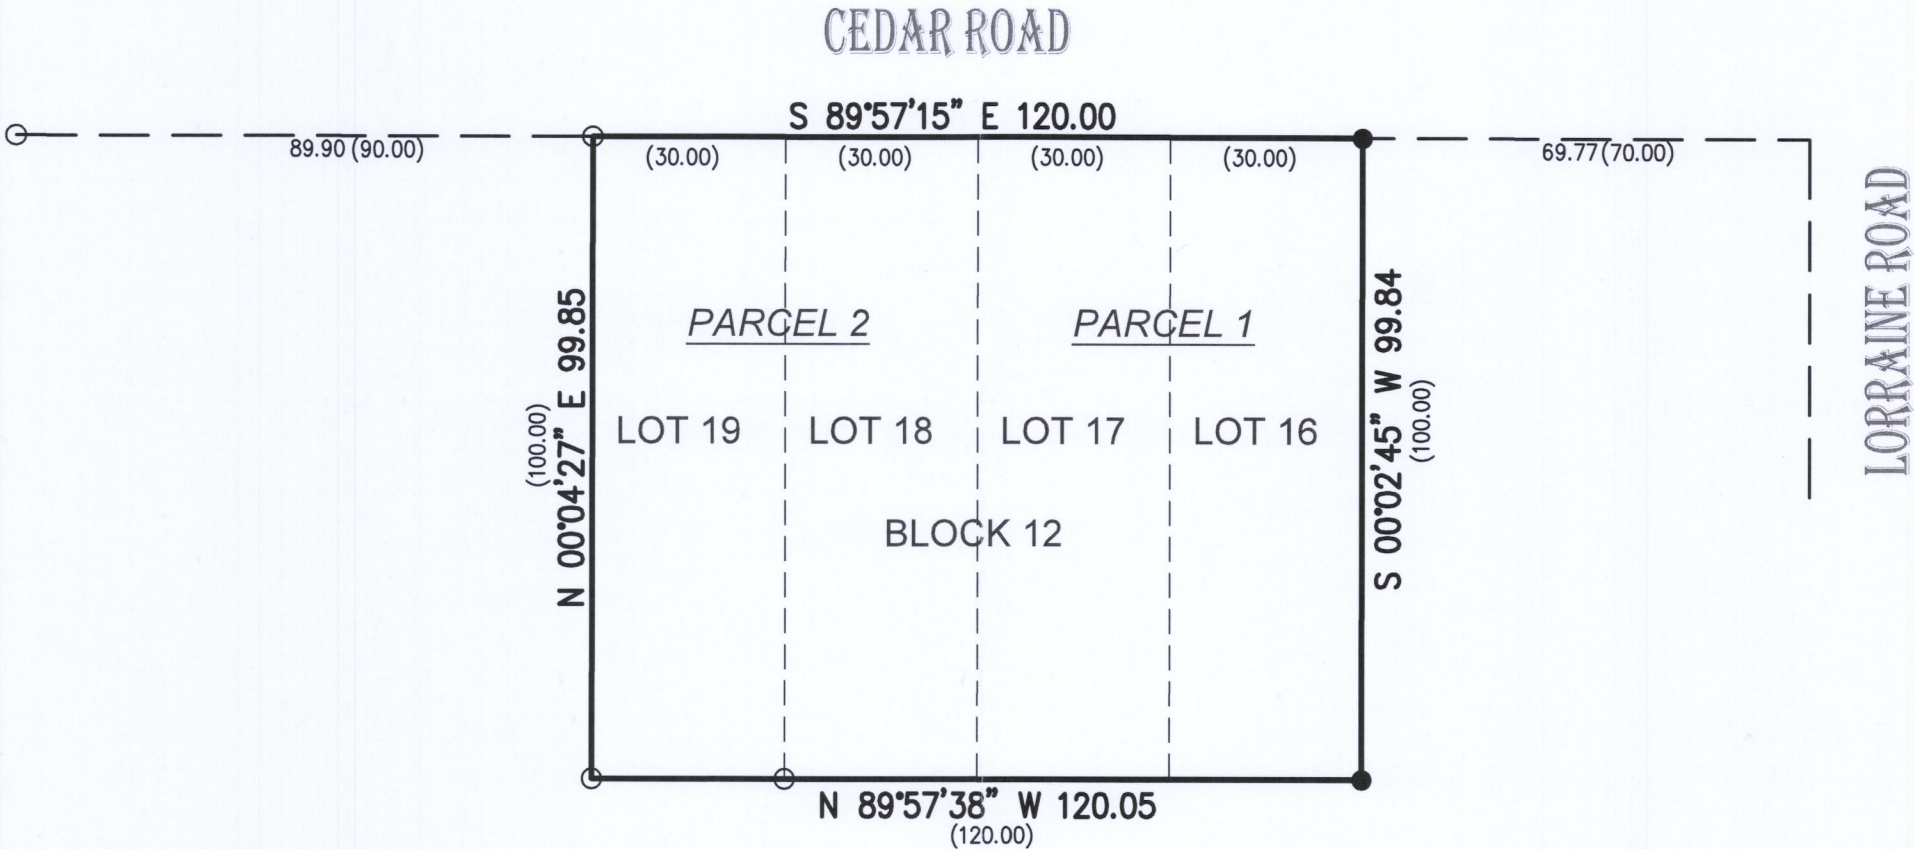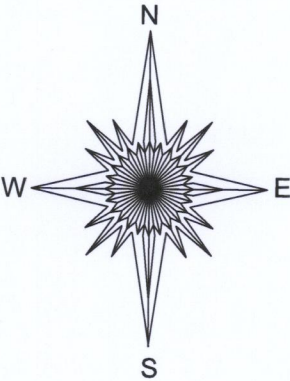

- () = recorded as
- = set 5/8" rebar
- = found iron pipe

SCALE 1" = 30'

JOB # 2018.0025.01


TAX ID # CS 00197 CS 00198

BASIS OF BEARING OF THIS PLAT: THE US STATE PLANE
COORDINATE SYSTEM SOUTH ZONE, NAD 83. WISCORS.

I hereby certify that I have surveyed the above- described property and the
above map is a true representation thereof and shows the size and
location of the property, its exterior boundaries, the location and dimensions
of all structures thereon, fences, apparent easements and roadways and
visible encroachments if any to the best of my knowledge and belief.

This survey is made for the present owners of the property, and those who
purchase, mortgage, or guarantee the title thereto, within one year from the
date hereof.

DATED THIS 23RD DAY OF FEBRUARY, 2018.

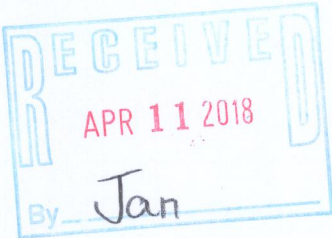

Mark R. Madsen
MARK R. MADSEN S - 2271
Wisconsin Professional Land Surveyor

CS-197
CS-198
315-1323