


PLAT OF SURVEY & TOPOGRAPHIC MAPPING

NORTH HALF OF LOT 15 & LOT 16 OF BLOCK G OF CRYSTAL BOWL SUBDIVISION

LOCATED IN PART OF THE NE 1/4 OF THE NW 1/4
OF SECTION 13, TOWN 3 NORTH, RANGE 15 EAST,
TOWN OF RICHMOND, WALWORTH COUNTY, WISCONSIN

ASSIGNED N. LINE OF LANDS SURVEYED
N 84°29'24" E

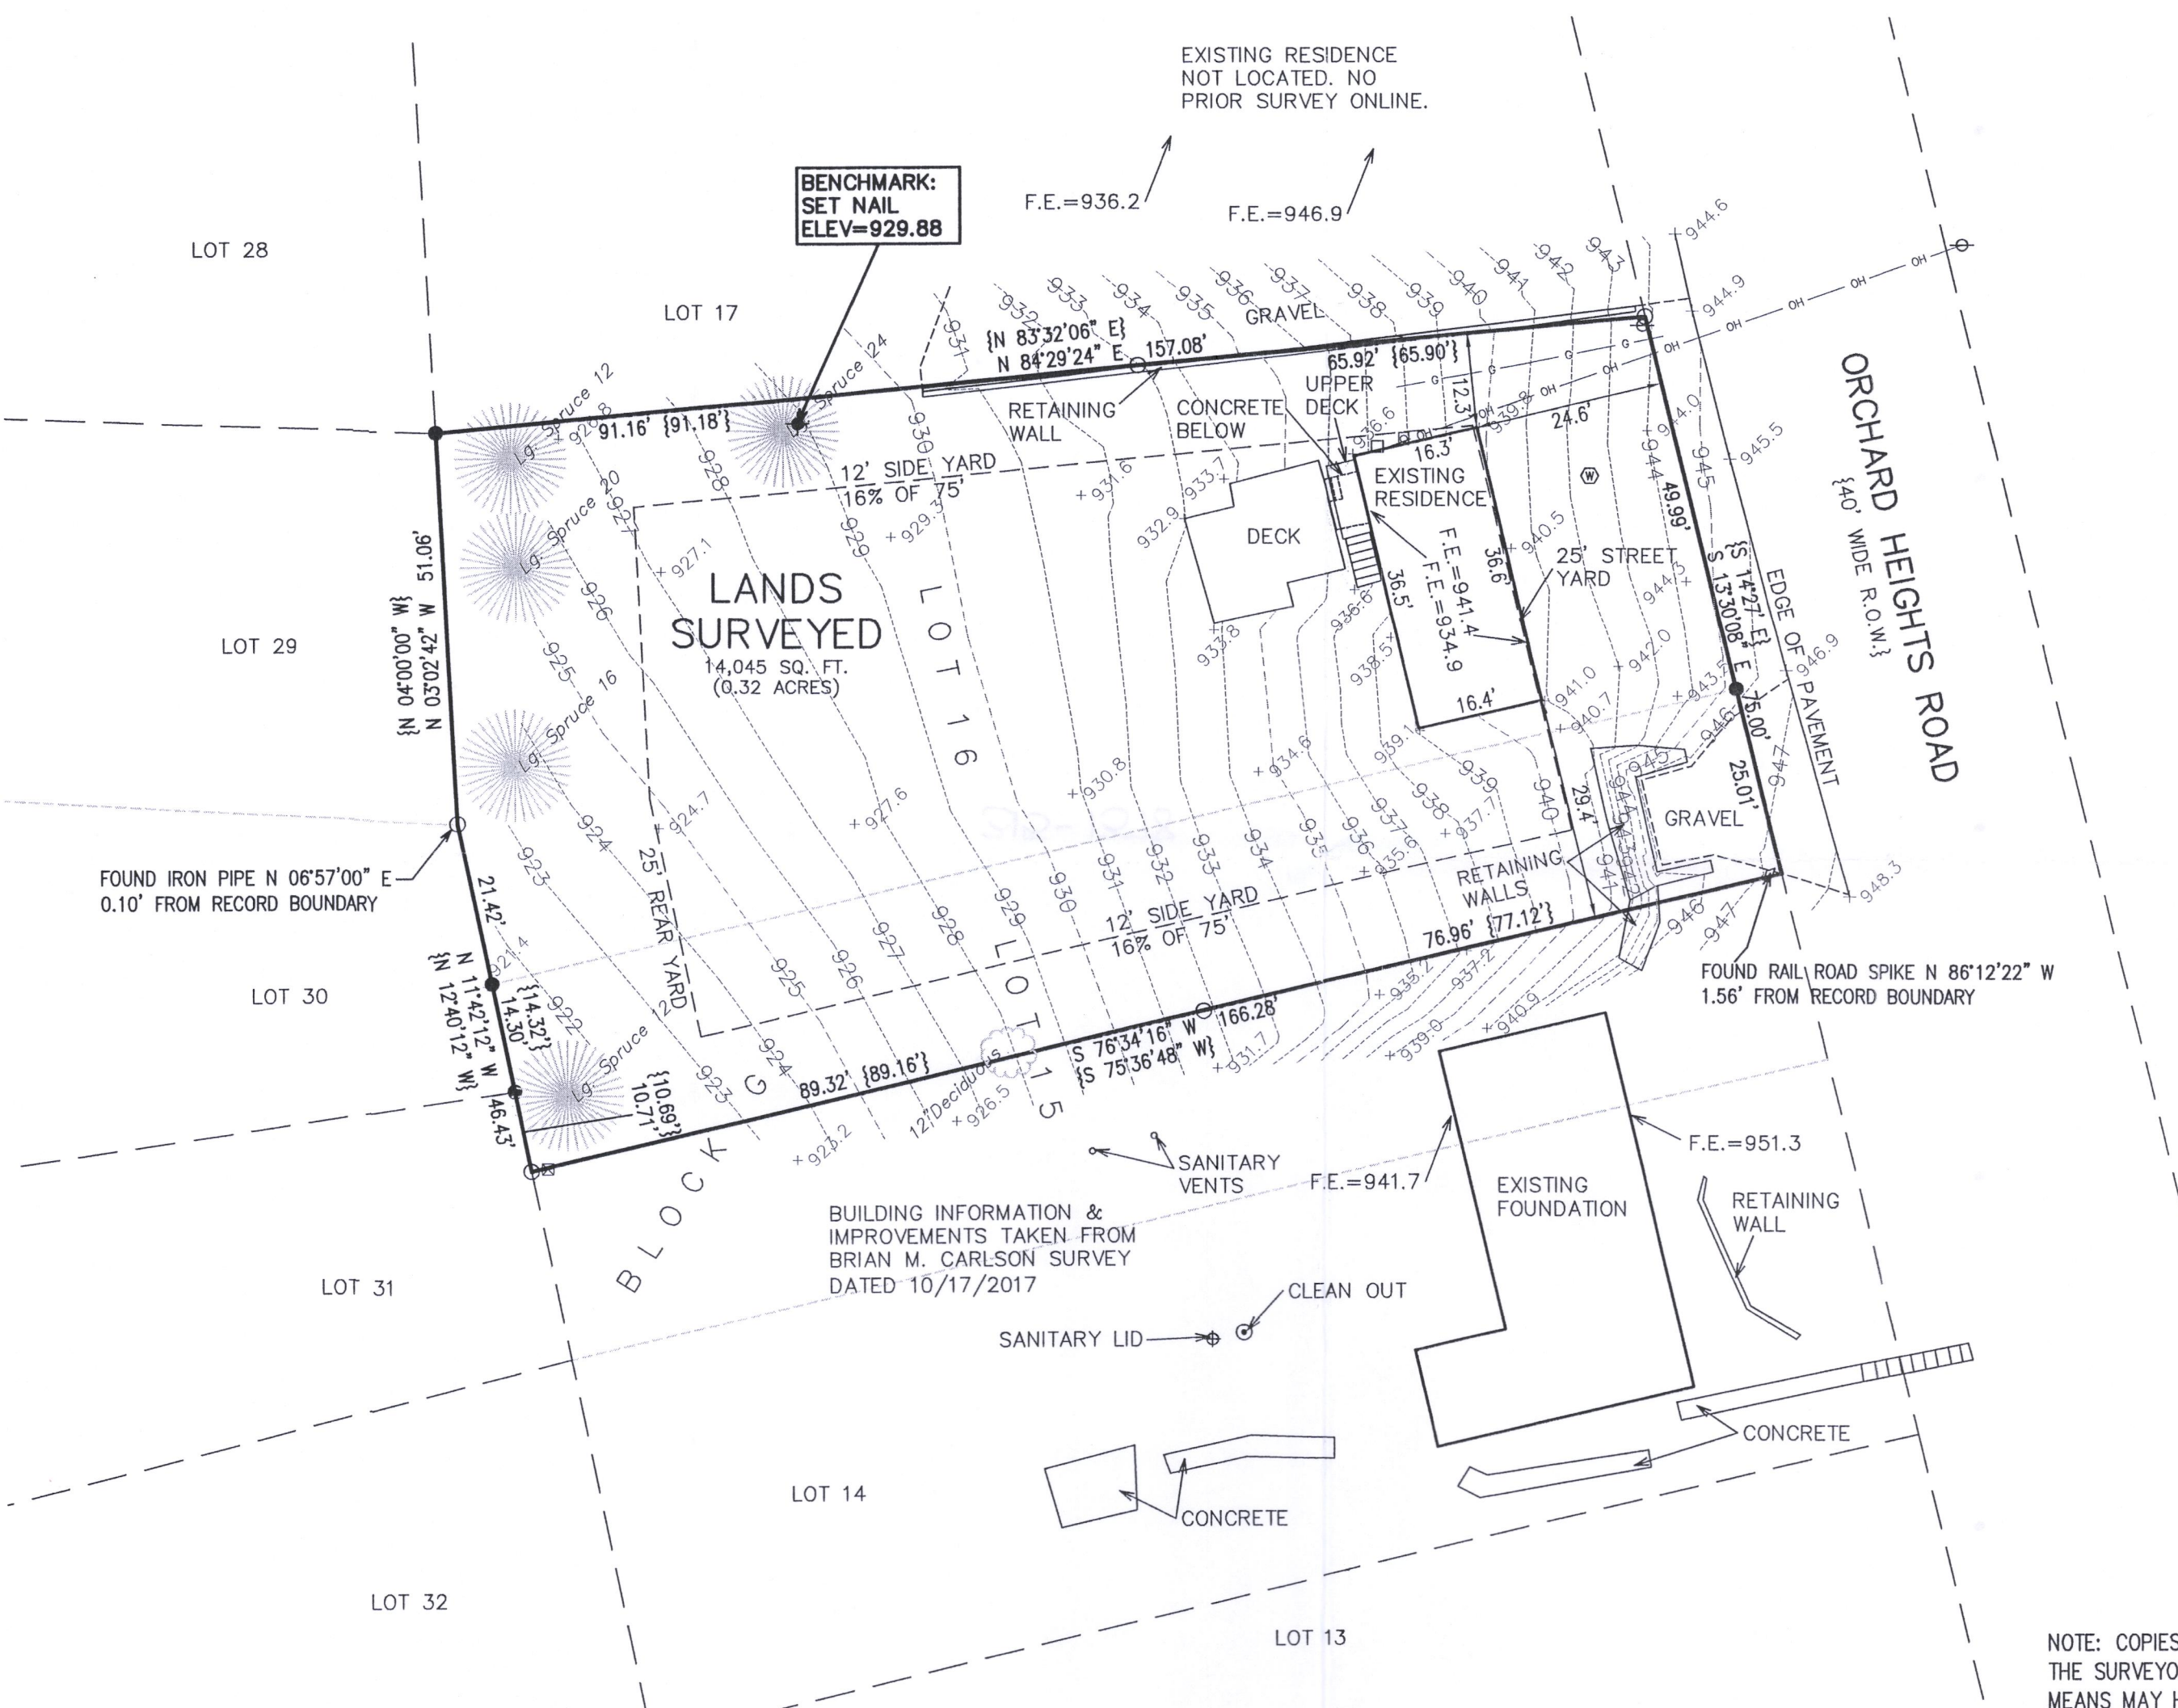

- LEGEND**
- = FOUND IRON PIPE STAKE
 - ▧ = FOUND RAIL ROAD SPIKE
 - = FOUND REBAR STAKE
 - ⊕ = WELL
 - ⊠ = GAS METER
 - ⊡ = ELECTRIC METER
 - ⊞ = TELEPHONE BOX
 - ⊕ = UTILITY POLE
 - OH — = OVERHEAD WIRE
 - G — = GAS LINE
 - {XXX} = RECORDED AS

RECEIVED
APR 30 2020
By *smf*

NOTE: COPIES OF THIS MAP TO WHICH THE FOLLOWING CERTIFICATE WILL APPLY SHOW THE SURVEYOR'S ORIGINAL SEAL AND SIGNATURE IN RED INK. COPIES BY ANY OTHER MEANS MAY HAVE ALTERATIONS WHICH DO NOT REPRESENT THE SURVEYOR'S WORK PRODUCT.

I HEREBY CERTIFY THAT THE ABOVE DESCRIBED PROPERTY HAS BEEN SURVEYED UNDER MY DIRECTION AND THAT THE ABOVE MAP IS A TRUE REPRESENTATION THEREOF AND SHOWS THE SIZE AND LOCATION OF THE PROPERTY AND ITS EXTERIOR BOUNDARIES. THIS SURVEY IS MADE FOR THE USE OF THE PRESENT OWNERS OF THE PROPERTY, AND ALSO THOSE WHO PURCHASE, MORTGAGE, OR GUARANTEE THE TITLE THERETO WITHIN ONE YEAR FROM THE DATE HEREOF.



DATED: 03/26/2020

B. Carlson
BRIAN M. CARLSON P.L.S. 2039



TOPOGRAPHIC SURVEY
N6485 ORCHARD HEIGHTS
DELAVER, WI 53115


WORK ORDERED BY
WILMA GORMAN
512 S. HOME
PARK RIDGE, IL 60068

FARRIS, HANSEN & ASSOCIATES, INC.
ENGINEERING - ARCHITECTURE - SURVEYING
7 RIDGWAY COURT P.O. BOX 437
ELKHORN, WISCONSIN 53121
OFFICE: (262) 723-2098 FAX: (262) 723-5886

REVISIONS
03/26/2020 - LB
TOPO. SURVEY

PROJECT NO.
10237
DATE:
03/26/2020
SHEET NO.
1 OF 1

X:\PROJECTS\10237\ACAD\10237.DWG

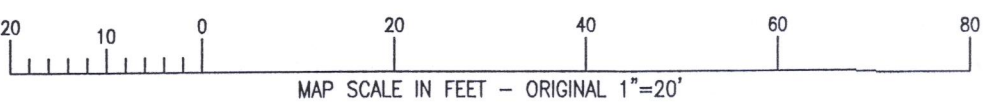

CCR-124

315-1378