


PLAT OF SURVEY – AS BUILT  
LOT 1, BLOCK 3, CHAPEL HILLS SUBDIVISION

LOCATED IN THE NE 1/4 OF THE NE 1/4 OF SECTION 3, TOWN 3 NORTH, RANGE 15 EAST  
TOWN OF RICHMOND, WALWORTH COUNTY, WISCONSIN

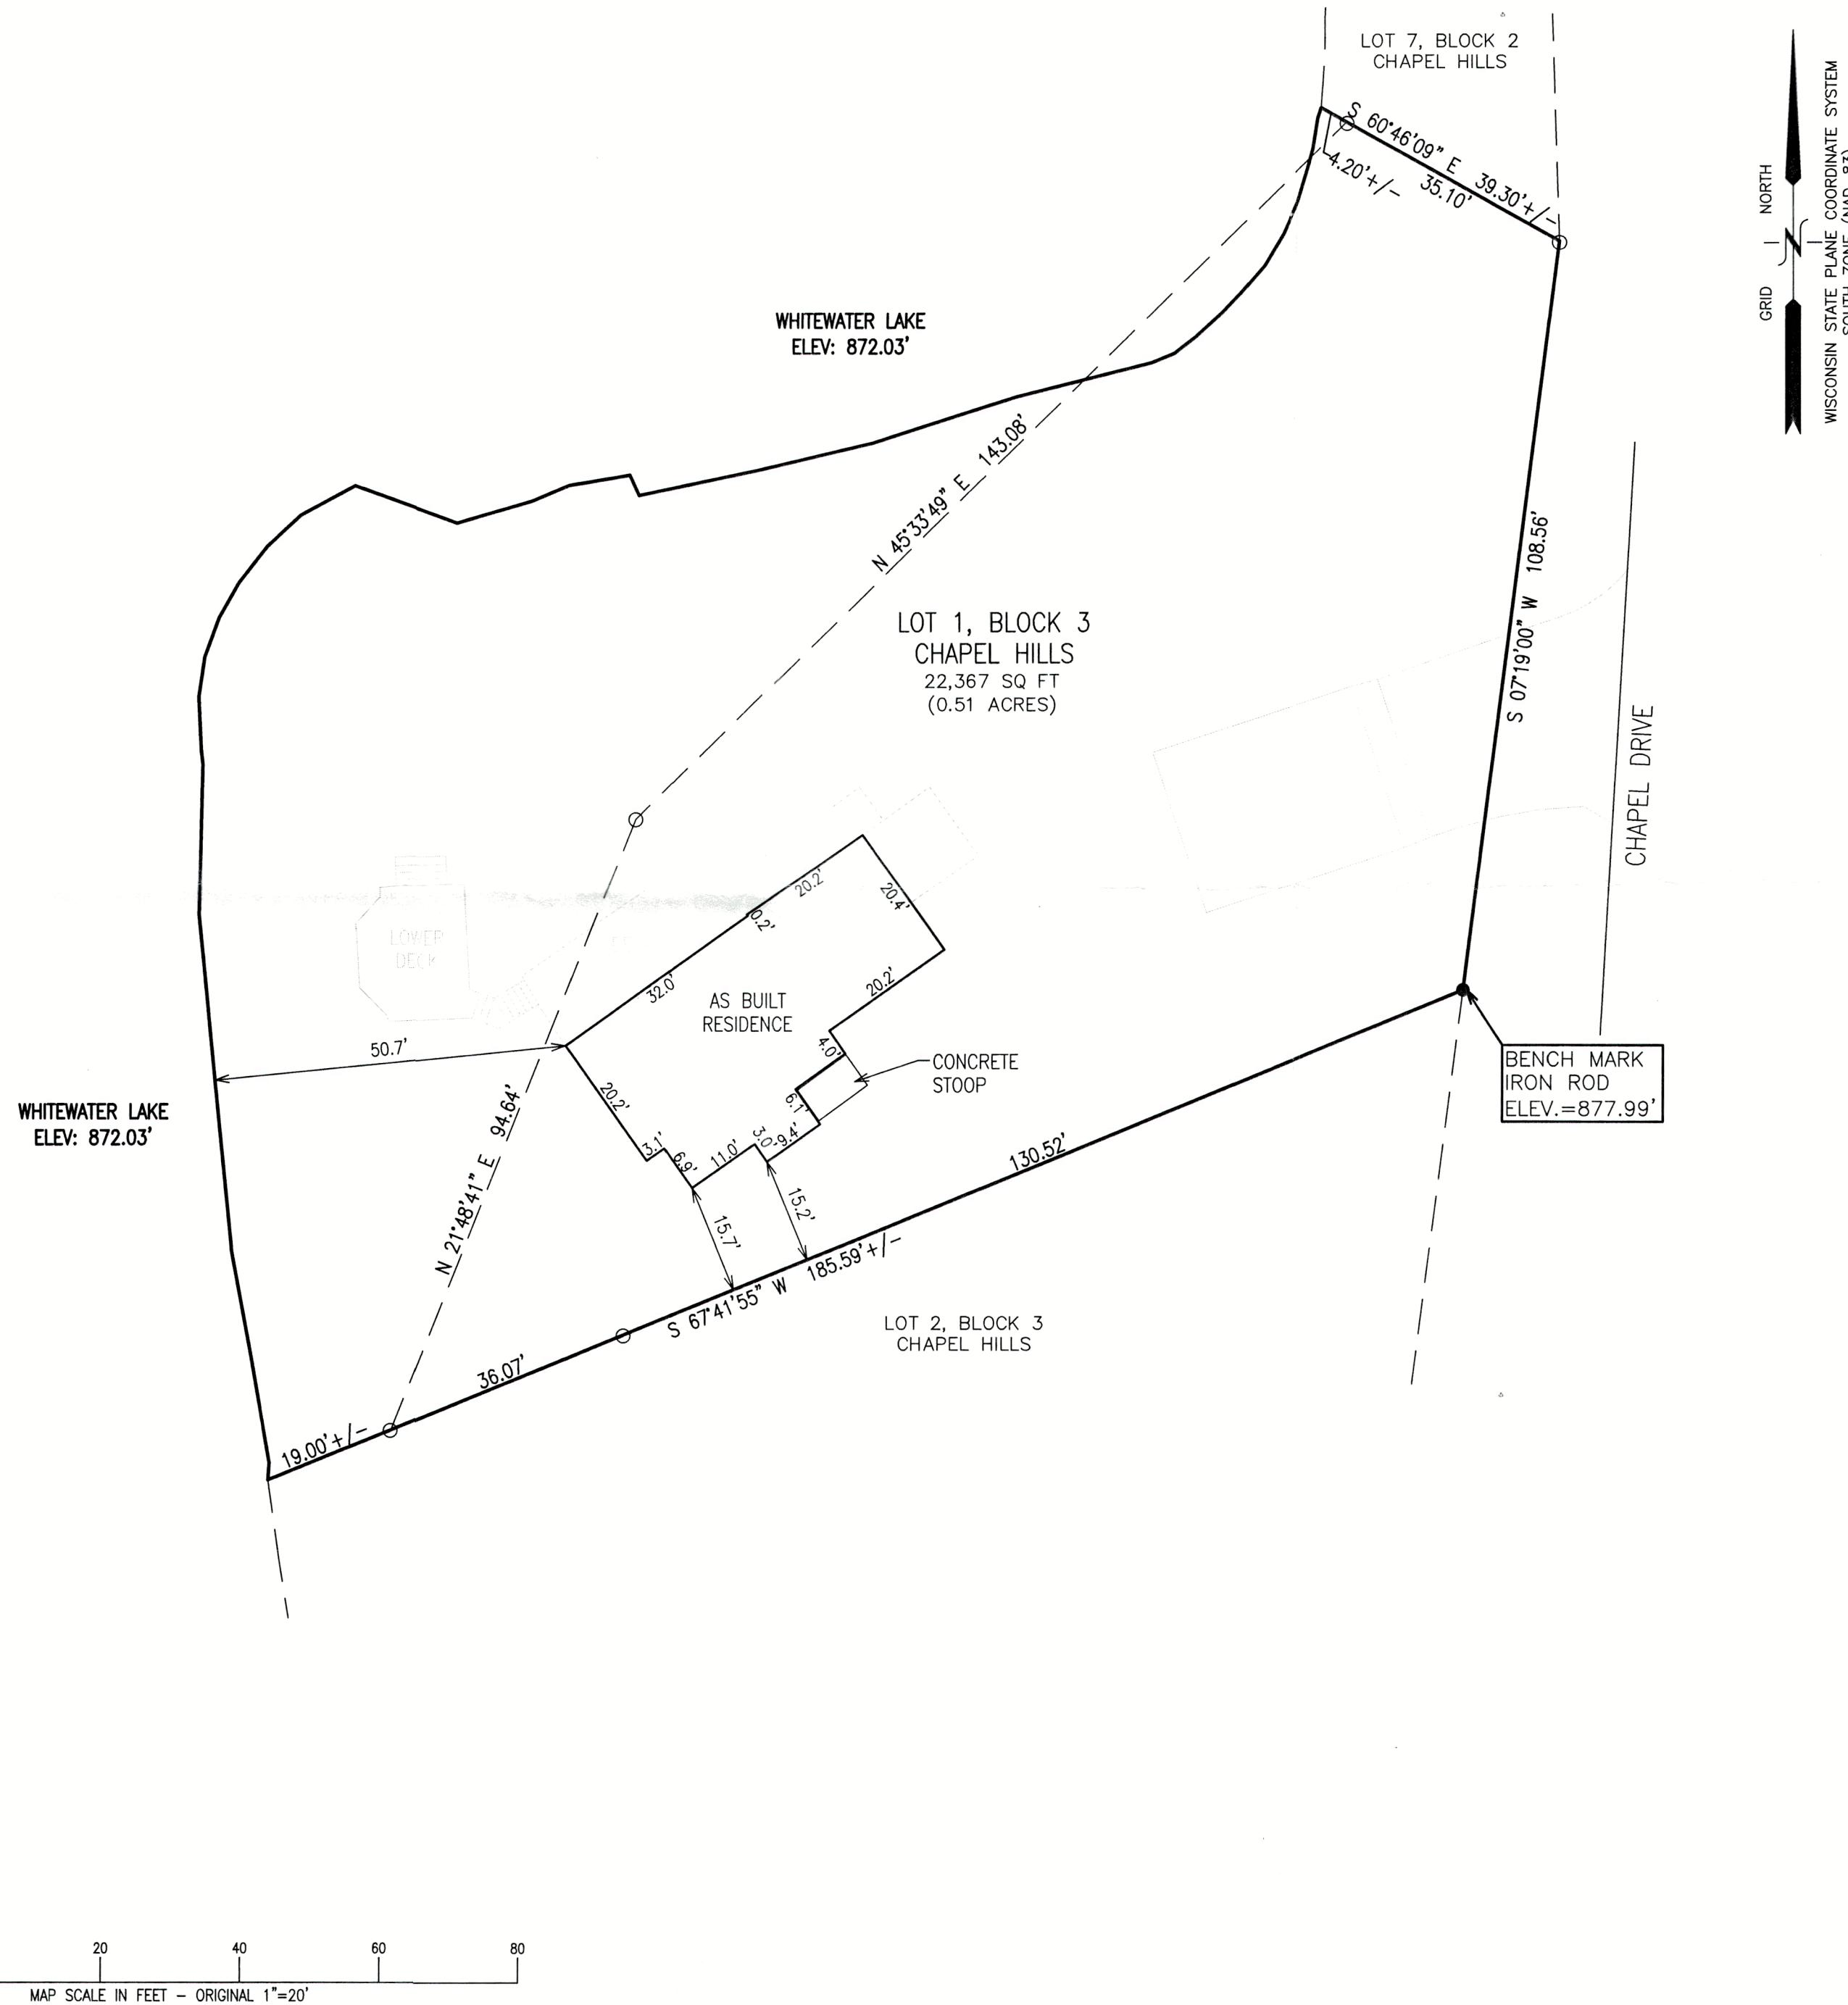


NOTE: PARCEL BOUNDARY AND DIMENSIONS SHOWN HEREON TAKEN  
FROM A PLAT OF SURVEY PREPARED BY MARK L. MIRITZ DATED  
11/28/2021.

NOTE: COPIES OF THIS MAP TO WHICH THE FOLLOWING CERTIFICATE WILL APPLY SHOW THE SURVEYOR'S ORIGINAL SEAL AND SIGNATURE IN RED INK. COPIES BY ANY OTHER MEANS MAY HAVE ALTERATIONS WHICH DO NOT REPRESENT THE SURVEYOR'S WORK PRODUCT.

I HEREBY CERTIFY THAT THE ABOVE DESCRIBED PROPERTY HAS BEEN SURVEYED UNDER MY DIRECTION AND THAT THE ABOVE MAP IS A TRUE REPRESENTATION THEREOF AND SHOWS THE SIZE AND LOCATION OF THE PROPERTY AND ITS EXTERIOR BOUNDARIES. THIS SURVEY IS MADE FOR THE USE OF THE PRESENT OWNERS OF THE PROPERTY, AND ALSO THOSE WHO PURCHASE, MORTGAGE, OR GUARANTEE THE TITLE THERETO WITHIN ONE YEAR FROM THE DATE HEREOF.

DATED 03-01-23

DATED: 10/17/20  
  
CHRISTOPHER A. HODGES P.L.S. 2760

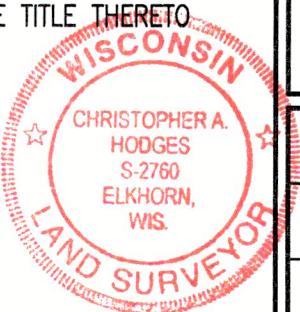

**ANIS, JANSEN & ASSOCIATES, INC.**  
ENGINEERING - ARCHITECTURE - SURVEYING  
7 RIDGEWAY COURT P.O. BOX 437  
ELKHORN, WISCONSIN 53121  
E: (262) 723-2098 e-mail: [office@farrishansen.com](mailto:office@farrishansen.com)

— WORK ORDERED BY —  
MADDOCK CONSTRUCTION COMPANY  
27820 IRMA CIRCLE, SUITE 11  
LAKE FOREST, IL 60045-5132

**AS BUILT**  
N7296 CHAPEL DRIVE  
WHITEWATER, WI 53190

X:\Projects\10831\ACAD\10831.dwg