


MORTGAGE INSPECTION

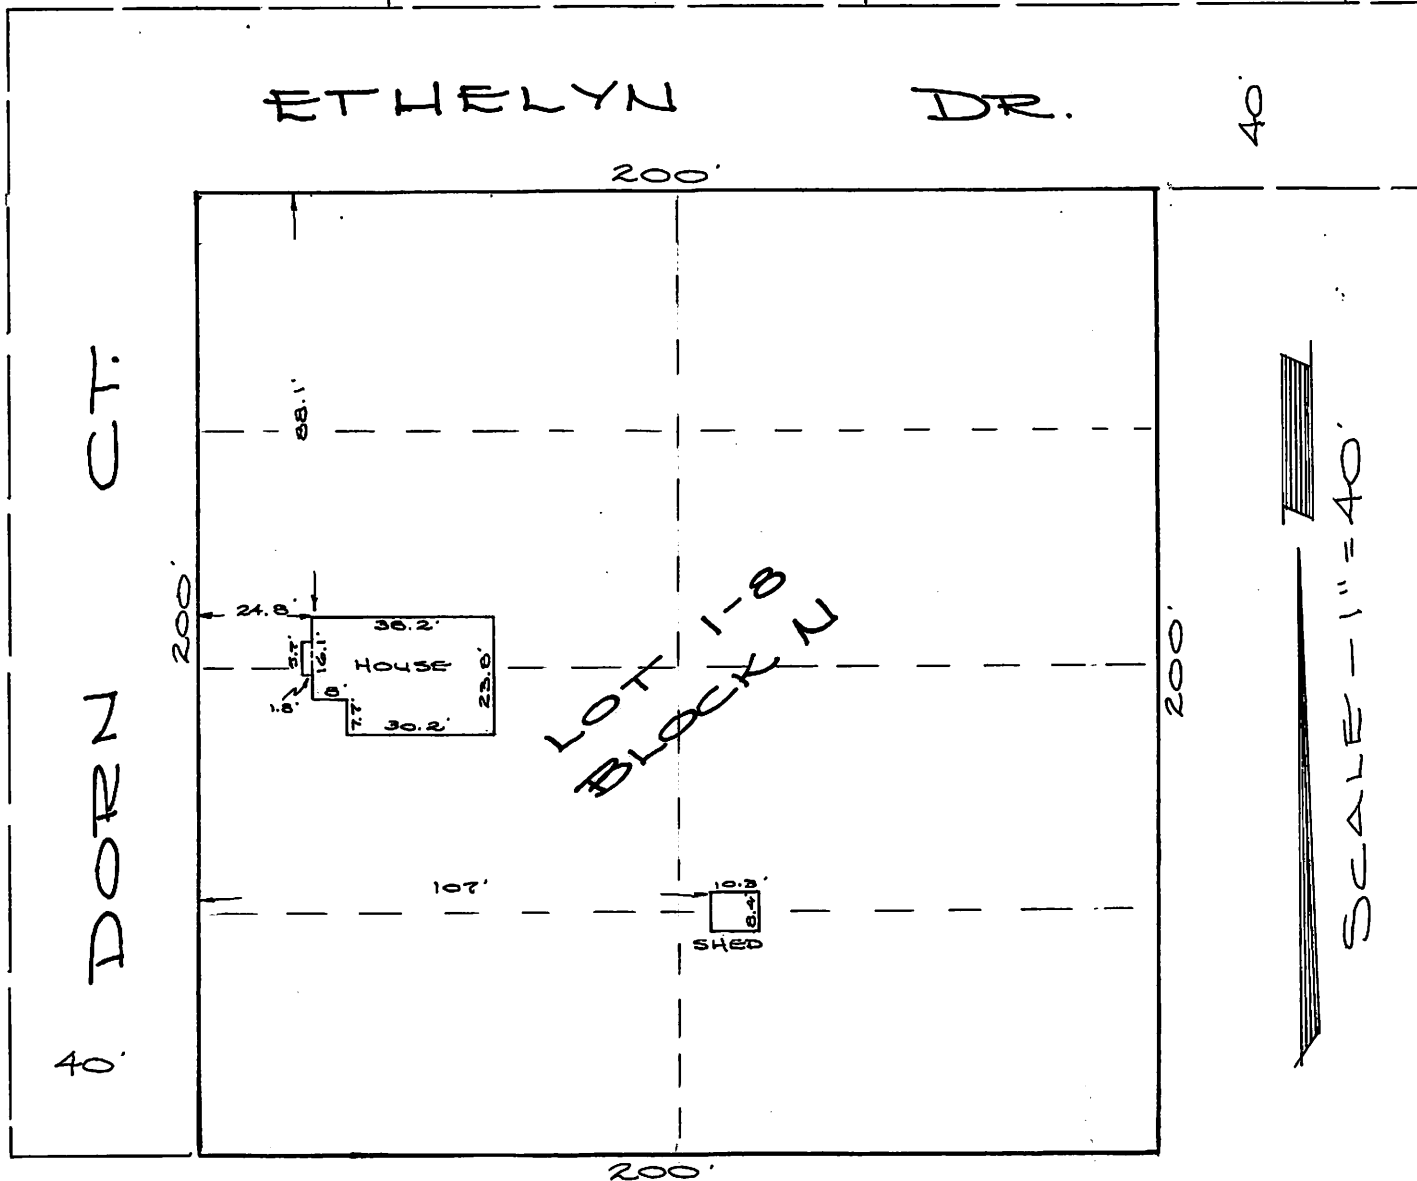

NOTE: Distances and bearings are shown as recorded on the original plat and the information provided by Luchini & Stoll Realty. These dimensions were not necessarily verified in the field and no lot stakes were set in the course of this inspection.

DESCRIPTION

Lots 1-8, Block N, CRYSTAL BOWL SUBDIVISION, in Section 13, T3N, R15E, Town of Richmond, Walworth County, Wisconsin.


CERTIFICATION

I certify that the property described above has been inspected under my responsible direction and supervision and that the above map is a correct representation of the size and location of the property and the location and dimensions of all visible structural improvements, if any.

This inspection is made for the exclusive use of the present owners of the property, and also those who purchase, mortgage, or guarantee the title thereto, and is certified for one year from date hereto.

Date 7-26-79

Prepared for: Luchini & Stoll Realty
Attn: Isabelle Stoll
E. Lake Shore Drive
Whitewater, WI 53190

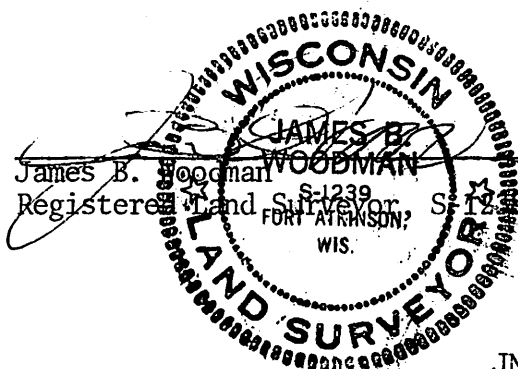

JN 79S-127


STRAND & WOODMAN ASSOCIATES
210 Madison Ave., Fort Atkinson, WI 53538

Land Surveyors & Engineers
Phone (414) 563-8162

315-1493

MAN OF STEEL INSTRUCTION

DOWN

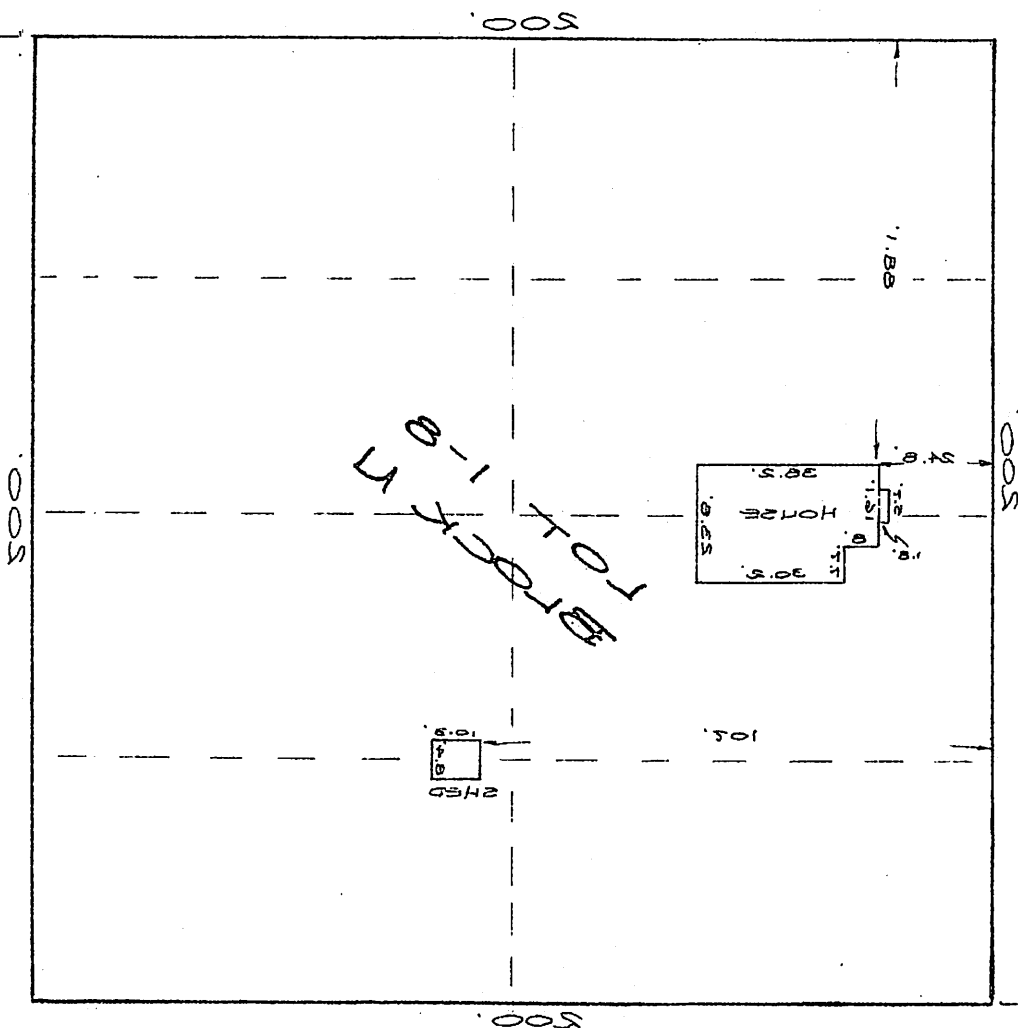

NOTE: Distances and bearings are shown as recorded on the original plat and the information provided by Luchini & Stoll Realty. These dimensions were not necessarily verified in the field and no lot stakes were set in the course of this inspection.

DESCRIPTION

Lots 1-8, Block N, CRYSTAL BOWL SUBDIVISION, in Section 13, T3N, R12E, Town of Richmond, Walworth County, Wisconsin.


NOT AFFICTION

I certify that the property described above has been inspected under my responsible direction and supervision and that the above map is a correct representation of the size and location of the property and the location and dimensions of all visible structural improvements, if any.

certified for one year from date hereto. and also those who purchase, mortgage, or guarantee the title thereto, and is

Date 5-20-52

Whitewater, WI 53190
E. Lake Shore Drive
Attn: Isabelle Stoll
Luchini & Stoll Realty
Prepared for:

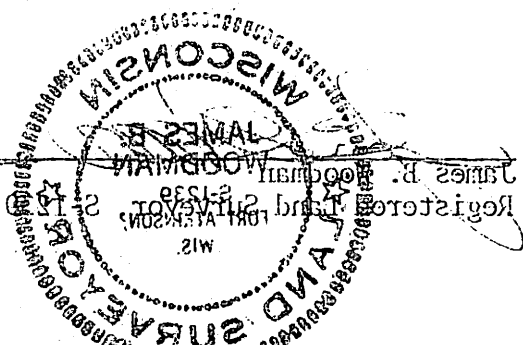

751-207 ML

STRAID & WOODMAN ASSOCIATES
210 Madison Ave., Fort Atkinson, WI 53538
Phone (414) 503-8182
Land Surveyors & Engineers