


PLAT OF SURVEY

BLK 2 LOT 6 SKANSEN FIRST ADDITION
SUBDIVISION LOCATED IN THE SW 1/4 OF SECTION 9,
T2N R1E, WALWORTH COUNTY, WISCONSIN


HEREBY CERTIFY THAT THE ABOVE DESCRIBED PROPERTY HAS BEEN SURVEYED
UNDER MY DIRECTION AND THAT THE PLAT HEREON DRAWN IS A CORRECT RE-
PRESENTATION OF A SURVEY AND CORRECTLY SHOWS THE EXTERIOR BOUNDARIES
AND DIVISIONS AND IMPROVEMENTS OF SAID PROPERTY
DATED THIS 24TH DAY OF AUGUST 1979

EAST LINE
SKANSEN SUBD.
FIRST ADD

Thomas P. Jensen
THOMAS PA JENSEN S 1084
REGISTERED WISCONSIN LAND SURVEYOR
JENSEN SURVEYING & MAPPING
ELKHORN, WISCONSIN

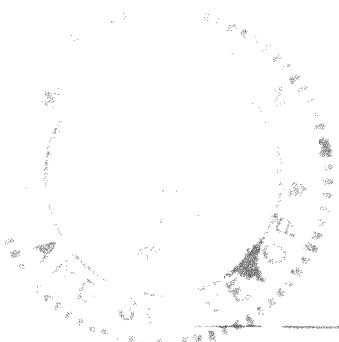

LAKE ROAD 30' WIDE

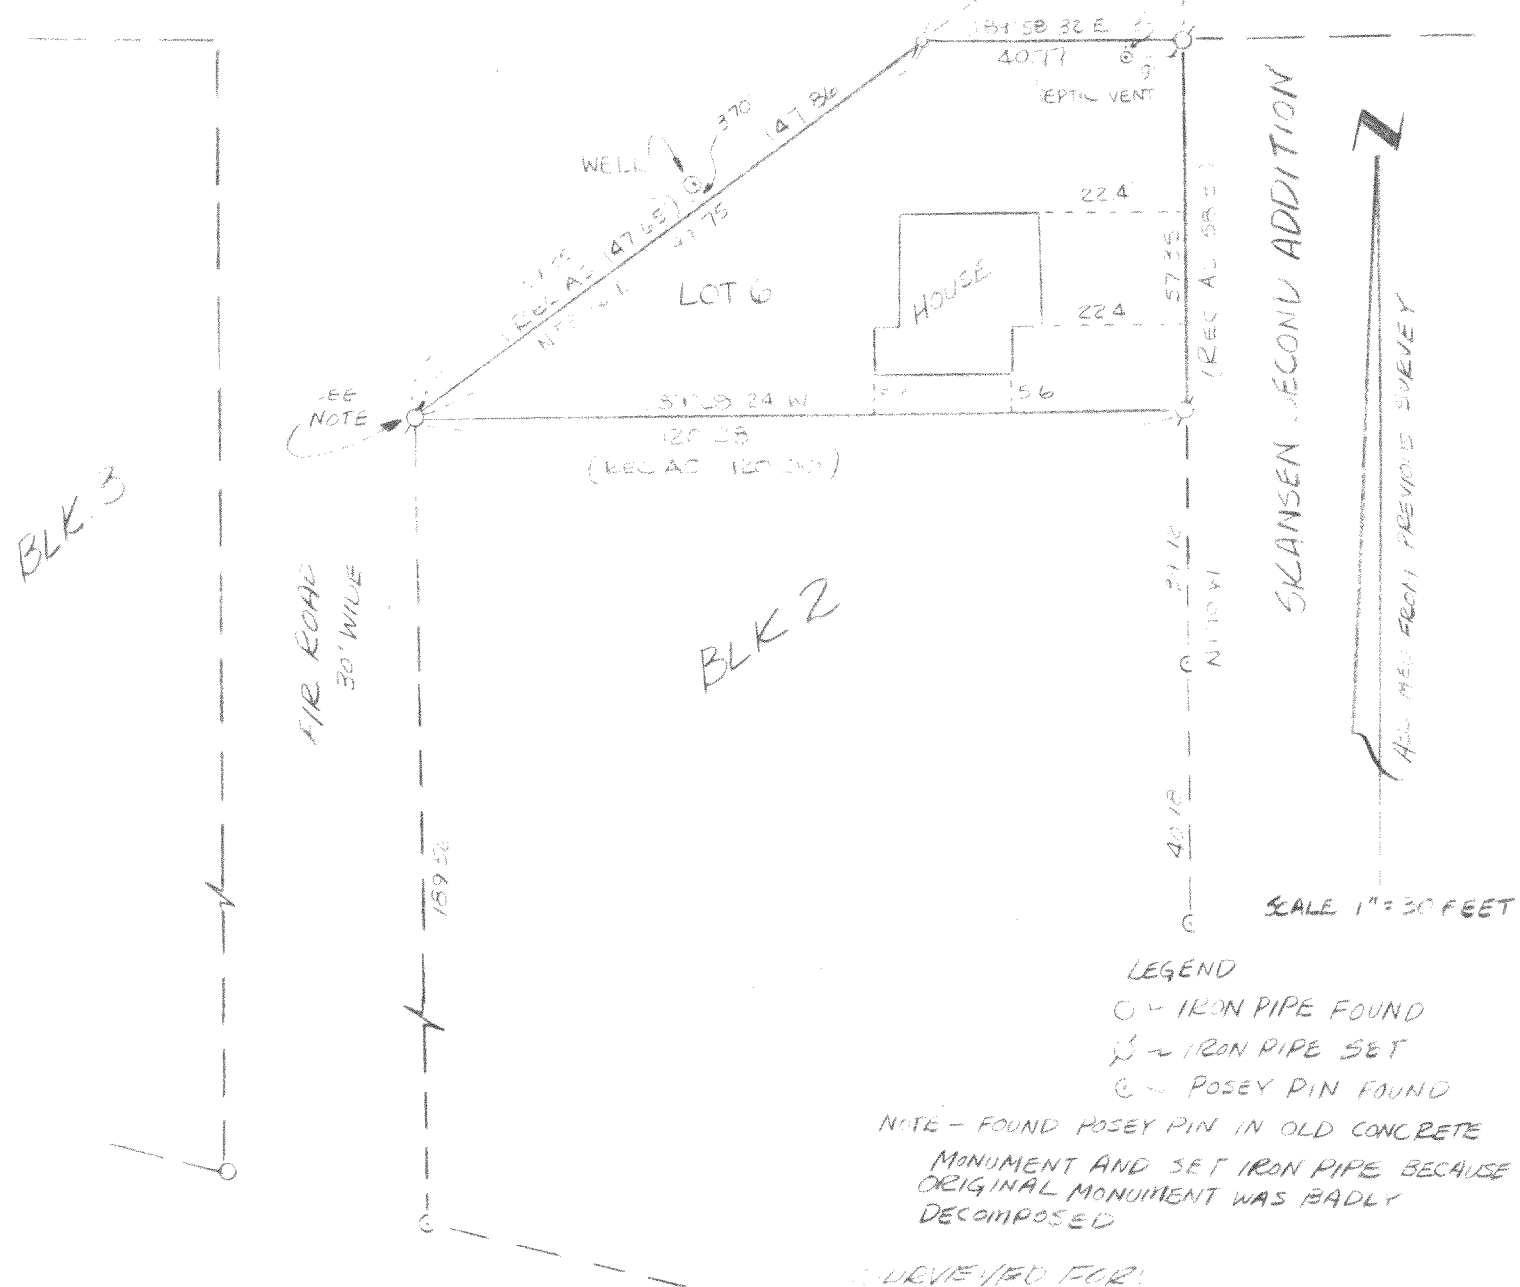

BLK 3

FIR ROAD
30' WIDE

BLK 2

SKANSEN SECOND ADDITION

ALL MEAS FROM PREVIOUS SURVEY

SCALE 1" = 30 FEET

- LEGEND
- - IRON PIPE FOUND
 - ⊙ - IRON PIPE SET
 - ⊙ - POSEY PIN FOUND

NOTE - FOUND POSEY PIN IN OLD CONCRETE
MONUMENT AND SET IRON PIPE BECAUSE
ORIGINAL MONUMENT WAS BADLY
DECOMPOSED

SURVEYED FOR:
RON MACK
241 BOX 300
DELEVAN, WIS
53115