


PLAT OF SURVEY

OF LOTS 22 THROUGH 25, BLOCK 14, SKANSENS SWEDISH TRIBUNE NEWS SUBDIVISION, BEING PART OF THE SE 1/4 OF THE SW 1/4 OF SECTION 9, T. 3 N., R. 15 E., OF THE 4TH P.M., TOWN OF RICHMOND, WALWORTH COUNTY, WISCONSIN.

SURVEY NOTES

- 1. SURVEYED PROPERTY SUBJECT TO ANY AND ALL EASEMENTS AND AGREEMENTS RECORDED AND UNRECORDED.
- 2. THIS SURVEY IS A RETRACEMENT OF A SURVEY BY ABELL SURVEYING & MAPPING DATED AUGUST 26, 1992 AS JOB NUMBER 92192.

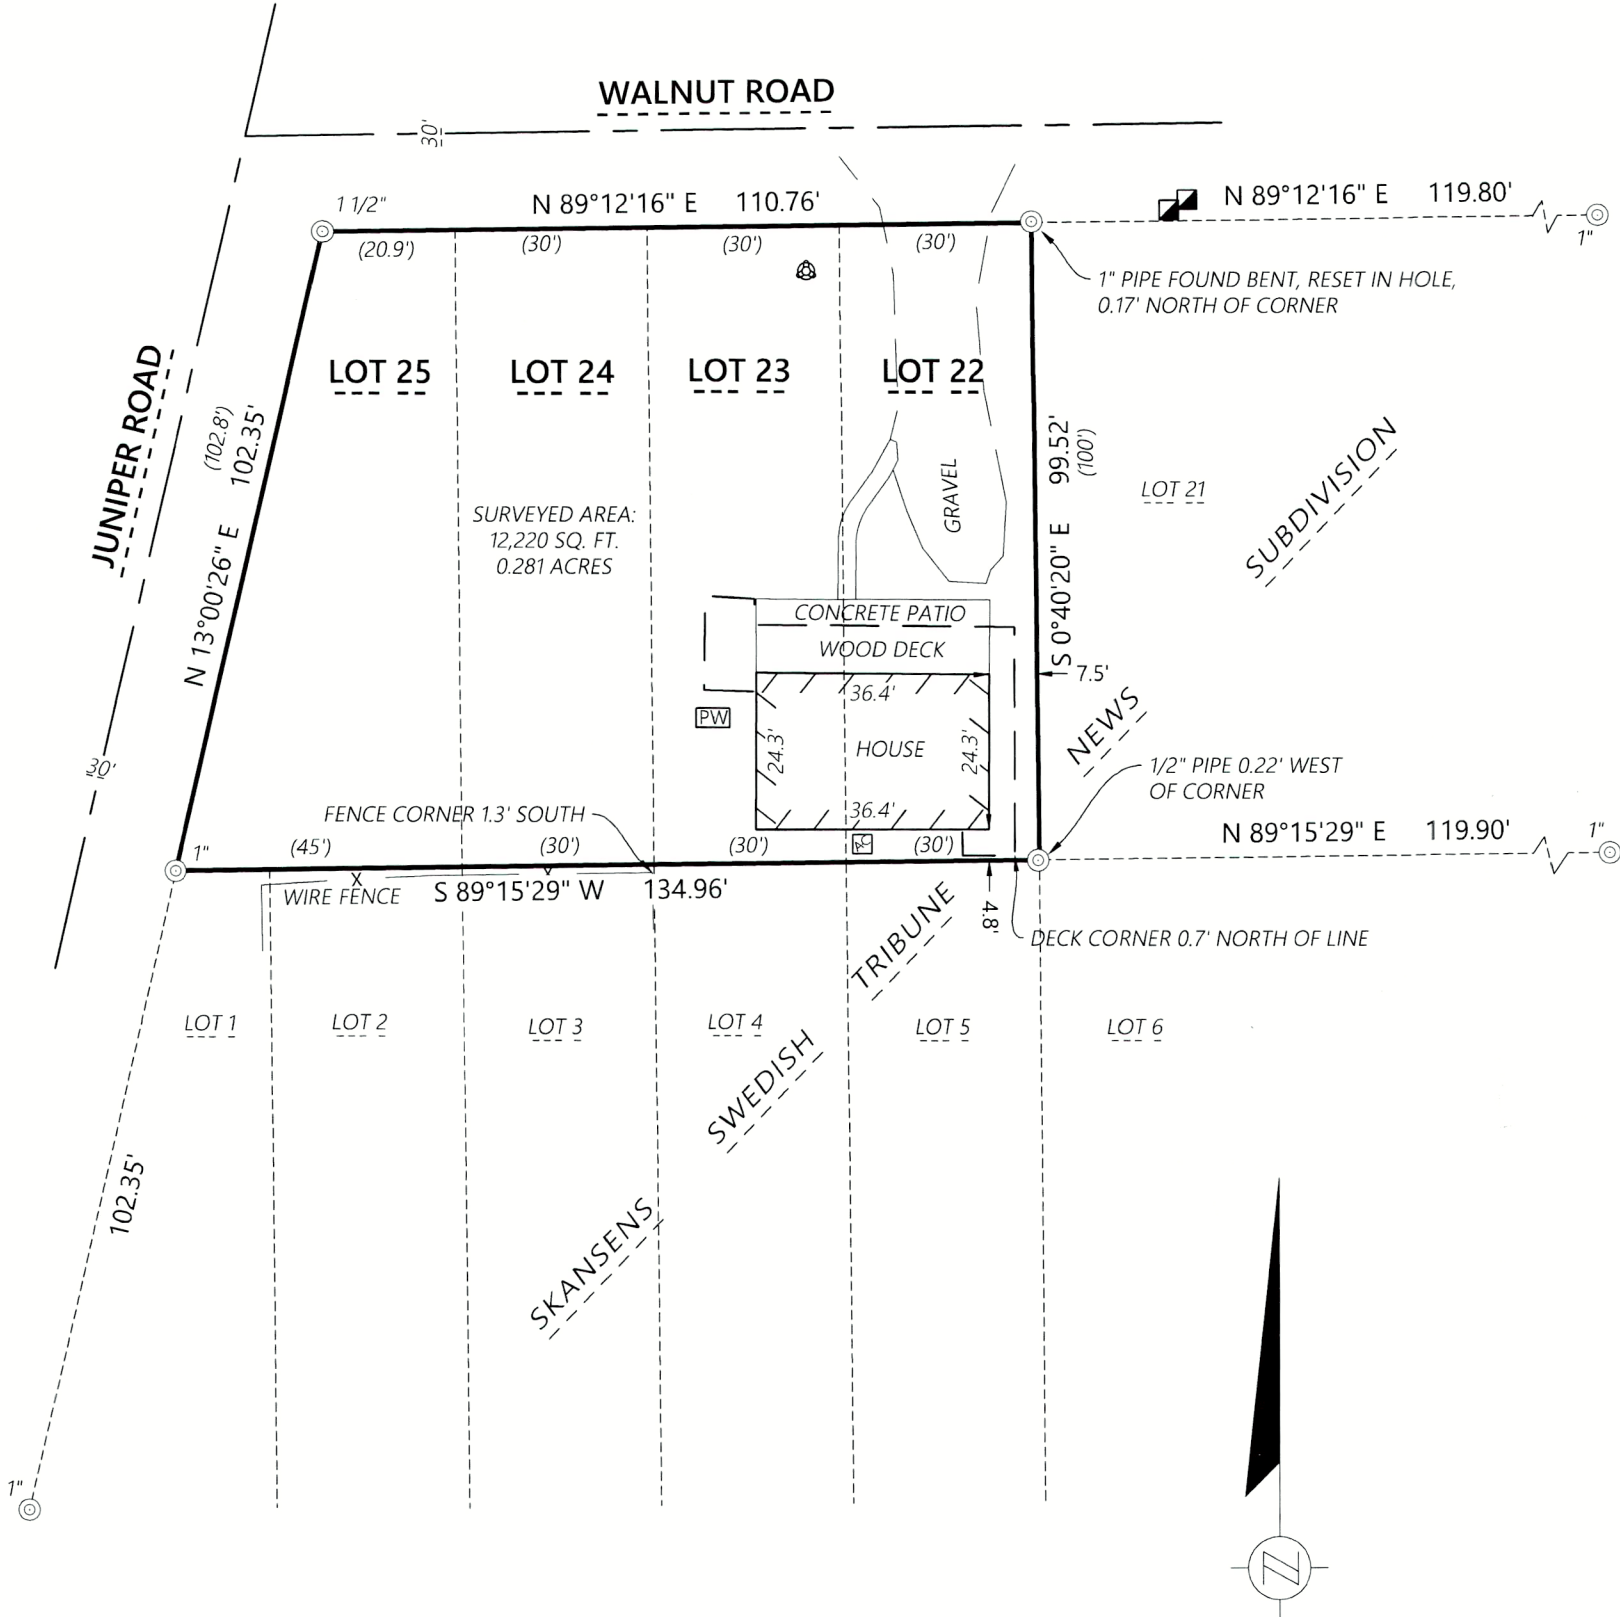

Kristin J Belongia

Kristin J. Belongia, P.L.S.
Wisconsin Professional Land Surveyor S-2943

State of Wisconsin } ss
County of Walworth }

I hereby certify that I have supervised the survey of the property described above and to the best my knowledge and belief, the plat drawn hereon complies with Chapter A-E 7 of the State of Wisconsin Administrative Code, Minimum Standards for Property Surveys and correctly represents said survey and its location.
Given under my hand and seal at Elkhorn, Wisconsin this 2nd day of July, 2026.
Last day of field work June 15th, 2026.

If the surveyor's signature is not red in color, the plan is a copy that should be assumed to contain unauthorized alterations.
The certification contained on this document shall not apply to any copies.

Scale: 1" = 30'
0 15 30 60
DISTANCE UNITS BASED ON THE UNITED STATES SURVEY FOOT
BEARINGS BASED ON THE WISCONSIN COORDINATE REFERENCE SYSTEM, WALWORTH ZONE. THE SOUTH LINE OF WALNUT ROAD BEARING N 89°12'16" E

LEGEND

- ⊙ Iron Pipe Found
- X — Existing Fence
- ▣ Existing Telephone Pedestal
- PW Existing Well
- ⊗ Existing Septic Vent
- (XXX.XX) Record Information

ORDER NO: 35949

FIELD CREW: AK
DRAWN BY: AK
SHEET 1 OF 1

FOR THE EXCLUSIVE USE OF:

Sue Elyn Jacobs
W8771 Walnut Road
Delavan, WI 53115

PLAT OF SURVEY

Batterman

engineers surveyors planners
BELOIT | ELKHORN | JANESVILLE
2857 S. Bartells Dr., Beloit, WI 53511
608.365.4464 | www.rhbatterman.com

