


PLAT OF SURVEY

BLOCK 14, LOTS 22, 23, 24, AND 25, SKANSEN'S SUBDIVISION SOUTH PART

SUBDIVISION LOCATED IN THE S.W. 1/4 OF SECTION 9
T3N, R15E, WALWORTH COUNTY, WISCONSIN

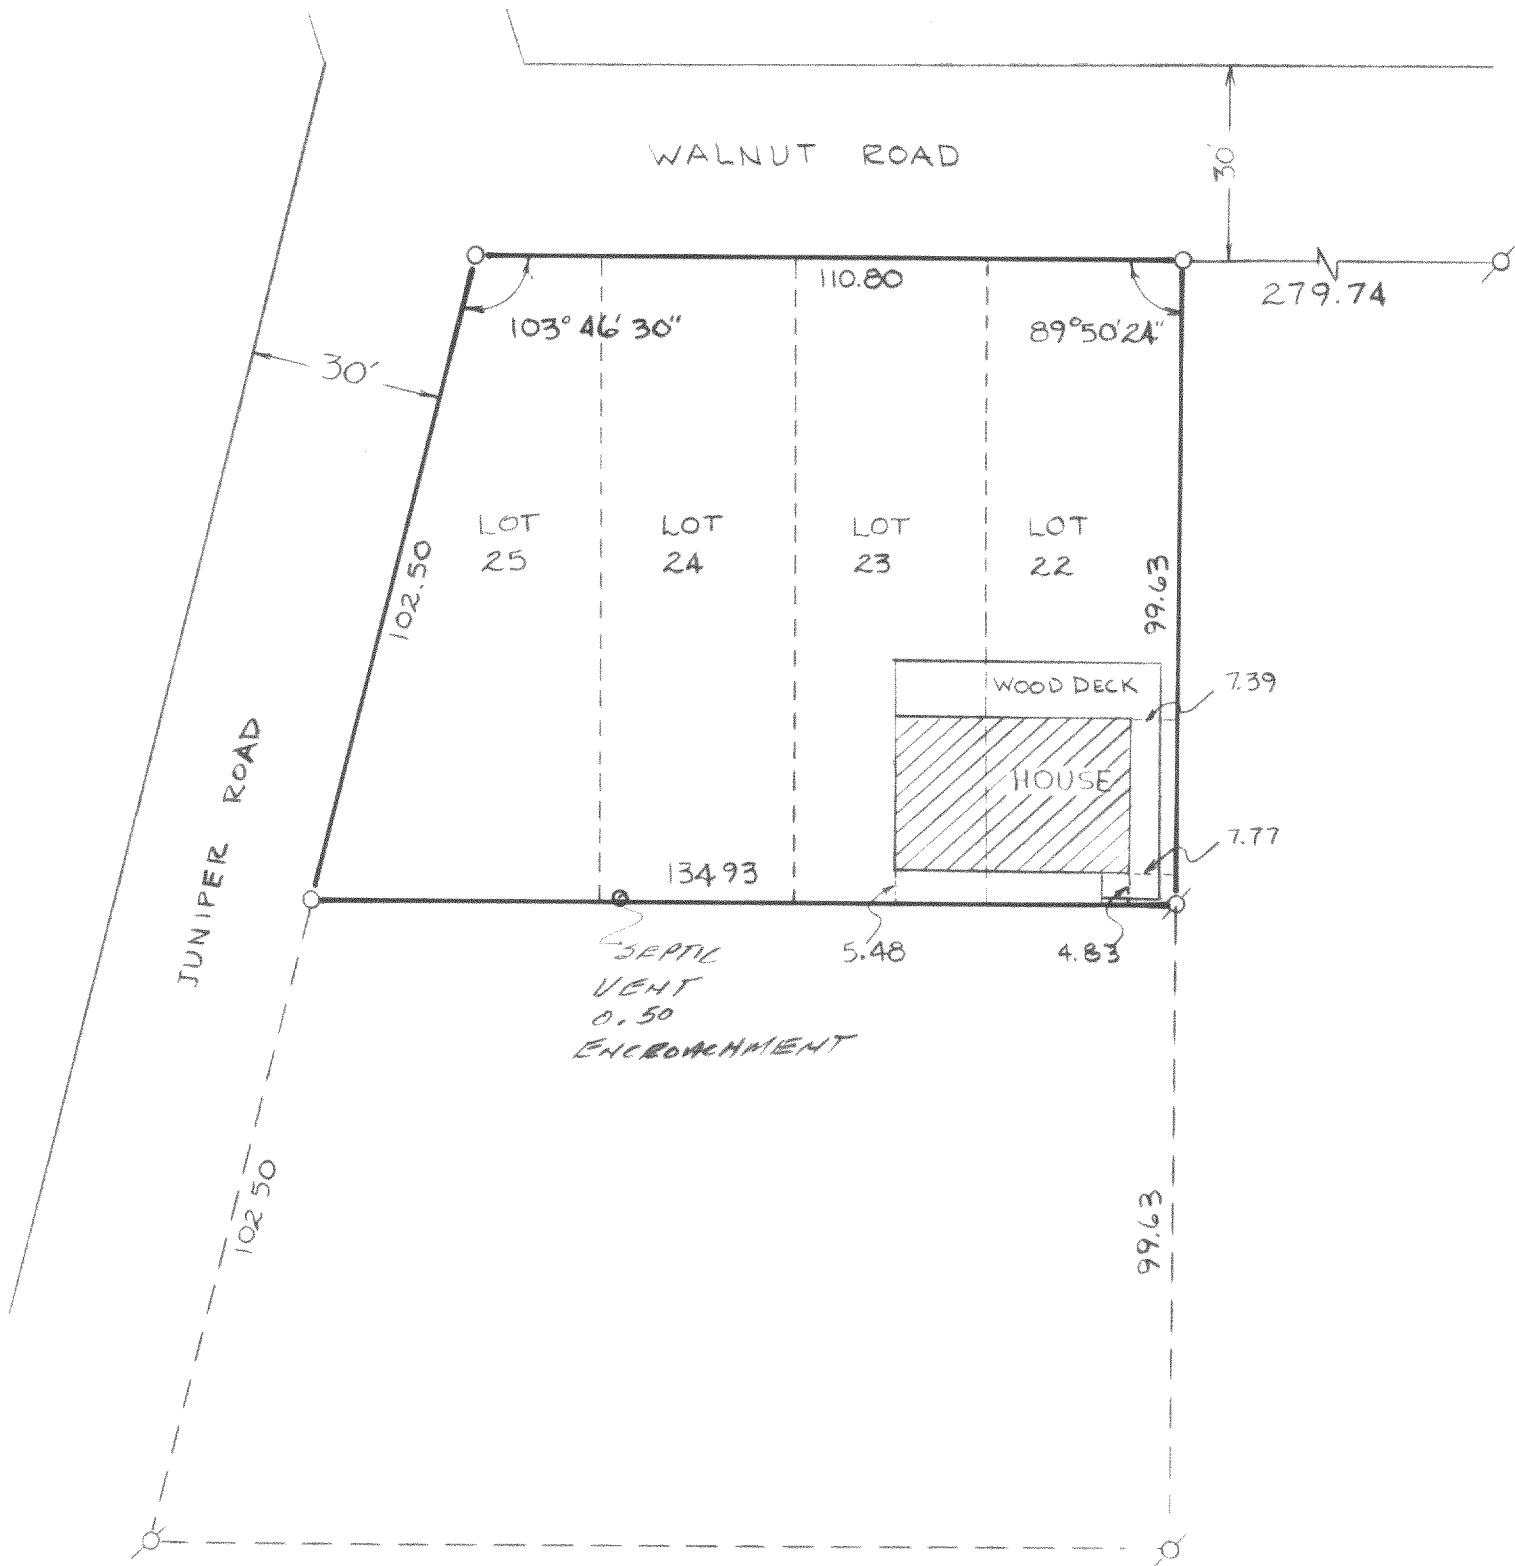

JENSEN SURVEYING & MAPPING S.C.

P.O. BOX 322

ELKHORN WIS. 53121-0322 (414) 723-3434

SURVEYED BY: THOMAS P.A. JENSEN RLS-1084

DRAFTED BY: R.L. MEADOWS

SURVEYED FOR: STAN HARE

RT#2 BOX 133

ELKHORN, WISC. 53121

N
ASSUMED NORTH

SCALE 1"=30'

LEGEND

- IRON PIPE FOUND
- IRON PIPE PLACED

I HEREBY CERTIFY THAT THE ABOVE DESCRIBED PROPERTY
HAS BEEN SURVEYED UNDER MY DIRECTION AND THAT THE PLAT
HEREON DRAWN IS A CORRECT REPRESENTATION OF SAID SURVEY,
AND CORRECTLY SHOWS THE EXTERIOR BOUNDARIES AND DIVISIONS
AND THE HOUSE THEREON.

