


DUNHAM SURVEYING, S. C.  
SURVEYING & SUBDIVIDING  
DELAVER, WISCONSIN 53115

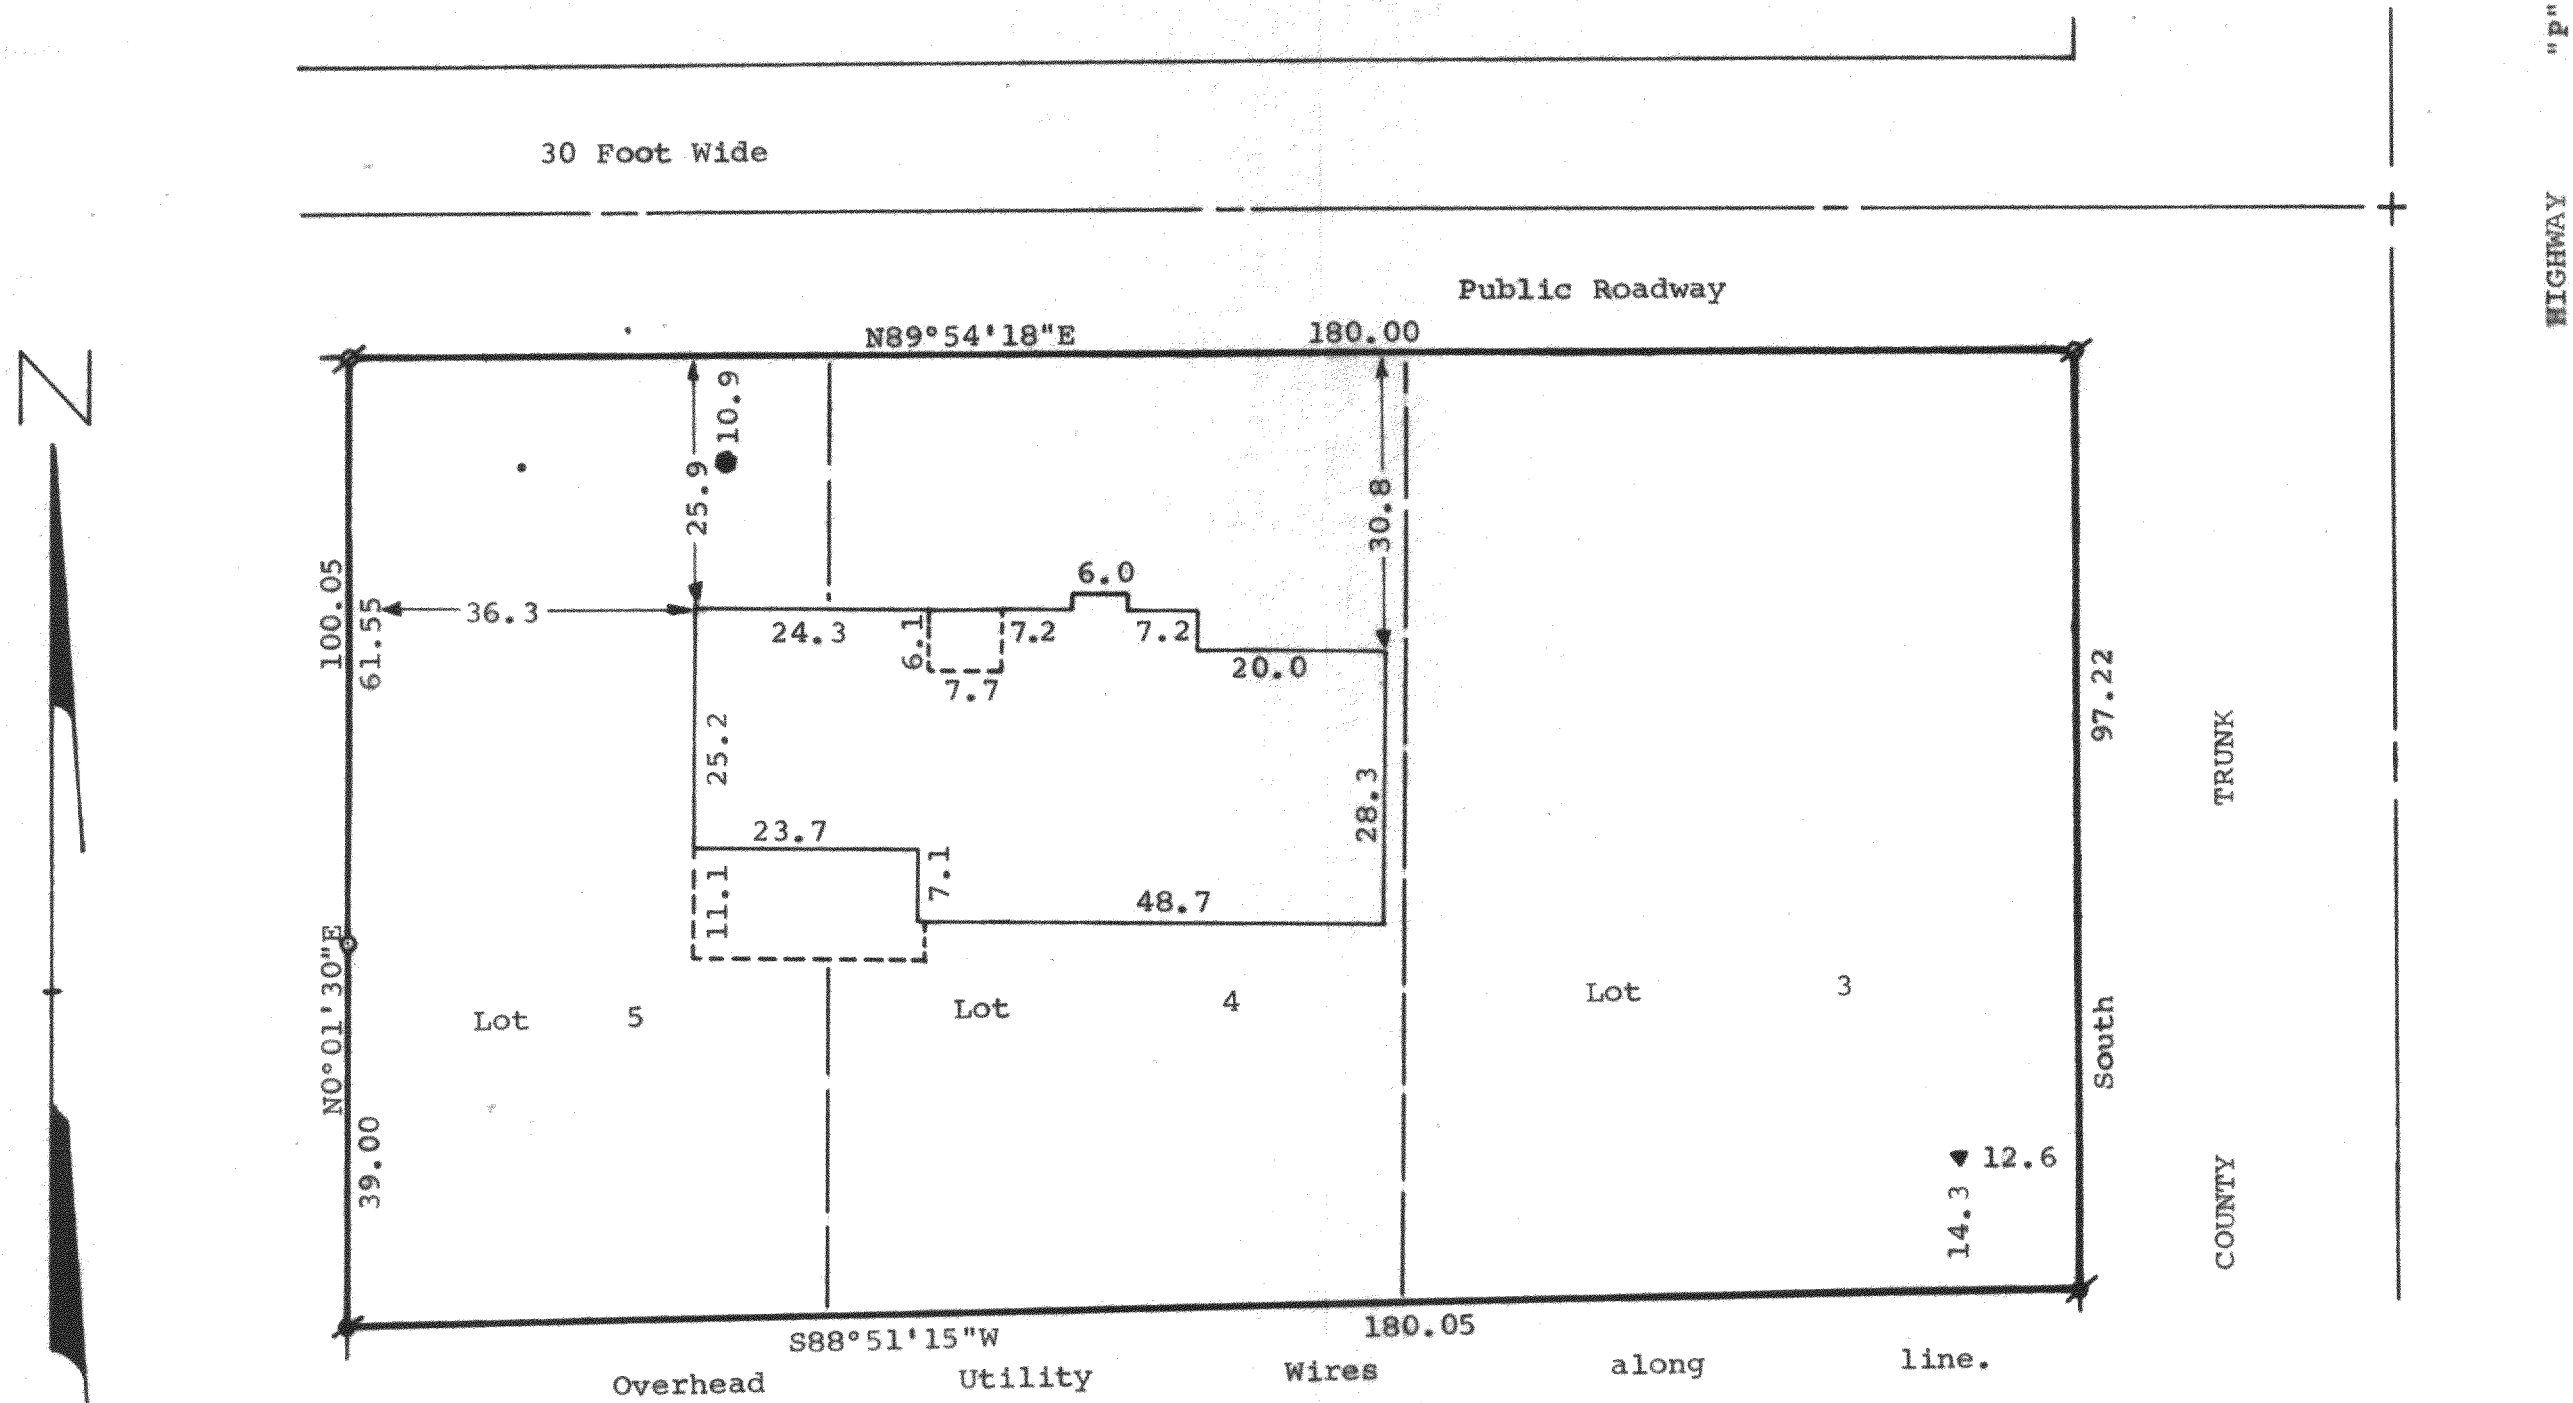

Scale - 1" = 20'

⊘ = 1" Dia. Iron Pipe Found  
⊘ = 3/4" Dia. Iron Pipe Found  
⊘ = 3/4"x24" Iron Pipe Set  
● = Well  
▲ = Vent Pipe

Owner: Jerry Mulick  
3051 Crestwood Lane  
Glenview, Illinois 60025

Note: Bearings are referenced to  
the West line of County Trunk  
Highway "P", assumed bearing  
of North-South.

STATE OF WISCONSIN) SS  
COUNTY OF WALWORTH)

I, George T. Dunham, Surveyor, certify that I have surveyed  
the property described as follows,

Lots 3, 4, and 5 in Block "A" of Crystal Bowl, a subdivision  
located in Sections 12 and 13, all in T3N, R15E, Walworth  
County, Wisconsin,

and that the above map is a true representation thereof and shows the  
size and location of the property, its exterior boundaries, the location  
of all visible structures and dimensions of all principal buildings  
thereon, boundary fences, apparent easements, roadways and visible  
encroachments, if any.

This survey is made for the use of the present owners of the property,  
and also those who purchase, mortgage, or guarantee the title thereto  
within one (1) year from date hereof.

July 16, 1982.

*George T. Dunham*  
George T. Dunham, Surveyor

