


DUNHAM SURVEYING, S.C.

SURVEYING & SUBDIVIDING
DELAVER, WISCONSIN 53115

TERRITORIAL

ROAD

N

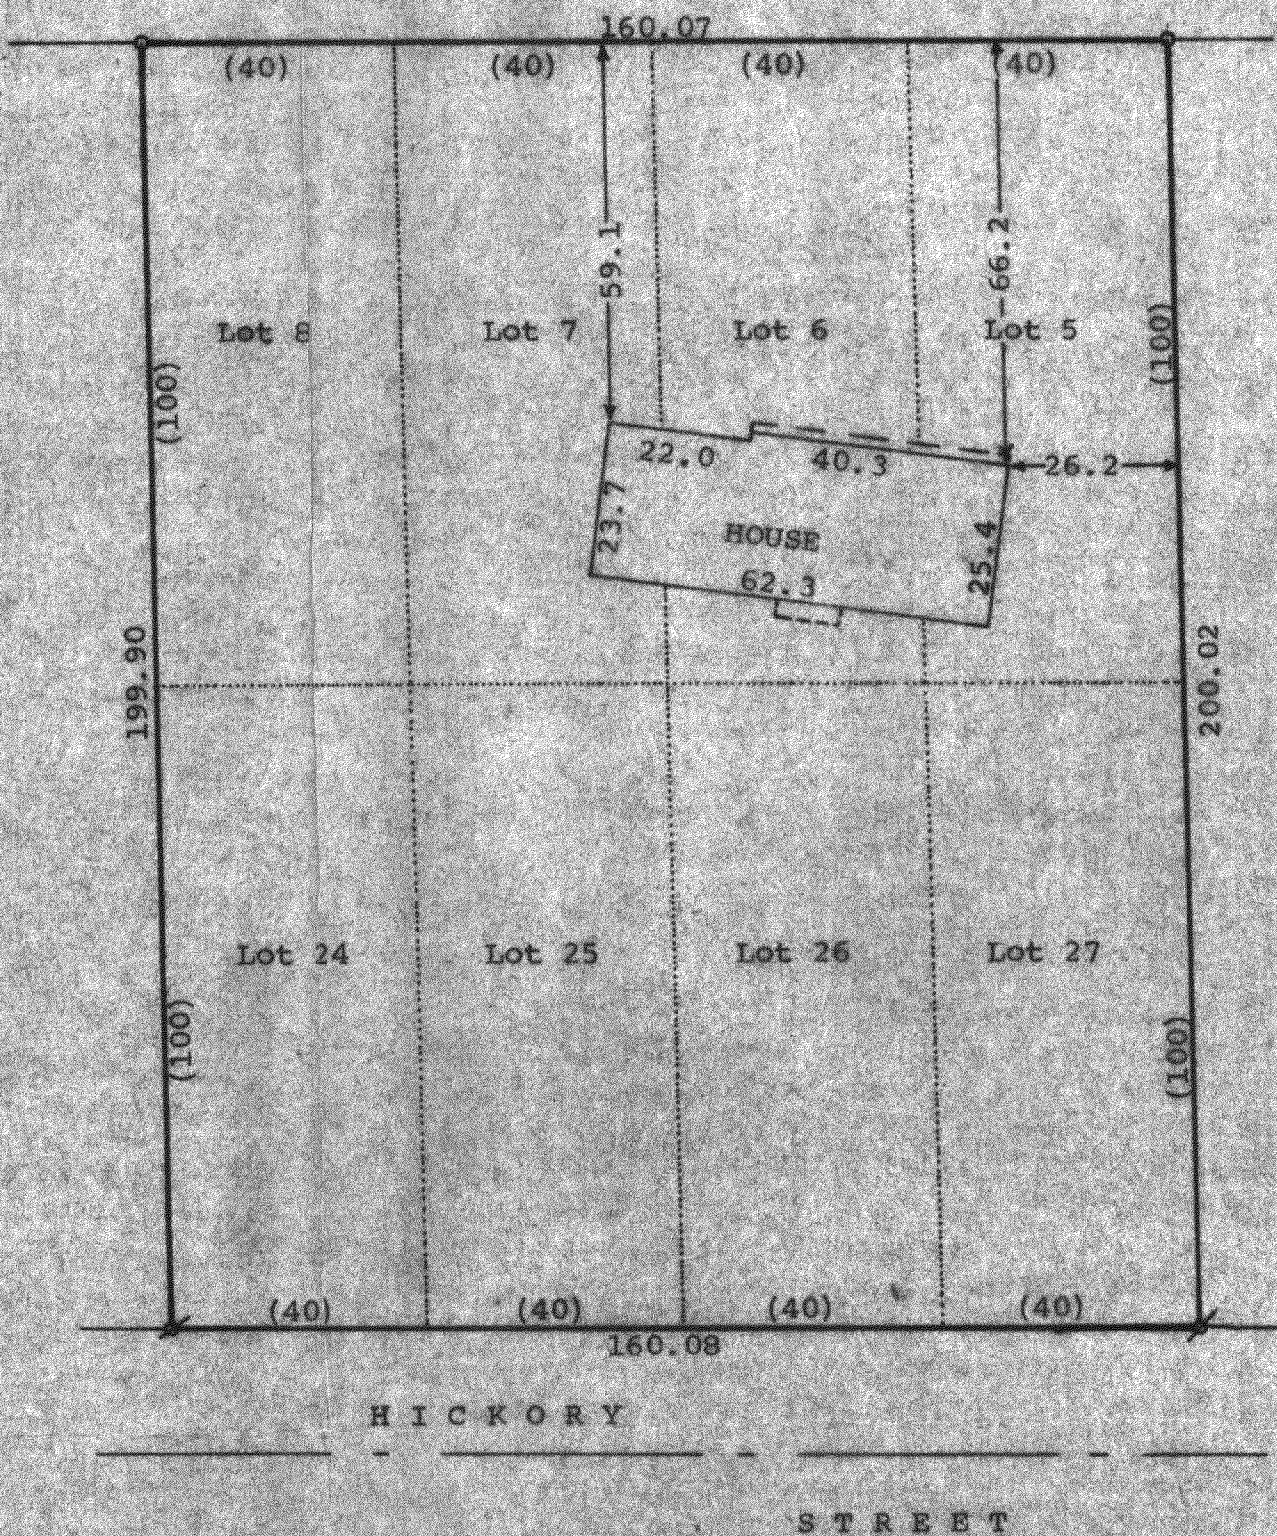

Scale - 1" = 30'
o = Iron Pipe Set
p = Posey Pin Found
Iron Pipe Set
(0.00) = Recorded Distance

STATE OF WISCONSIN
COUNTY OF WALWORTH^{SS}

I, James M. Dunham, Surveyor, certify that I have surveyed the property described as follows,
Lots 5, 6, 7, 8, 24, 25, 26 and 27, in Block 12 of Forest Beach Subdivision, a subdivision of a part of the Northwest 1/4 of Section 9, T 3 N, R 15 E, Walworth County, Wisconsin, subject to utility easements of record.

and that the above map is a true representation thereof and shows the size and location of the property, its exterior boundaries, the location of all visible structures and dimensions of all principal buildings thereon, boundary fences, apparent easements, roadways and visible encroachments, if any.

This survey is made for the use of the present owners of the property, and also those who purchase, mortgage, or guarantee the title thereto within one (1) year from date hereof.
January 26, 1981

James M. Dunham
James M. Dunham, Surveyor

