


JENSEN SURVEYING & MAPPING
P.O. BOX 322
ELKHORN, WI. 53121



- SCALE: 1" = 20'
- FOUND SET BY G. ROSEY-1928
 - FOUND CONC. MON. SET BY G. ROSEY-1928
 - SET IRON ROD
 - IRON ROD FOUND

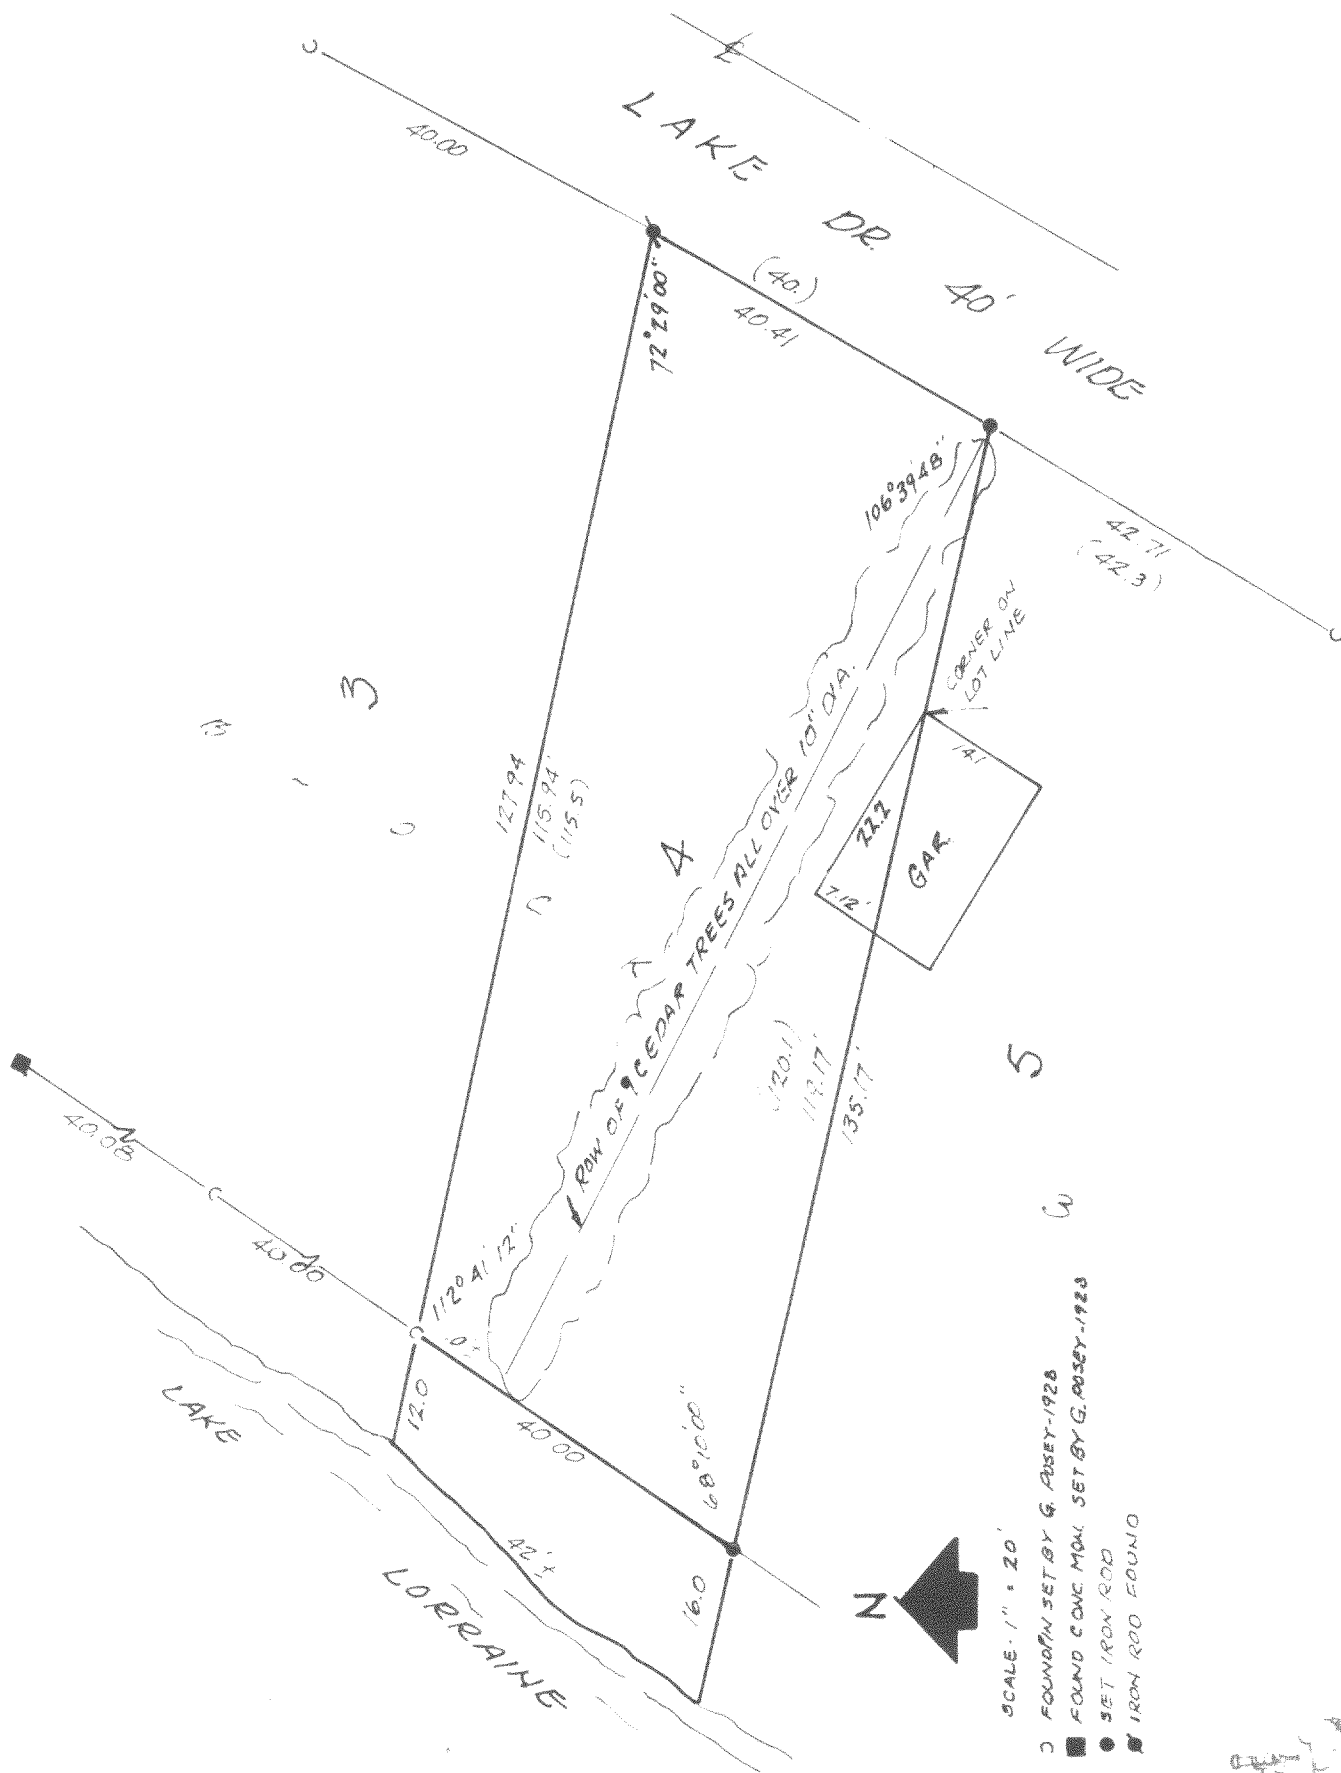

SURVEYED FOR: L. ROAMS
2184 ROMAN CT.
SCHOMBURG, IL. 60194

PLAT OF SURVEY OF
LOT 4, BLOCK 3, FORREST BEACH SUB.
LOCATED IN THE N.W. 1/4 SECTION 9, T3N, R15E,
WALWORTH COUNTY, WISCONSIN.

I HEREBY CERTIFY THAT I HAVE SURVEYED THE ABOVE DESCRIBED
PROPERTY AND THAT THE PLAT SHOWN HEREON IS AN ACCURATE
SURVEY AND CORRECTLY SHOWS THE EXTERIOR BOUNDARY LINES ON SAID
PROPERTY AND THE CORRECT MEASUREMENTS THEREOF AND
BUILDINGS THEREON.

THOMAS P.A. JENSEN, R.L.S. 1084

DATE: July 12, 1983