




**ROBERS & BOYD, INC.**  
CONSULTING ENGINEERS  
LAND SURVEYORS

109 SOUTH SPRING STREET  
BURLINGTON, WISCONSIN 53105  
PHONE: 414-763-7834

PLAT OF SURVEY  
FOR  
UNIVERSAL MORTGAGE CORPORATION  
OF

Lots 14 through 22, Block 13,  
SKANSEN SWEDISH TRIBUNE-NEWS  
SUBDIVISION, Town of Richmond,  
Walworth County, Wisconsin.

OWNER: Mark Rossiter  
Route 1, Box 264-A  
Delavan, WI

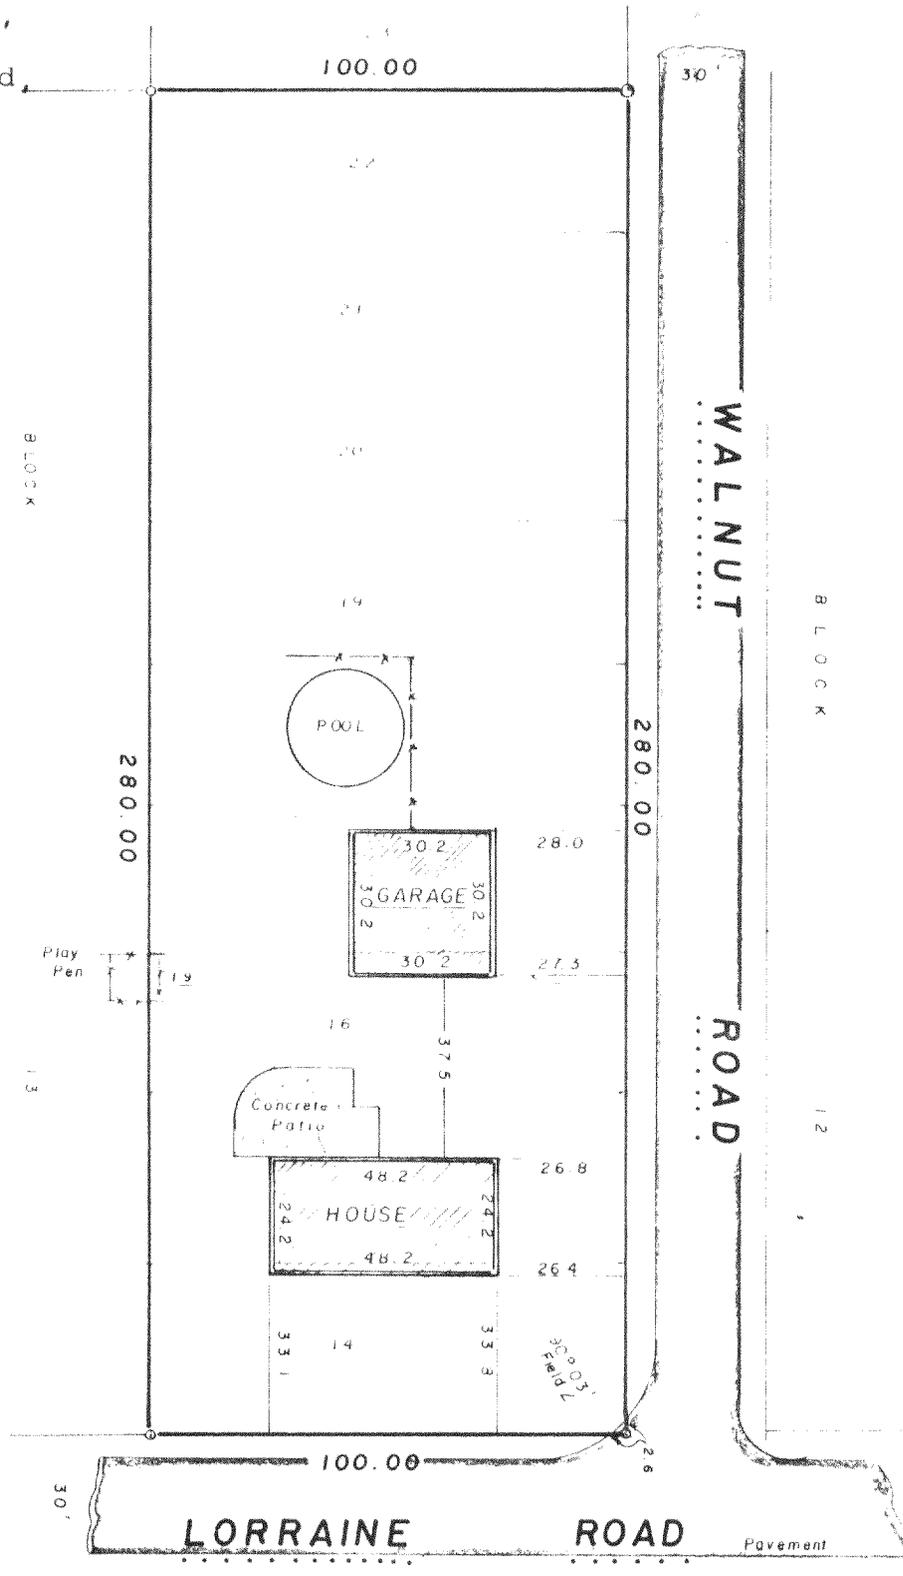

"I hereby certify that I have surveyed the above described property and that the above map is a true representation thereof and shows the size and location of the property, its exterior boundaries, the location of all visible structures and dimensions of all principal buildings thereon, boundary fences, apparent easements, roadways and visible encroachments, if any.

"This survey is made for the use of the present owners of the property, and also those who purchase, mortgage, or guarantee the title thereto within one year from date hereof."

NO MONUMENTATION HAS BEEN WAIVED IN ACCORDANCE WITH A-E 5.01(b) OF THE WISCONSIN ADMINISTRATIVE CODE



*[Handwritten signature]*

- LEGEND**
- + CHISEL CUT IN CONCRETE
  - o PK NAIL
  - FOUND IRON PIPE -
  - ⊙ FOUND IRON PIPE -
  - SET IRON PIPE - 1"
  - FOUND BRASS CAPPED MONUMENT
  - ⊕ FOUND CONCRETE MONUMENT
  - FENCE
  - ( ) RECORDED AS
  - EXISTING GROUND ELEVATION

SCALE - 1" = 40'

*[Handwritten signature: Kenneth R. Reesman]*  
WISCONSIN REGISTERED LAND SURVEYOR

8-25-83  
DATE

FIELD WORK BY KRR/DWL

DRAWN BY KRR

83228  
JOB NUMBER

K & E CS-216, 217

315-198