


KOLB LAND CONSULTING, INC.
LAND SURVEYING • SUBDIVIDING • LAND PLANNING

LAKE GENEVA, WISCONSIN 53147

WHITEWATER, WISCONSIN 53190

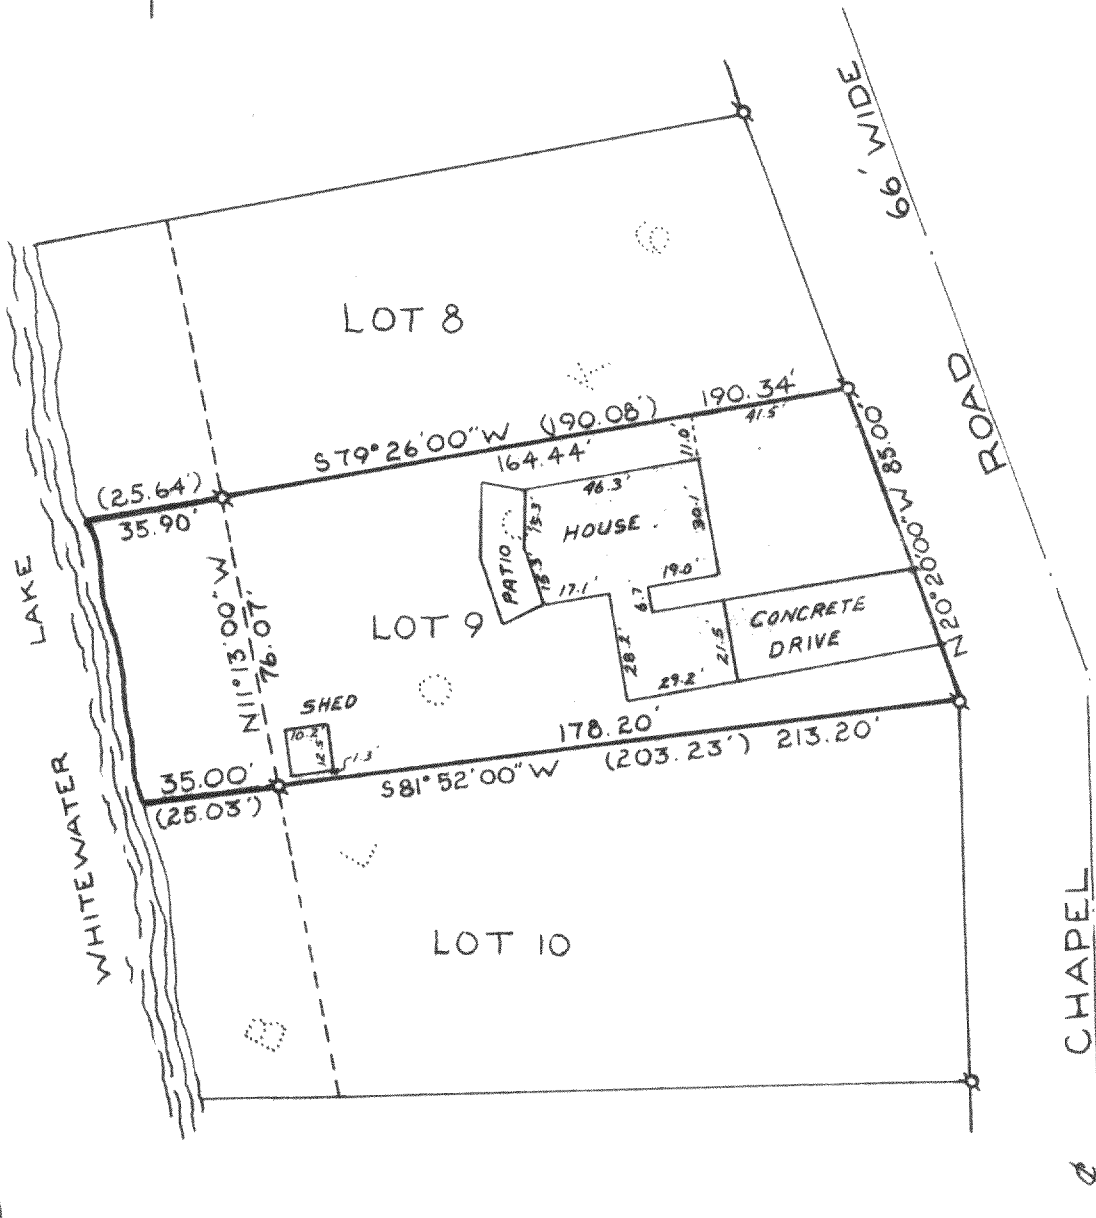

PLAN OF LOT 9

Lot 9, Block 6, Subdivision of the
 Section 1, T1N, R10E, S10W, 1/4 Sec. 36,
 13S, R10E, W1/2 Sec. 36, 1/4 Sec. 36.

Map of Block 6, Subdivision of the

Map of Block 6, Subdivision of the
 Section 1, T1N, R10E, S10W, 1/4 Sec. 36,
 13S, R10E, W1/2 Sec. 36, 1/4 Sec. 36.


REVISED AUG. 25, 1983

Harold H. Kolb
 HAROLD H. KOLB
 WISCONSIN SURVEYOR, S-187

SCALE: 1"=50'

LEGEND

X - IRON PIPE FOUND
 O - AS PLATTED

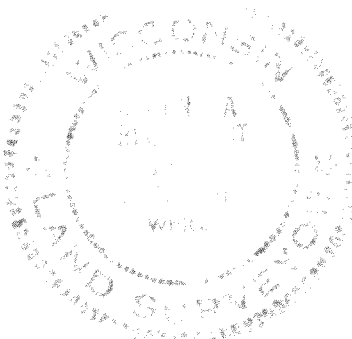

I, *Harold H. Kolb*, do hereby certify
 that I have surveyed the land shown on
 described according to the official records
 and that the plat hereon is a true and
 correct copy of the original.

WISCONSIN REGISTERED LAND SURVEYOR, S-1279

DATE *June 1, 1979*

315-200

3-15-12

CCH--00014A