


PLAT OF SURVEY

OF Lots 13 and 14 and the Easterly 1/2 of Lot 15 of Richmond Heights, a subdivision located in the NE 1/4 of the SE 1/4, the NW 1/4 of the SE 1/4 and the SW 1/4 of the SE 1/4 of Section 3, T3N, R15E, Walworth County, Wisconsin.

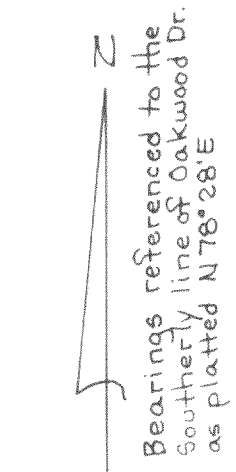

Scale: 1"=30'

Area in Survey:
0.7 Acres

Surveyed For:

Dan McMann
2621 Diamond Ct.
Woodridge, IL 60517
Phone: (312) 971-2269


Surveyed by:

JENSEN SURVEYING & MAPPING, S.C.
P.O. Box 322
Elkhorn, WI. 53121
Phone: (414) 723-3434


Mapping date: May 1, 1984

LEGEND:

- = Found 1 1/2" dia. Iron Pipe
- = Set 3/4" dia. Iron Rod

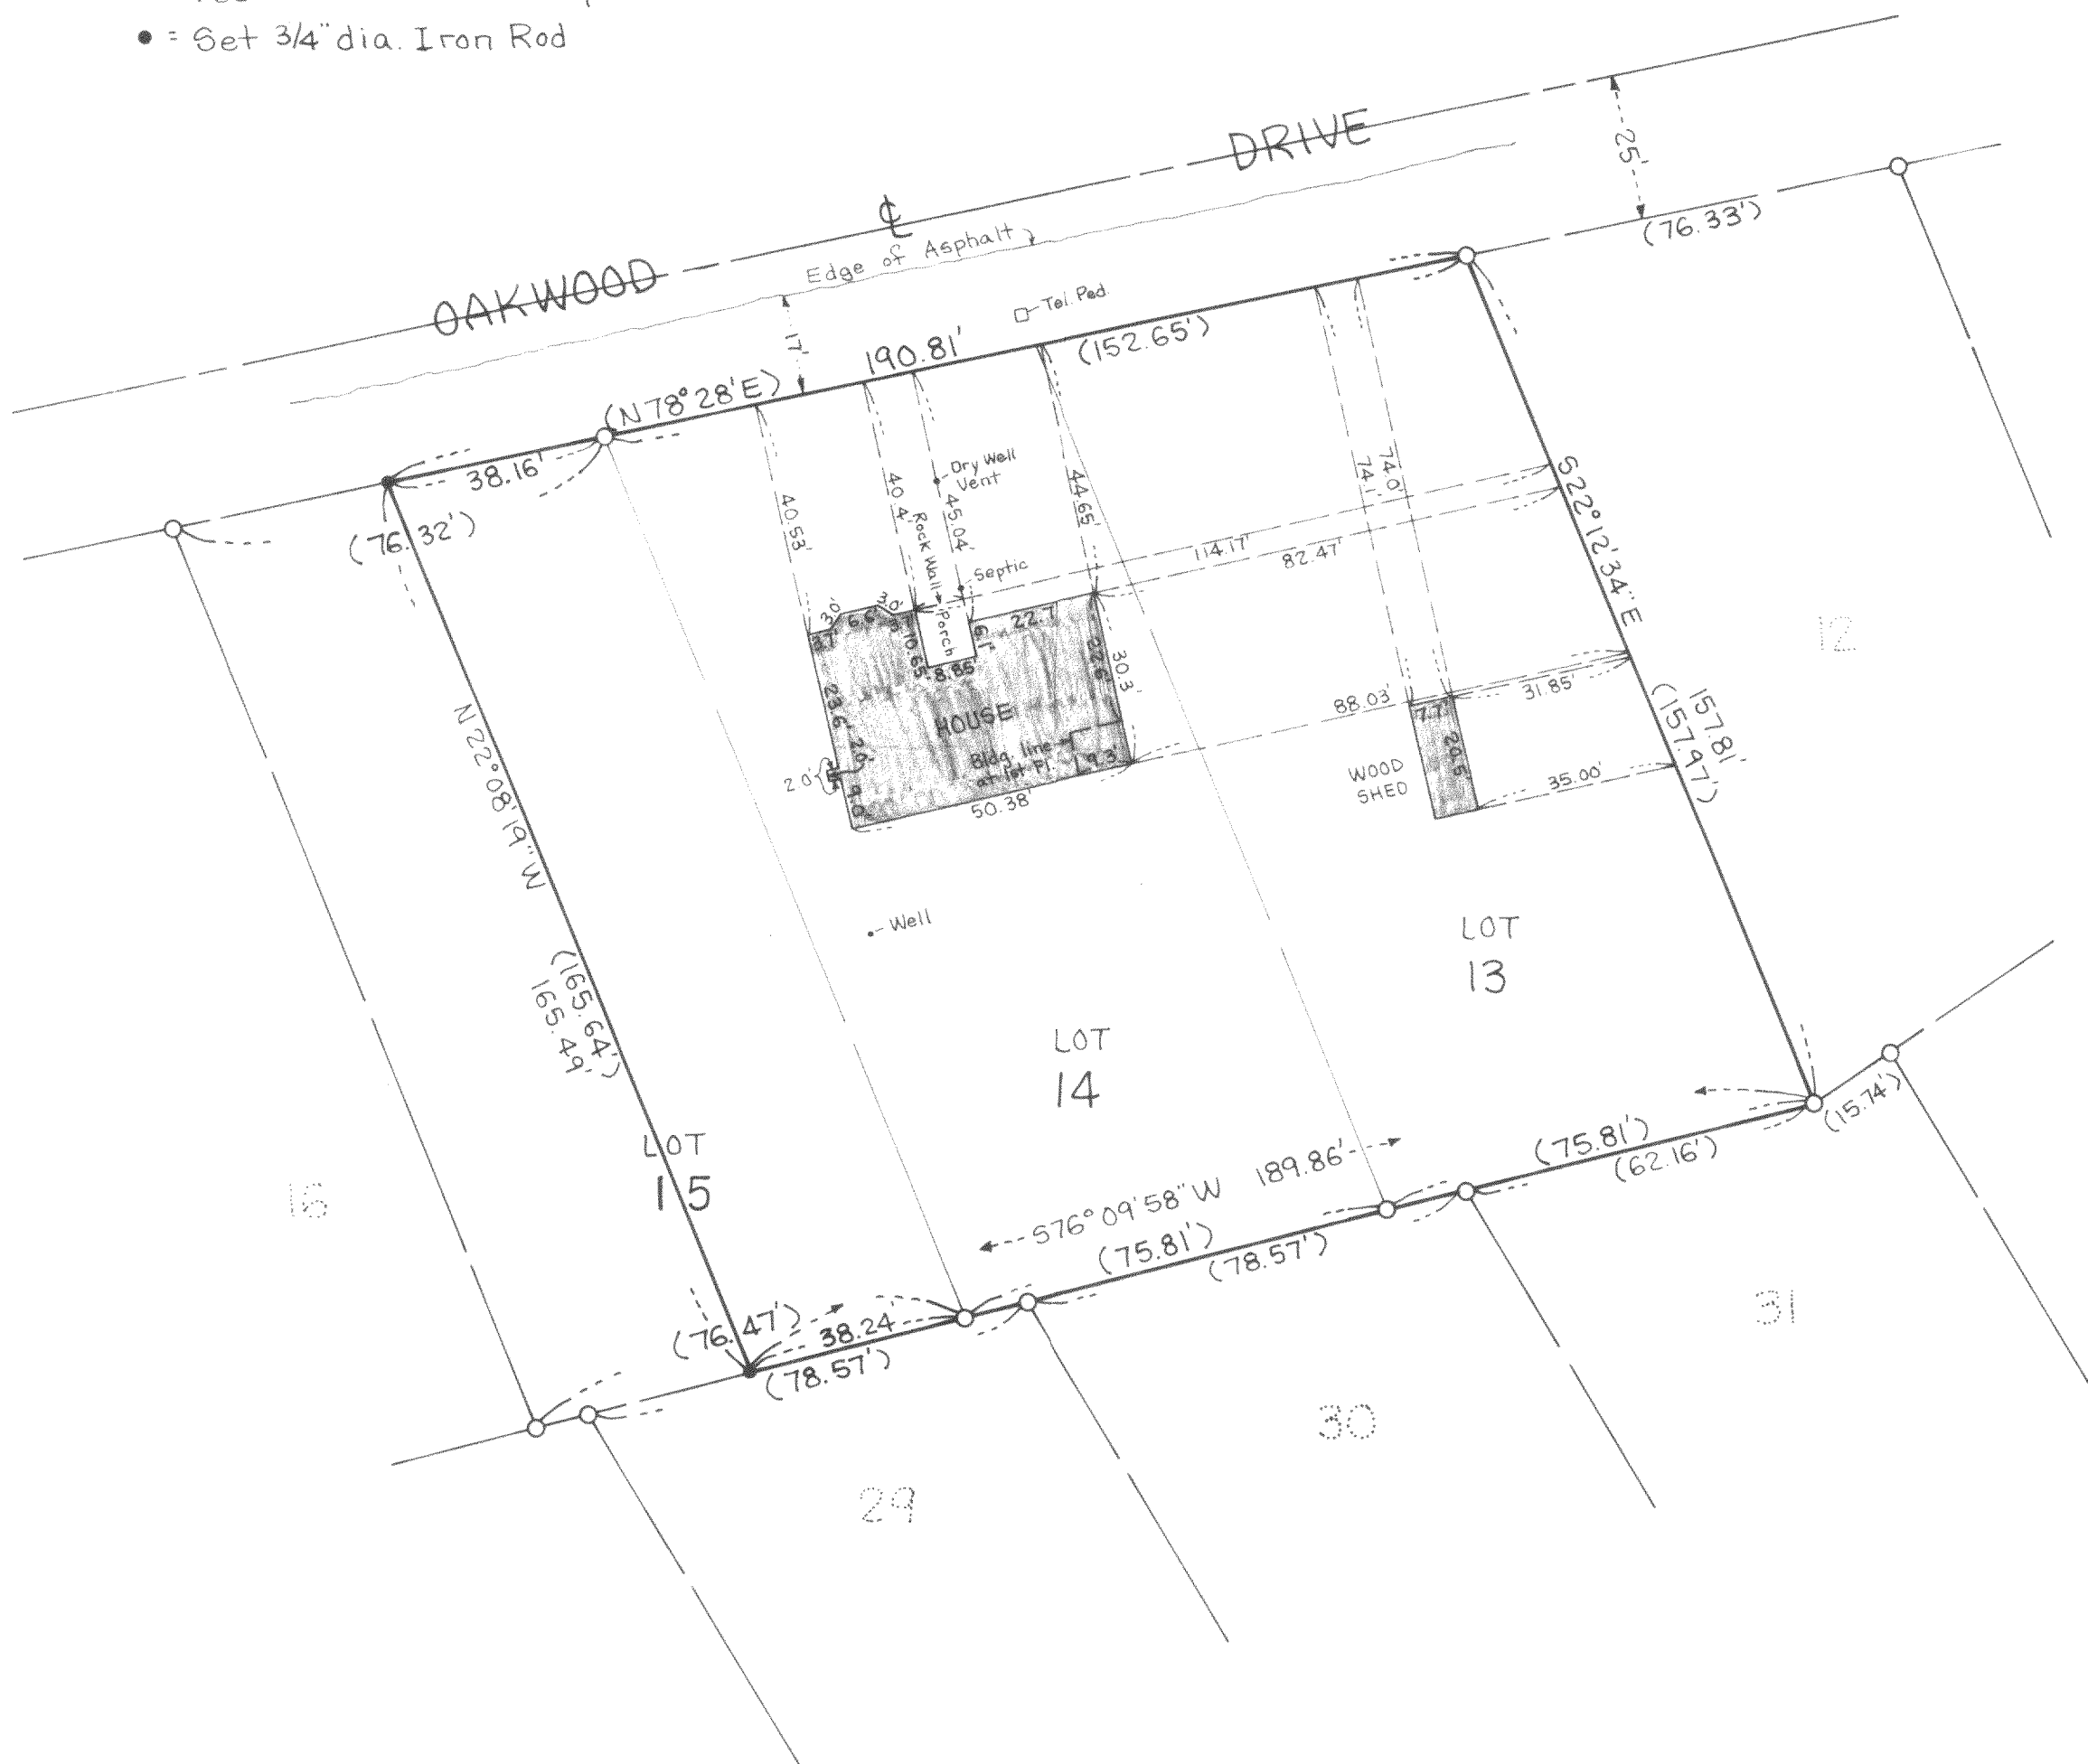

I hereby certify that the above described property has been surveyed under my direction, that the plat shown hereon is an accurate survey, a true representation thereof, correctly shows the exterior boundary lines on said property and the correct measurements thereof and buildings thereon.

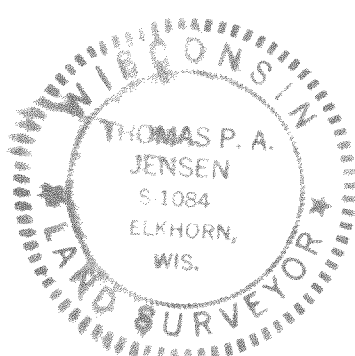

Thomas P.A. Jensen
THOMAS P.A. JENSEN R.L.S. NO. 1084

