

FARRIS HANSEN & ASSOCIATES, INC.
ELKHORN, WISCONSIN

PLAT OF SURVEY OF
LOT 4 OF BLOCK 5 OF CHAPEL HILLS SUBDIVISION
LOCATED IN THE NORTHEAST 1/4 OF SECTION 3, TOWN 3 NORTH,
RANGE 15 EAST, RICHMOND TOWNSHIP, WALWORTH COUNTY, WISCONSIN

⊙ = 2" dia. iron pipe stake found

⊘ = 1.25" dia. iron pipe stake found

○ = "x24" iron pipe set

MAP SCALE
1" = 40'

(xxx) = RECORD DIMENSION

LOT 2

LOT 3

5

BLOCK

LP GAS TANK
FOR RESIDENCE ON
LOT 3 ENCROACHES
ON LOT 4

(N 15° 20' 14" E)
N 15° 04' 14" E

96.32 (96.00)

(15.15)

N 29° 51' E

193.74 (N 29° 35' E 193.10')

WHITEWATER LAKE

FIRST AVENUE
(50' WIDE)
UNIMPROVED

N 59° 04' E
Bearing Basis for this Plat

138.35 (138.30')


LOT 4

95.80 (95.81')
N 00° 00' E (NORTH)

I hereby certify that at the direction
of Ronald Wiemerslage I have surveyed
the above described lands and that this
Plat of Survey is a true and accurate
representation of the boundary lines to
the best of my professional knowledge
and belief.

Dated this 3rd day of December, 1984

Robert A. Farris

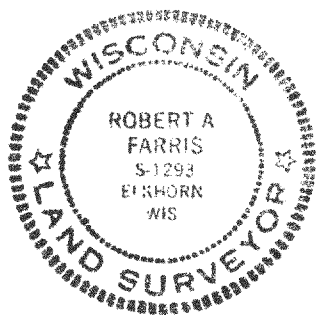

PROJ. # 2340

315-203