


ABELL
SURVEYING & MAPPING
DELAVAL, WISCONSIN 53115



ORDERED BY: CENTURY 21
312 S. 7th STREET
DELAVAL, WI 53115

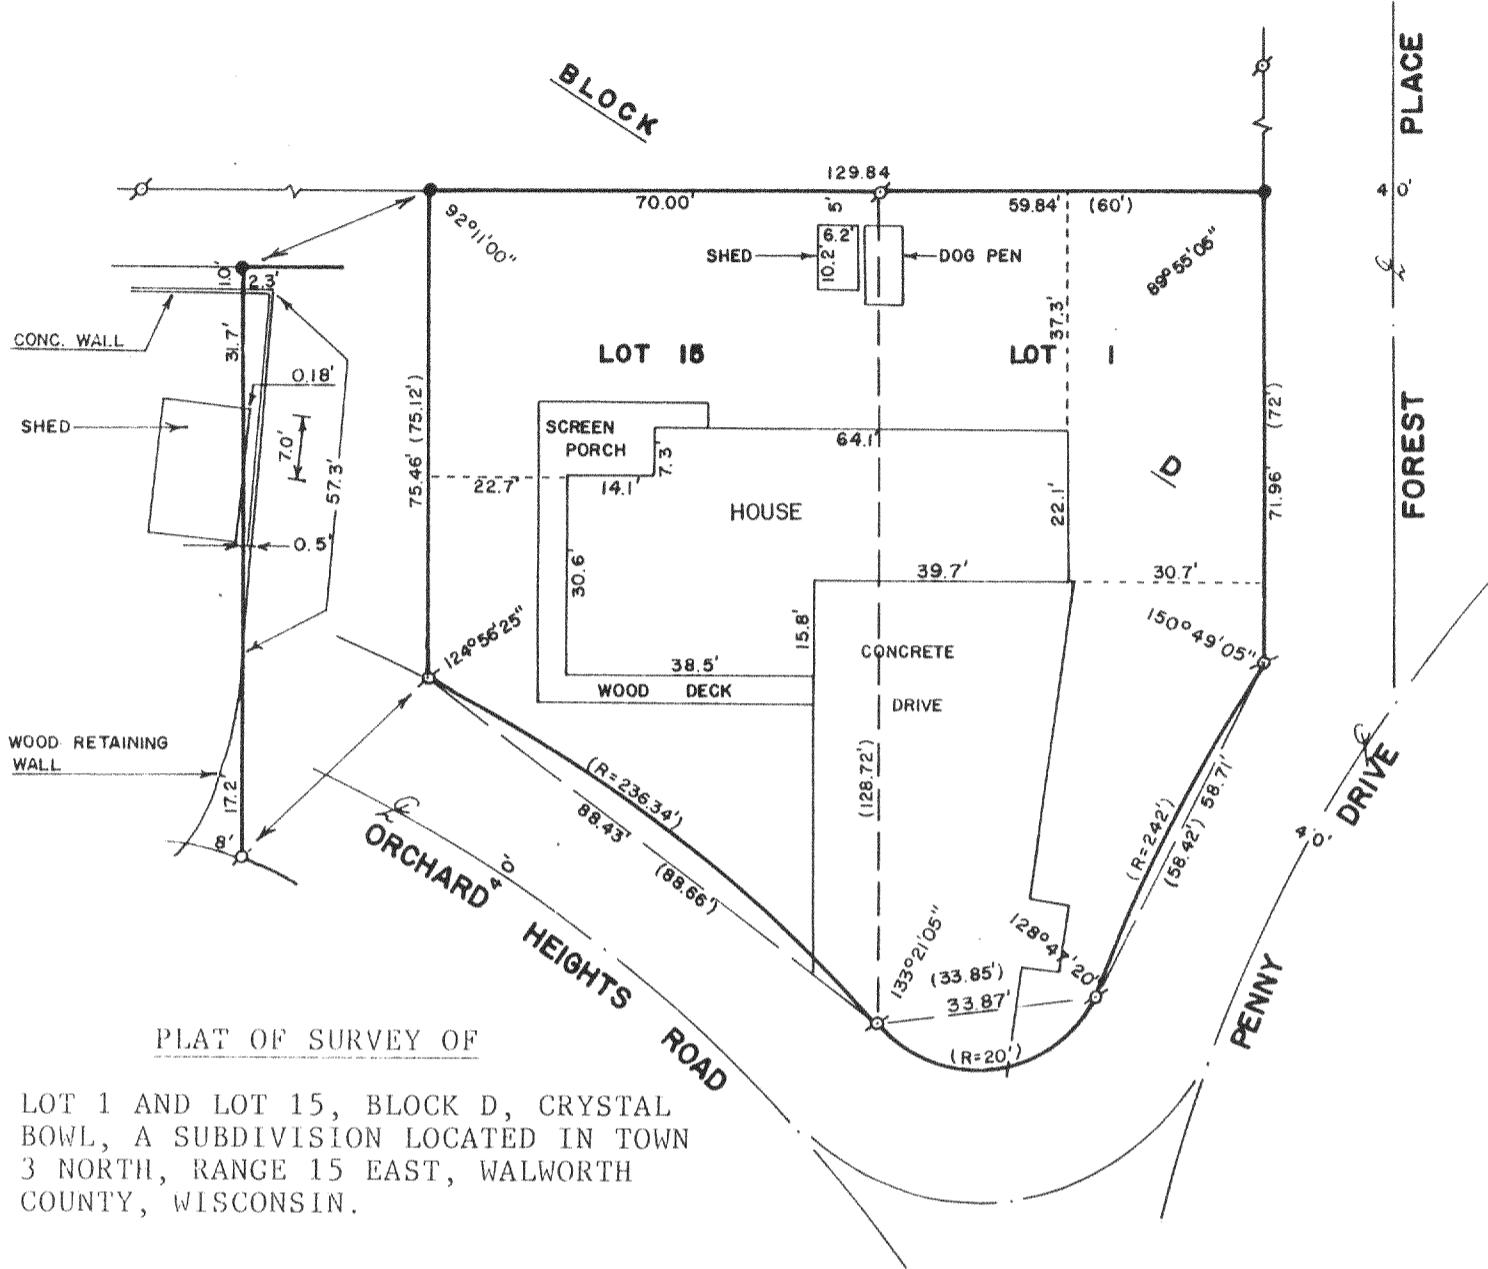

I, DAVID F. ABELL, DO HEREBY CERTIFY THAT I HAVE SURVEYED THE PROPERTY HEREON DESCRIBED ACCORDING TO THE OFFICIAL RECORDS, AND THAT THE PLAT HEREON IS A CORRECT REPRESENTATION OF THE PROPERTY LINES TO THE BEST OF MY KNOWLEDGE AND BELIEF.



David F. Abell

DAVID F. ABELL
WISCONSIN REGISTERED LAND SURVEYOR, S-1596

SCALE - 1"=30'

LEGEND

- ¤ - IRON ROD FOUND
- - IRON ROD SET
- () - RECORDED AS

November 14, 1985
DATE JOB NUMBER - 1185004

CCR-00088
CCR 00072

315-214