



DUNHAM SURVEYING, S.C.
SURVEYING & SUBDIVIDING
DELAVER, WISCONSIN 53115

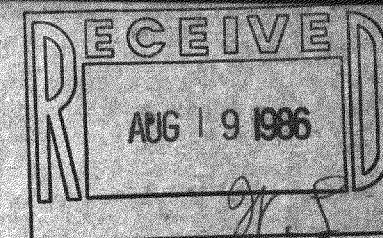

ETHELYN

DRIVE

N

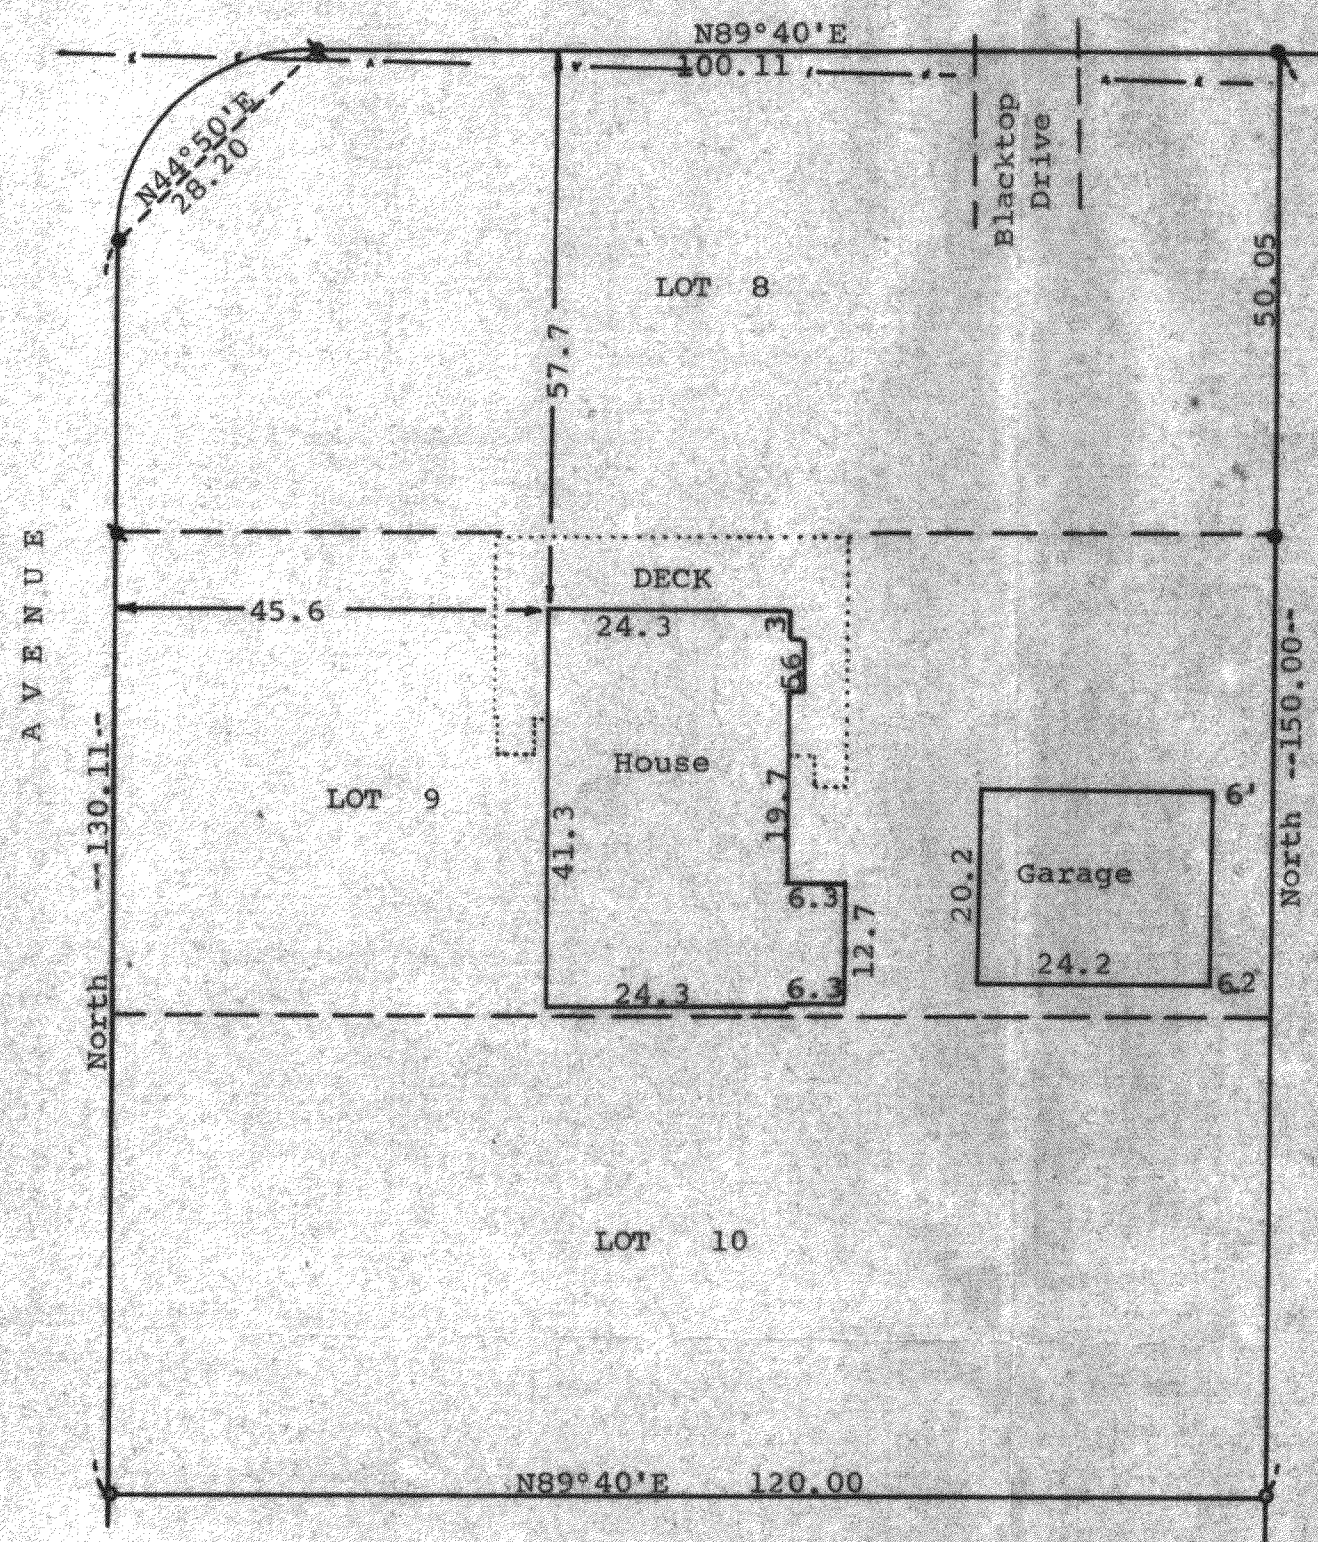

Scale - 1" = 20'

- = 5/8" Iron Rod Found
- ◊ = bent 5/8" Iron Rod Found
- = 3/4" Iron Pipe Found
- ⊕ = 1 1/4" X 24" Iron Pipe Set
- = Fence Line

Bearings referenced to the assumed bearing of North along the east line of Racine Avenue

Survey ordered by: Century 21, Skandia Realty
312 South 7th Street
Delaver, WI 53115

STATE OF WISCONSIN) SS
COUNTY OF WALWORTH)

I, George T. Dunham, Surveyor, certify that I have surveyed the property described as follows:

Lots 8, 9, and 10 in Block "I", Crystal Bowl, a subdivision located in Sections 12 and 13, T 3 N, R 15 E, Walworth County, Wisconsin,

and that the map shown above is a true representation thereof and shows the size and location of the property, its exterior boundaries, the location of all visible structures and dimensions of all principal buildings thereon, boundary fences, apparent easements, roadways and visible encroachments, if any, and that I have surveyed the property hereon described according to the official records to the best of my knowledge and belief.

November 26, 1984

George T. Dunham
George T. Dunham, Surveyor

