


D. D. COOPER & CO., INC.
Daniel D. Cooper
Rt. 4 Box 5088
Elkhorn, WI 53121

Plat of Survey of Lot 11, Oak Park Subdivision,
T3N, R15E, Walworth County, Wisconsin

Survey ordered by TLC Realty

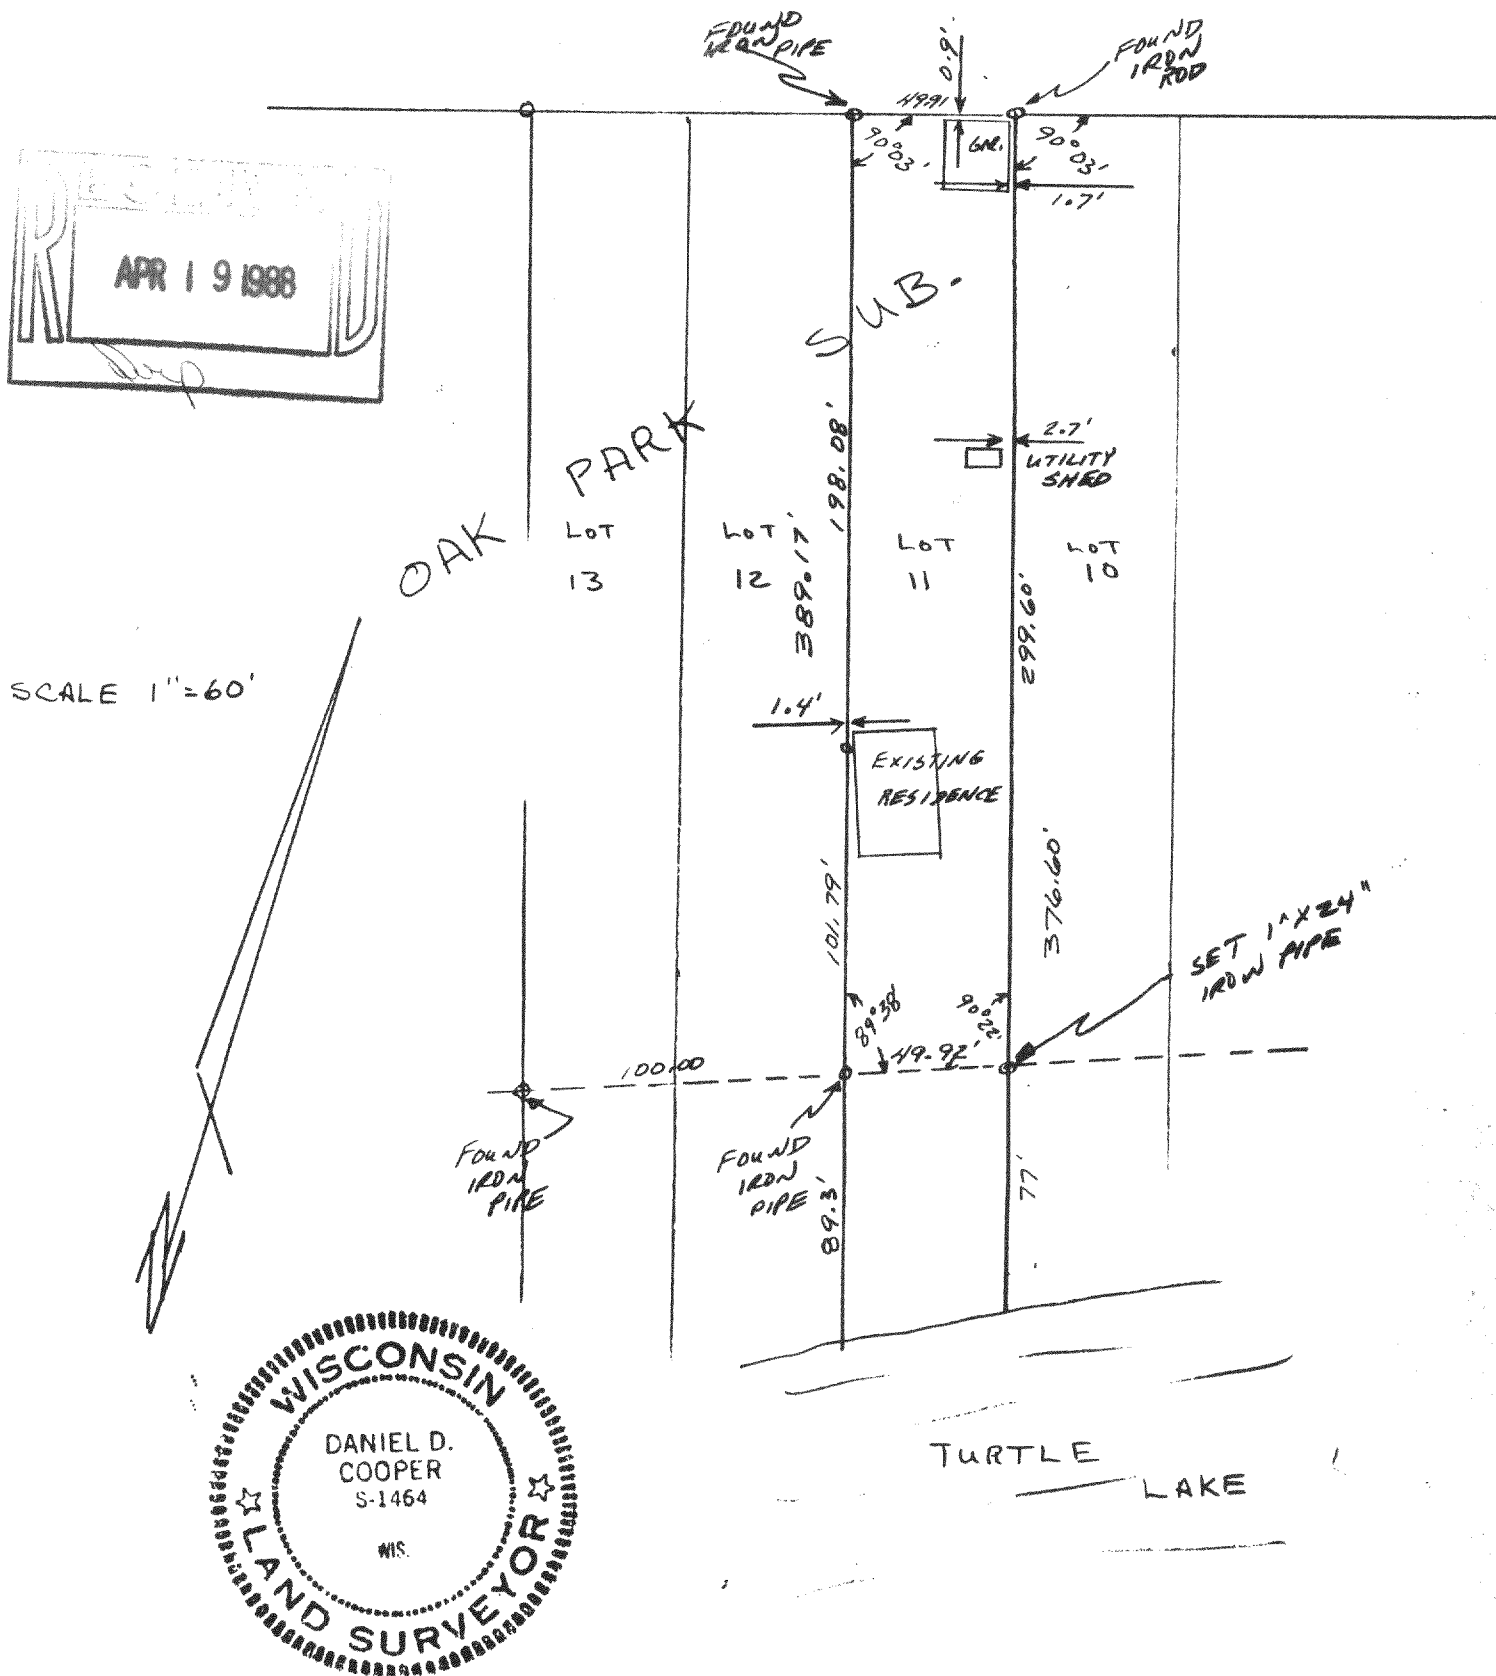

I hereby certify that I have surveyed the property described
hereon and that the above map is a true and accurate representation
thereof to the best of my professional knowledge and belief.

Dated this 3/ day of May 1987

Daniel D. Cooper
Daniel D. Cooper, RLS No. S-1464