

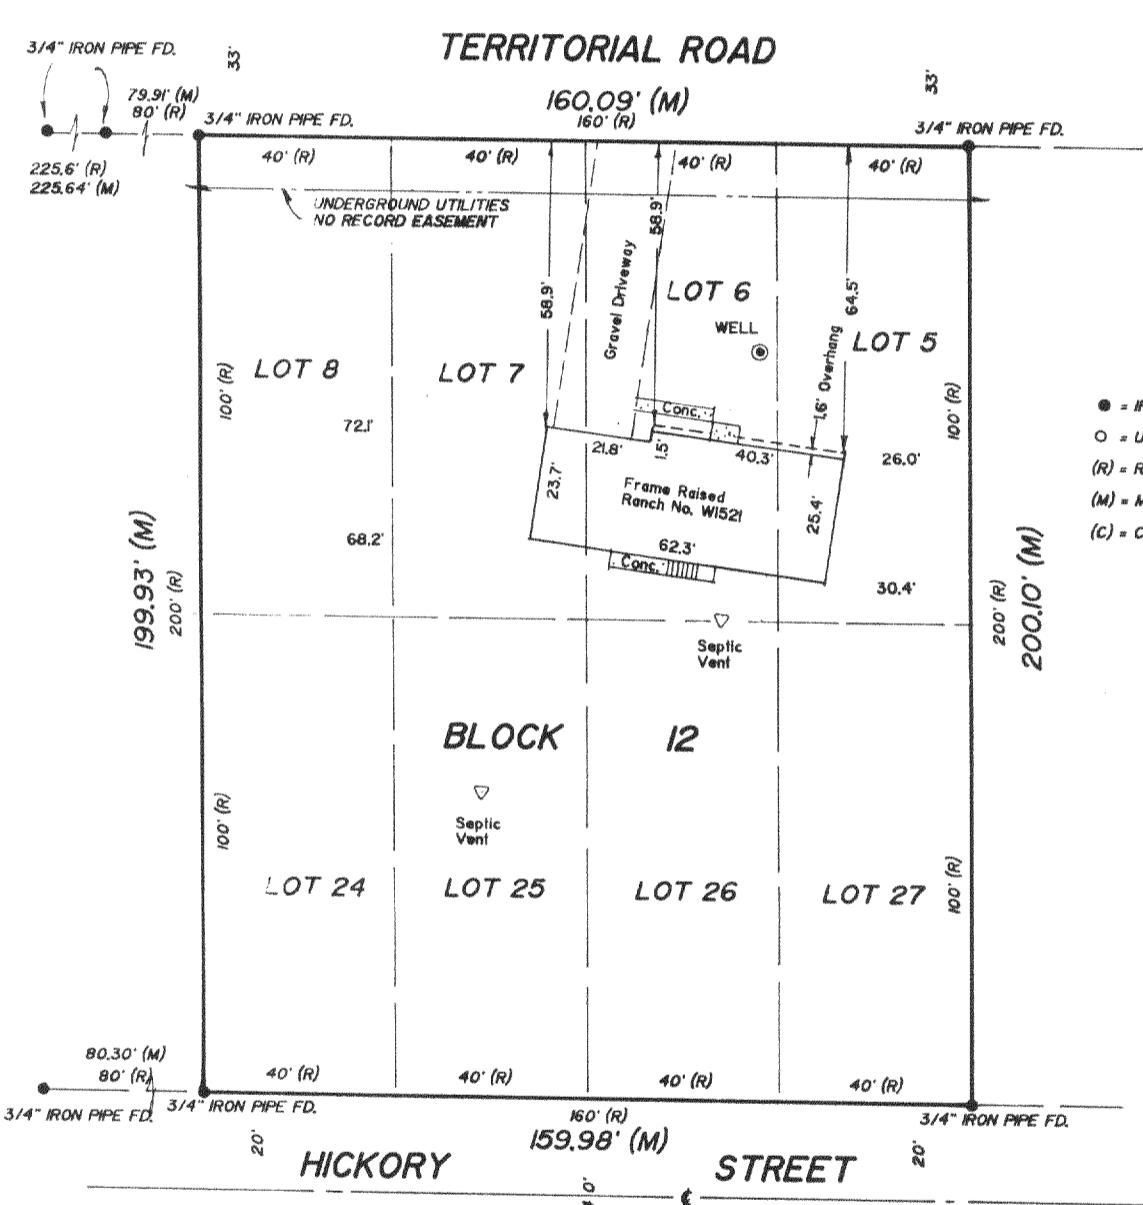


MORTGAGE INSPECTION SURVEY

Prepared By:
 The Landmark Survey Group, Inc.
 6320 Monona Drive, Suite 203
 Madison, WI 53716

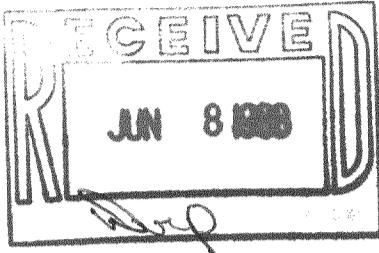

SURVEYED FOR: Commonwealth Credit Union
 SURVEYED ON: March 3, 1988.

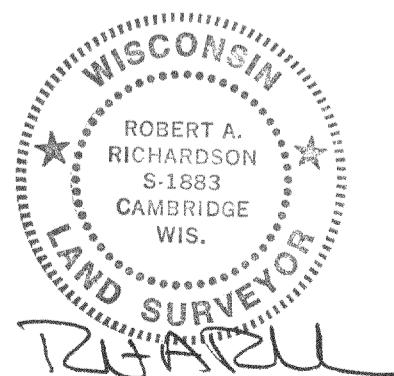

Map Number: 1408
 Job Number: 1408
 Page One of Two

315-246

MORTGAGE INSPECTION SURVEY

Prepared By:
The Landmark Survey Group, Inc.
6320 Monona Drive, Suite 203
Madison, WI 53716

LEGAL DESCRIPTION OF PROPERTY INSPECTED AND SURVEYED:

Lots 5, 6, 7, 8, 24, 25, 26, and 27, Block 12, Forest Beach Subdivision, a subdivision of a part of the Northwest 1/4 of Section 9, T3N, R15E, in the City of Whitewater, Walworth County, Wisconsin, according to the recorded plat in Volume 10, pages 6 and 7.

ADDRESS OF PROPERTY INSPECTED AND SURVEYED:

W 1521 Territorial Road, Whitewater, Wisconsin.

INSPECTED AND SURVEYED FOR: COPY TO:

Commonwealth Credit Union 1333 West Main Sun Prairie, WI 53590 Attn: Mary Hanson	Badger Abstract and Title 900 John Nolen Dr. No. 200 Madison, WI 53713
---	--

CLIENT:

Lee and Patricia Ferguson

CERTIFICATE:

I, the undersigned, a Registered Land Surveyor in the State of Wisconsin, do hereby certify that I have inspected, surveyed, and mapped the above described property according to the official records and that I have determined and shown the locations of all visible structures, the dimensions of all principal buildings, roadways, apparent and recorded easements, and visible encroachments, if any. This mortgage inspection survey has been prepared in accordance with the requirements of Commonwealth Credit Union, and under an agreement between the Landmark Survey Group, Inc. and Commonwealth Credit Union, which excludes this mortgage inspection survey from all of the requirements of Chapter A-E 7, Wisconsin Administrative Code; therefore, all of the requirements of Chapter A-E 7 have not been complied with. This mortgage inspection survey has been made for the exclusive use of the present owners of the described property and also for those who purchase, mortgage, or guarantee the title thereto within one year from the date hereof and to them we certify the accuracy of the attached plat and the survey upon which it is based.

Dated this 8th day of March, 1988.

Robert A. Richardson

Robert A. Richardson
Wisconsin Registered Land Surveyor
Number S-1883

