


DUNHAM SURVEYING, S.C.
SURVEYING & SUBDIVIDING
DELAVER, WISCONSIN 53115

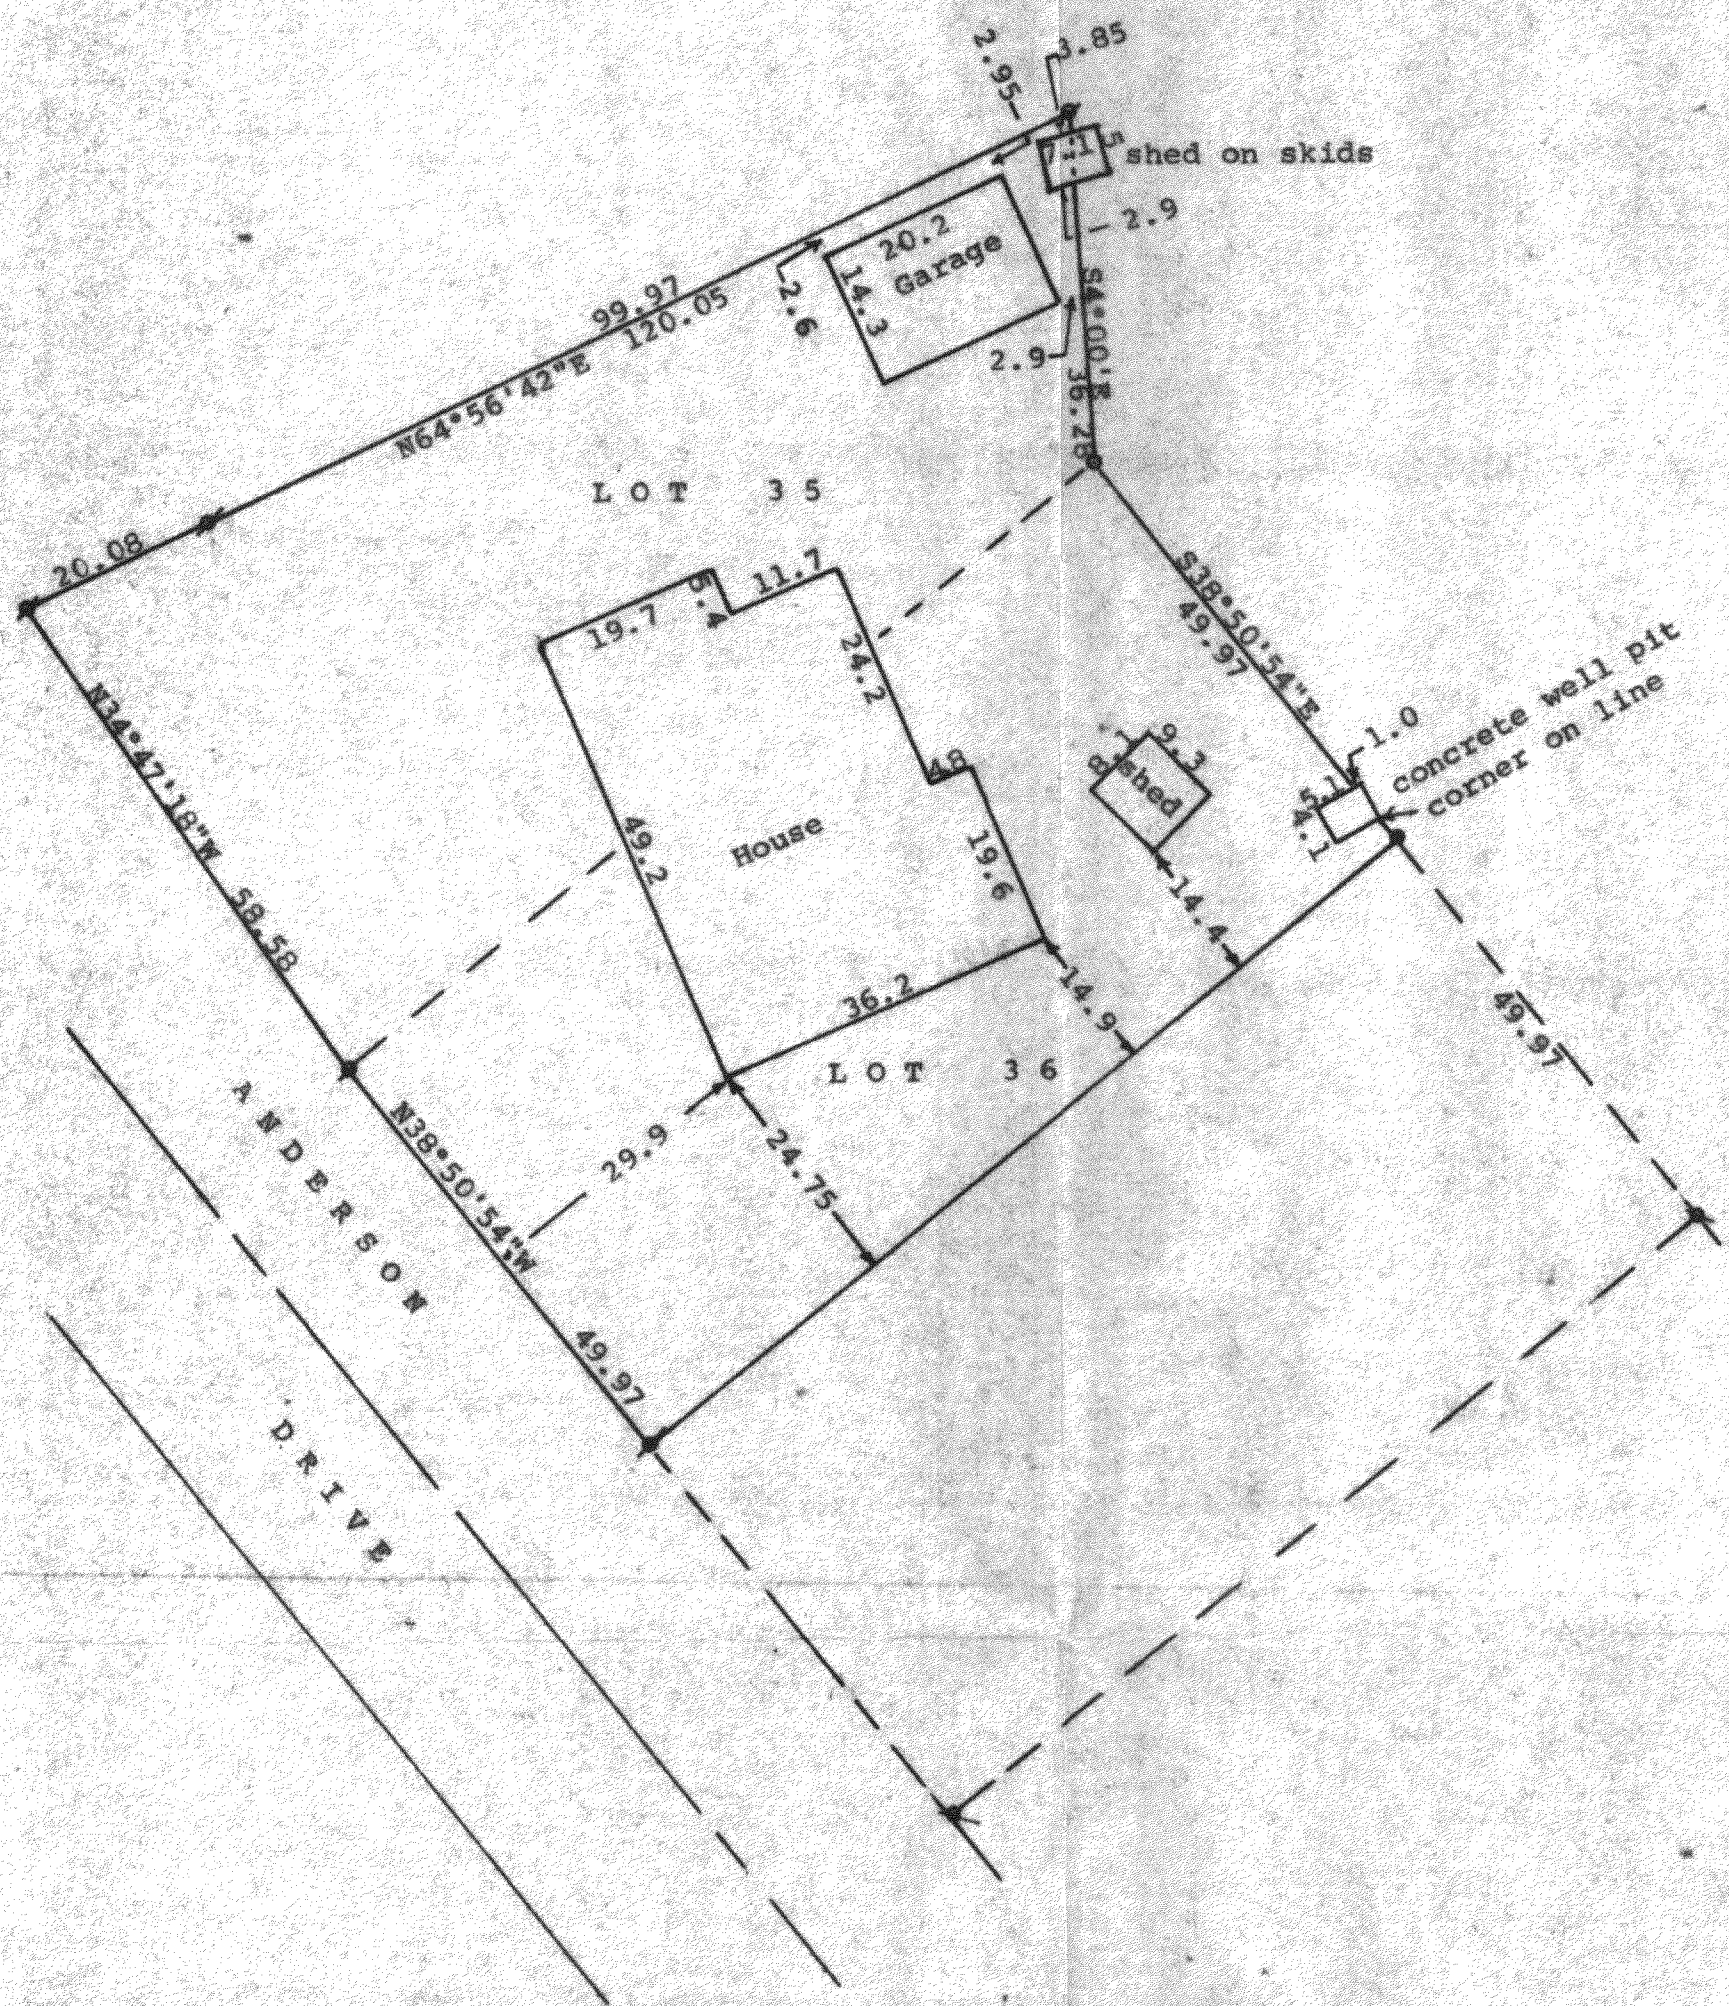

Scale - 1" = 20'

o = 3/4" Iron Rod Found

⊗ = 3/4" Iron Pipe Found

● = 1" Tall Iron Pipe in concrete found

Bearings referenced to the assumed bearing of S4°00'E along the easterly line of Lot 35


Survey ordered by: Century 21
Skandia Realty
312 South 7th St.
Delavan, WI 53115

STATE OF WISCONSIN) SS
COUNTY OF WALWORTH)

I, George T. Dunham, Surveyor, certify that I have surveyed the property described as follows:

Lots 35 & 36 in Block "G" of Crystal Bowl, a subdivision located in Sections 12 and 13, T 3 N, R 15 E, Walworth County, Wisconsin, and that the plat shown hereon is a correct representation thereof and shows the size and location of the property, its exterior boundaries, the location of all visible structures and dimensions of all principal buildings thereon, boundary fences, apparent easements, roadways and visible encroachments, if any, and that I have surveyed the property hereon described, according to the official records, to the best of my knowledge and belief.

June 10, 1988

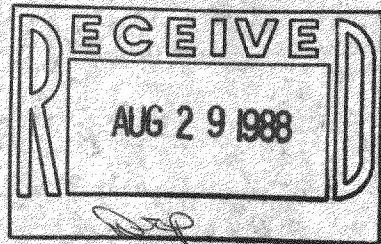

George T. Dunham
George T. Dunham, Surveyor

