

ABERNATHY and ASSOCIATES


Kenneth B. Abernathy Jr.

Wisconsin Registered Land Surveyor S-1594


Rt. 3, Box 273
Elkhorn, Wisconsin 53121
Phone: (414) 723-4260 (office)
(414) 723-4813 (residence)

PLAT OF SURVEY


Lots 8, 9, 10 and 21 of Block 4 of Forest Beach Subdivision,
located in the Northwest $\frac{1}{4}$ of Section 9, Town 3 North,
Range 15 East, Walworth County, Wisconsin.

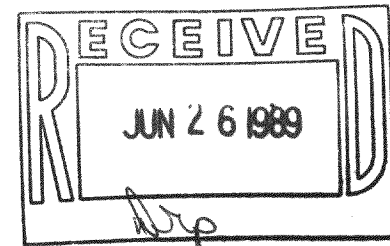


CURVE DATA LOTS 8, 9, 10
CHORD BEARING = $S24^{\circ}27'38''W$
CHORD = 129.26
I X = $9^{\circ}32'48''$
E = 786.6'

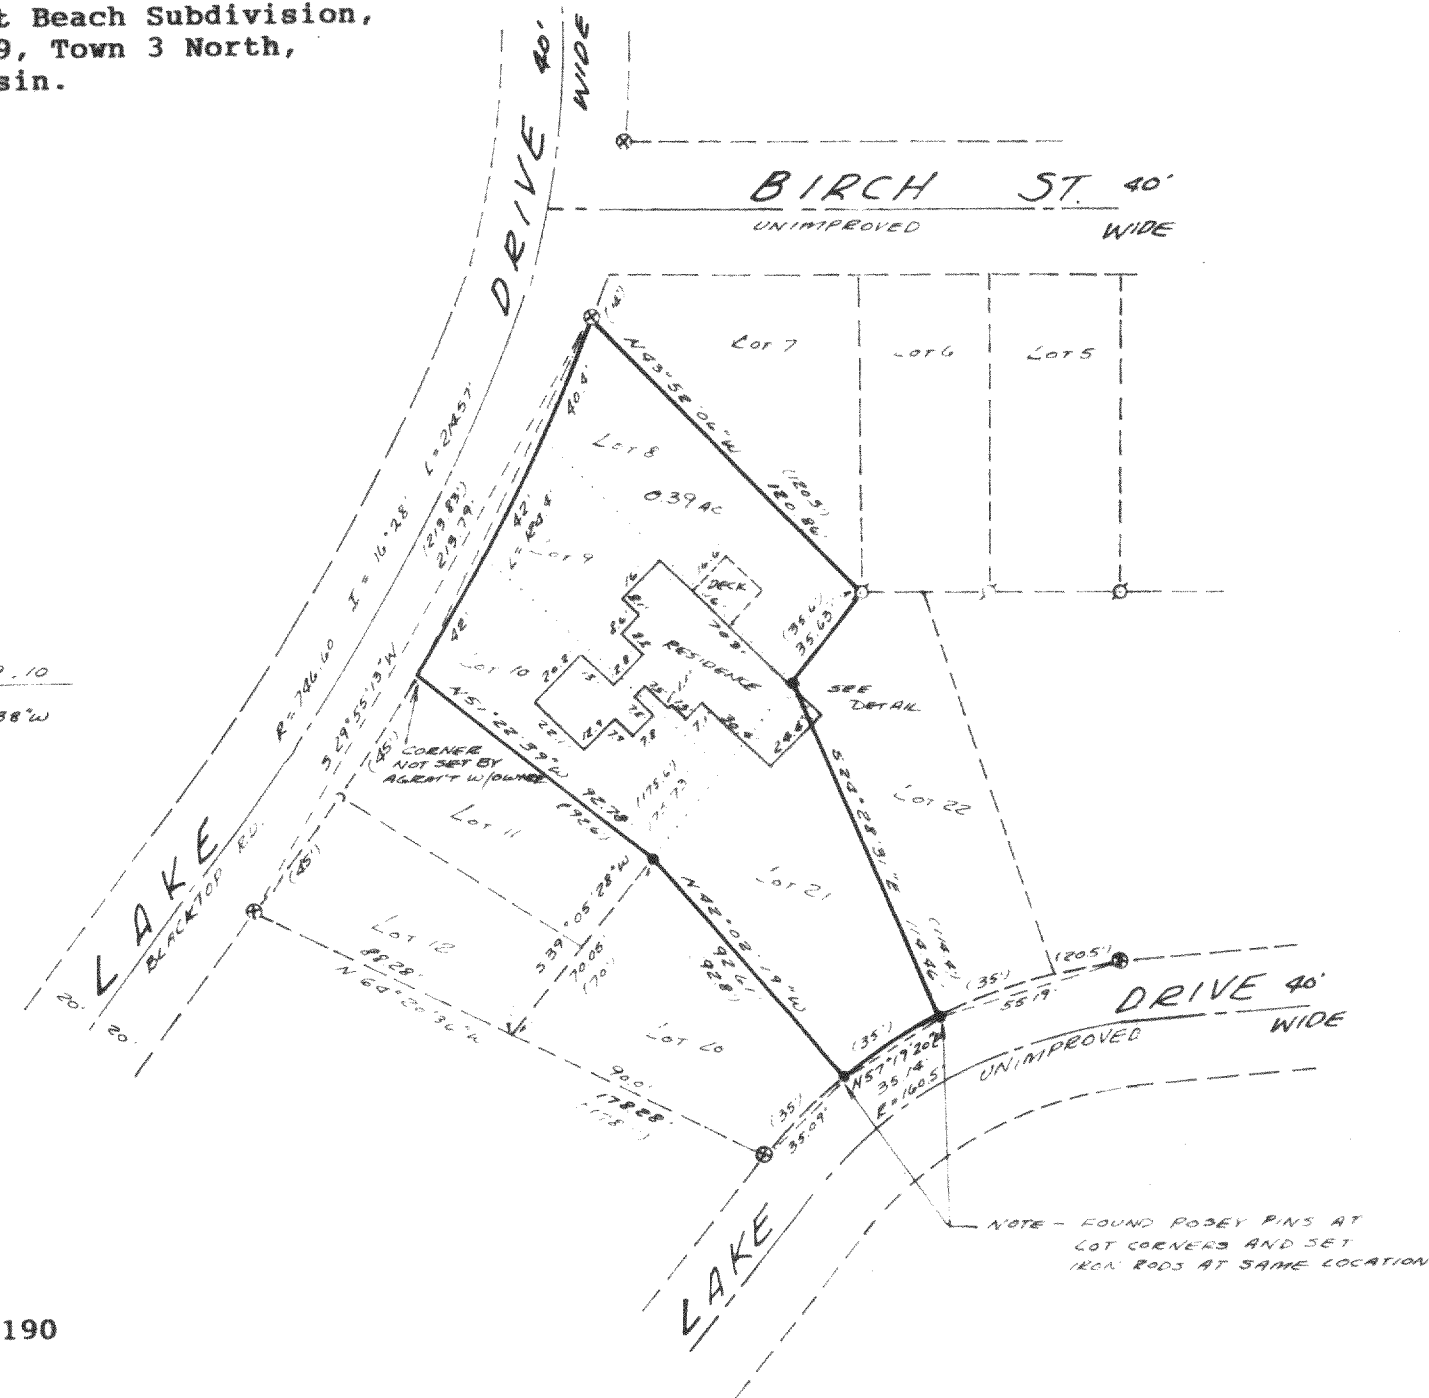

Ordered By: Alan Petrie
Rt. 3 Box 358
Whitewater, WI. 53190

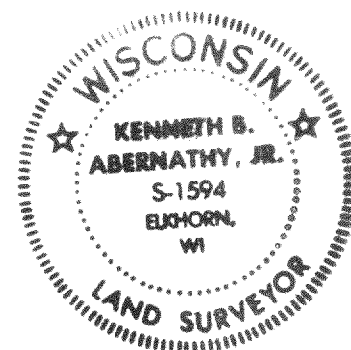


note: bearings are based on previous surveys of record
and assume the northerly line of Lot 8 to bear
 $N 43^{\circ}52'06''W$.

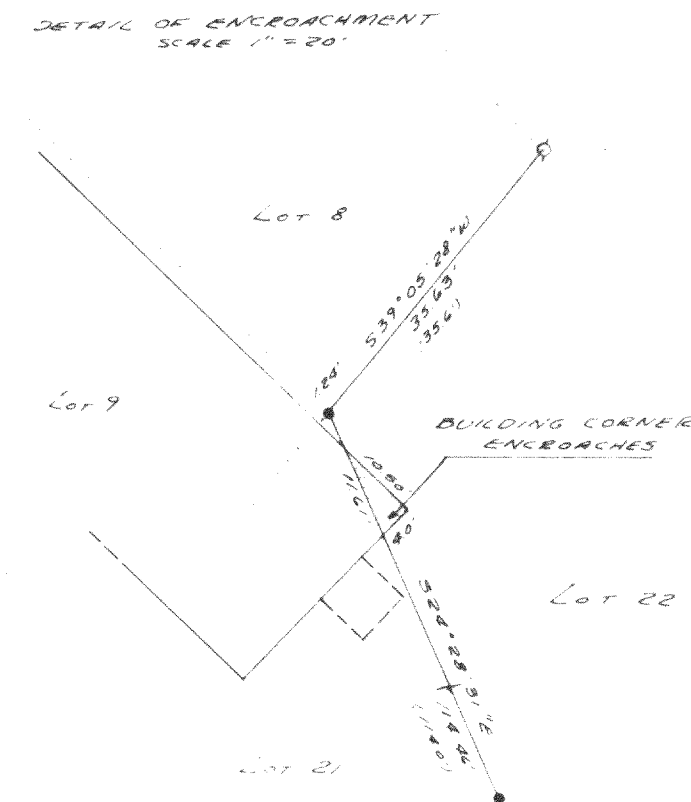

Legend

- FOUND IRON PIPE
- FOUND IRON ROD
- FOUND BRASS CAPPED MONUMENT
- FOUND CONCRETE MONUMENT
- CHISEL CUT IN CONCRETE
- SET IRON ROD, 24" LONG, WEIGHING 1.5 LBS./LINEAL FT., $\frac{3}{4}$ " DIA.
- SET IRON ROD, 30" LONG, WEIGHING 4.5 LBS./LINEAL FT., $1\frac{11}{16}$ " DIA.
- (xx) RECORDED AS DIMENSION
- EXISTING FENCE
- POSEY PIN

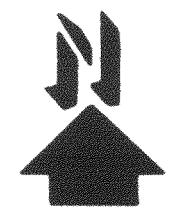

SCALE: 1" = 60 FEET

"I hereby certify that I have surveyed the above described property and that the above map is a true representation thereof and shows the size and location of the property, its exterior boundaries, the location of all visible structures and dimensions of all principal buildings thereon, boundary fences, apparent easements, roadways and visible encroachments, if any."
"This survey is made for the use of the present owners of the property, and also those who purchase, mortgage, or guarantee the title thereto within one year from date hereof."

Kenneth B. Abernathy Jr.
KENNETH B. ABERNATHY, JR.
WISCONSIN REGISTERED LAND SURVEYOR,
S-1594

Date: JUNE 16, 1989 Job No. 89-605

CFB-23 26

315-261