

Handwritten scribbles at the top of the page.

JUNIPER RD.

(RECORDED 90.0)
NORTH 89.84'

127.68'

N 89° 58' W (RECORDED 95.0)


D. Cooper & CO., INC.
Rt 4 Box 508B • Elkhorn WI 53121

CEDAR RD.

N 89° 56' W 95.14' (RECORDED 95.0)

LOT 14

LOT 12

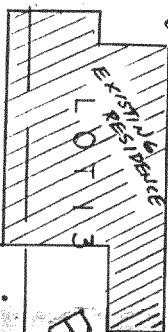

BLOCK 8

(RECORDED 90.0)

ADJ. W. P. L. METAL
ADJ. S. W. L. METAL
ADJ. E. W. L. METAL

I hereby certify that I have surveyed the property described hereon and that the map shown hereon is a true and accurate representation thereof to the best of my professional knowledge and belief.

Dated this 29 day of Sept., 1990

Daniel D. Cooper
Daniel D. Cooper, RLS No. S-1464



Bearing Reference: Westerly line of lots assumed North-South

Scale 1"=20'

○ indicated iron pipe found
φ indicated iron pipe set 1"x24"

Survey ordered by Century 21 Whitewater

Plat of Survey of Lots 12, 13, & 14 of Block 8 of Skansens Subdivision being located in T3N, R15E, Walworth County, Wisconsin

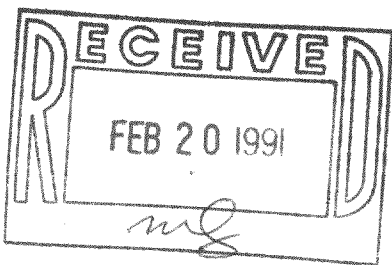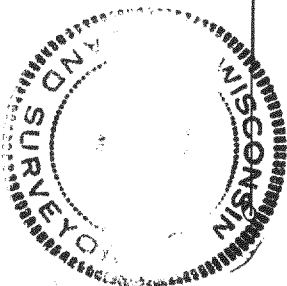

Reduced

SEC 9-3-15

TAX # CS00139

315-281

DRAWING NO. 3696

ORIGINAL ONLY IF SEALED IN RED INK