


DUNHAM SURVEYING, S.C.
SURVEYING & SUBDIVIDING
DELAVER, WISCONSIN 53115

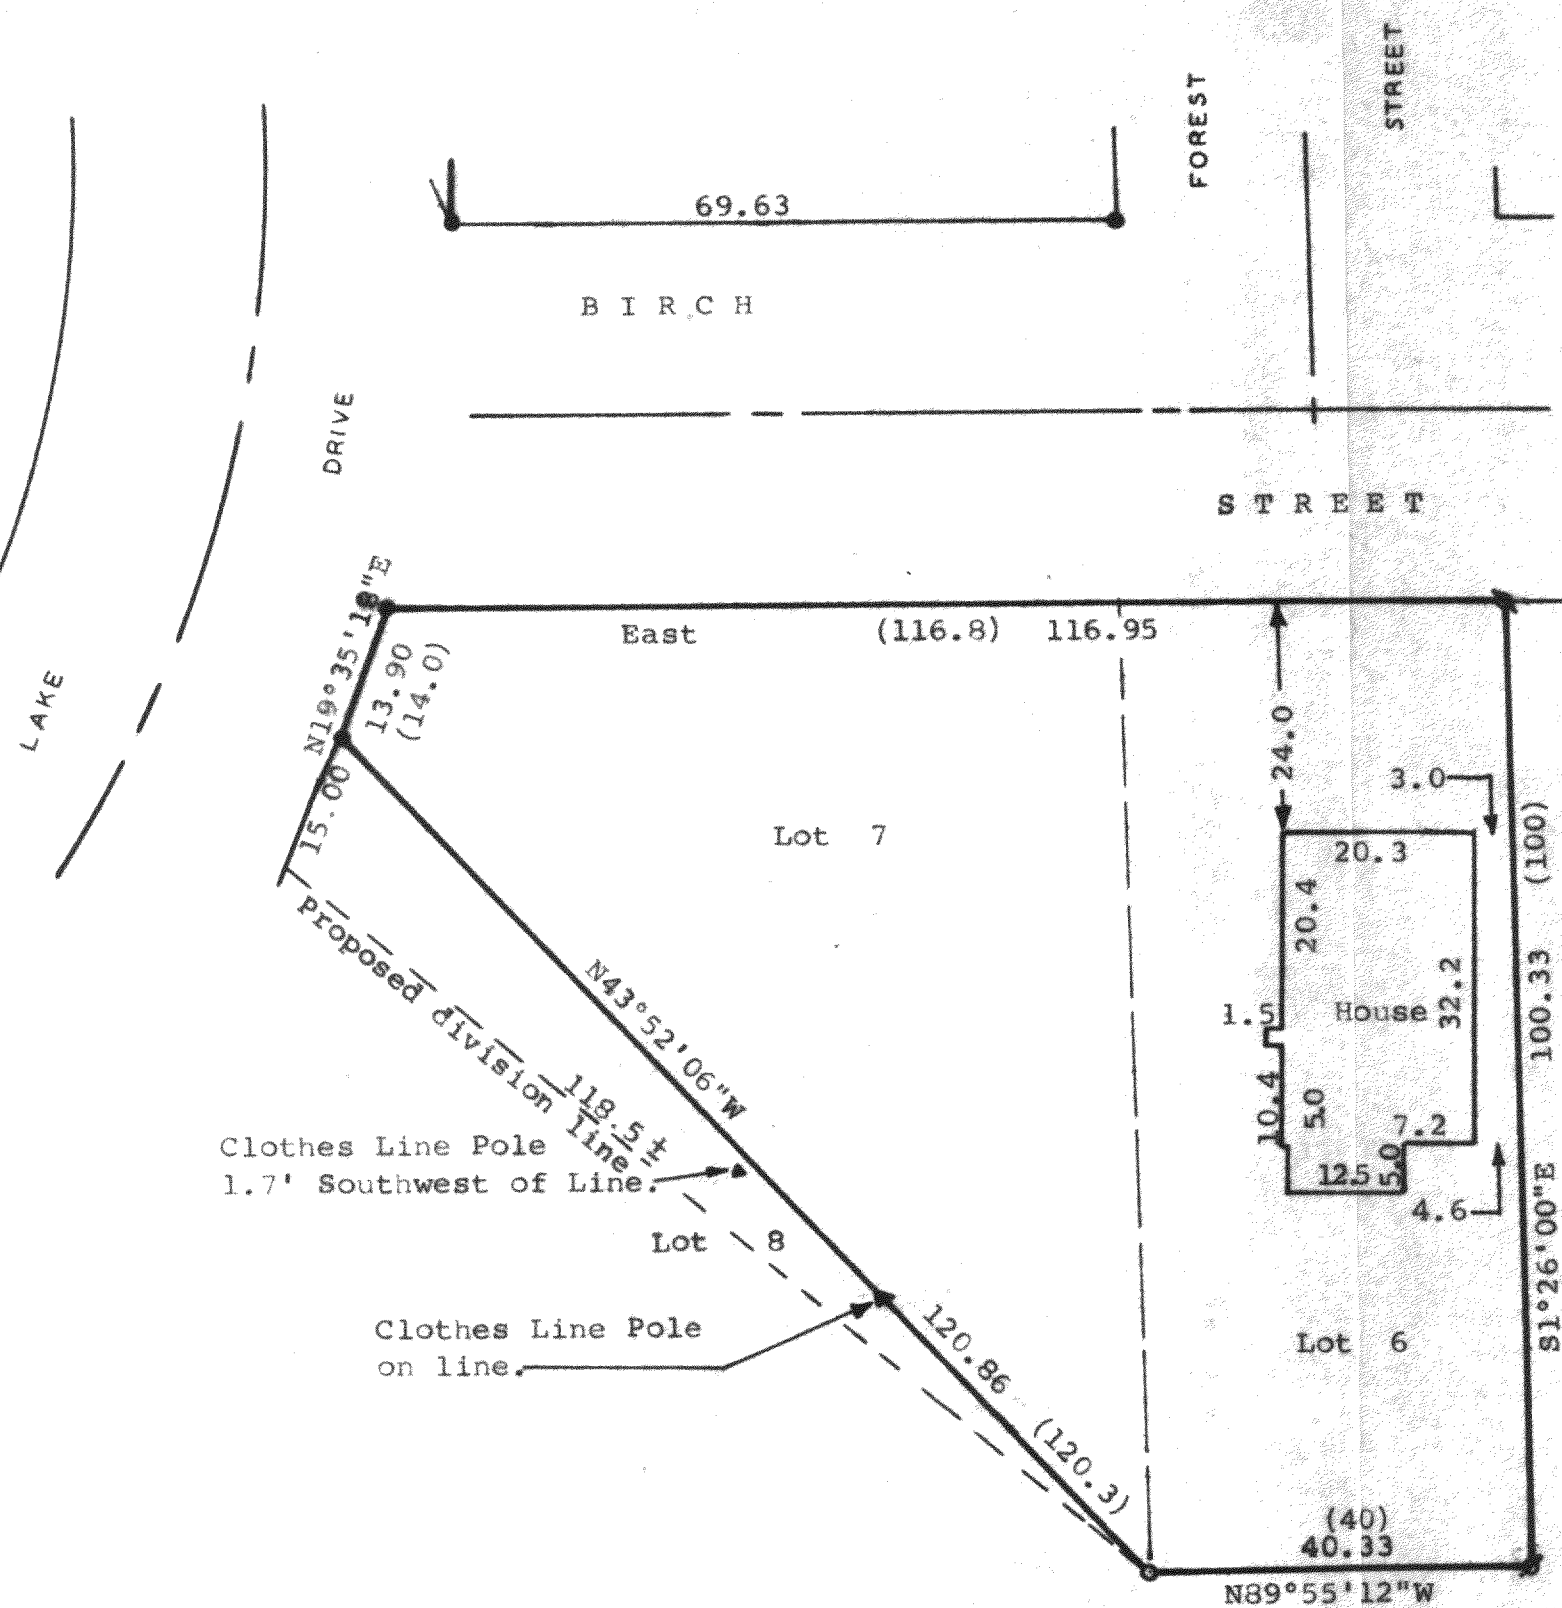

Scale - 1" = 20'
 ● = Concrete Monument Found
 ○ = 1" Dia. Iron Pipe Found
 ◐ = 3/4" Dia. Iron Pipe Found
 ▬ = 1/2"x24" Iron Pipe Set
 ▲ = Clothes Line Pole
 (00) = Recorded Distance

Bearings are referenced to the South line of Birch Street, assumed bearing of East-West.

Survey Ordered By: G. W. Burke
 66 East Walworth Avenue
 Delavan, Wisconsin 53115



STATE OF WISCONSIN)
 COUNTY OF WALWORTH) SS

I, George T. Dunham, Surveyor, certify that I have surveyed the property described as follows,

Lots 6 and 7, Block 4 of Forest Beach, a subdivision located in the Northwest 1/4 of Section 9, T3N, R15E, Walworth County, Wisconsin, and that the above map is a true representation thereof and shows the size and location of the property, its exterior boundaries, the location of all visible structures and dimensions of all principal buildings thereon, boundary fences, apparent easements, roadways and visible encroachments, if any, and that I have surveyed the property hereon described according to the official records, to the best of my knowledge and belief.

July 31, 1986.
 Revised October 20, 1989

George T. Dunham
 George T. Dunham, Surveyor

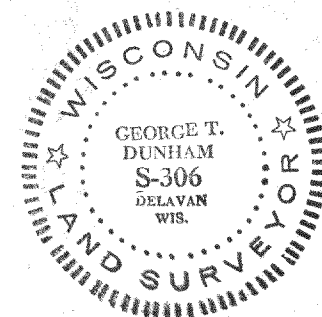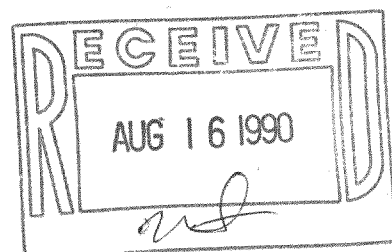

Survey # 315-286

TAX KEY # CFB 00022