


DUNHAM SURVEYING, S.C.
SURVEYING & SUBDIVIDING
DELAYAN, WISCONSIN 53115



Scale - 1" = 20'
 ⌀ = 1" Iron Pipe Found
 ● = Concrete Monument Found
 ⚭ = 5/8" Iron Rod Found
 ✕ = Posey pin found, Set 1/2" X 24" Iron Pipe
 ○ = 1 1/4" X 24" Iron Pipe Set
 Ⓚ = 1/2" Iron Pipe Found
 (0.00) = recorded distance
 Bearings referenced to the previously assumed bearing of
 N89°55'12"W along the northerly line of Lots 23 & 24
 Survey ordered by: G. W. Burke
 R. 3, Box 366A
 Whitewater, WI 53190

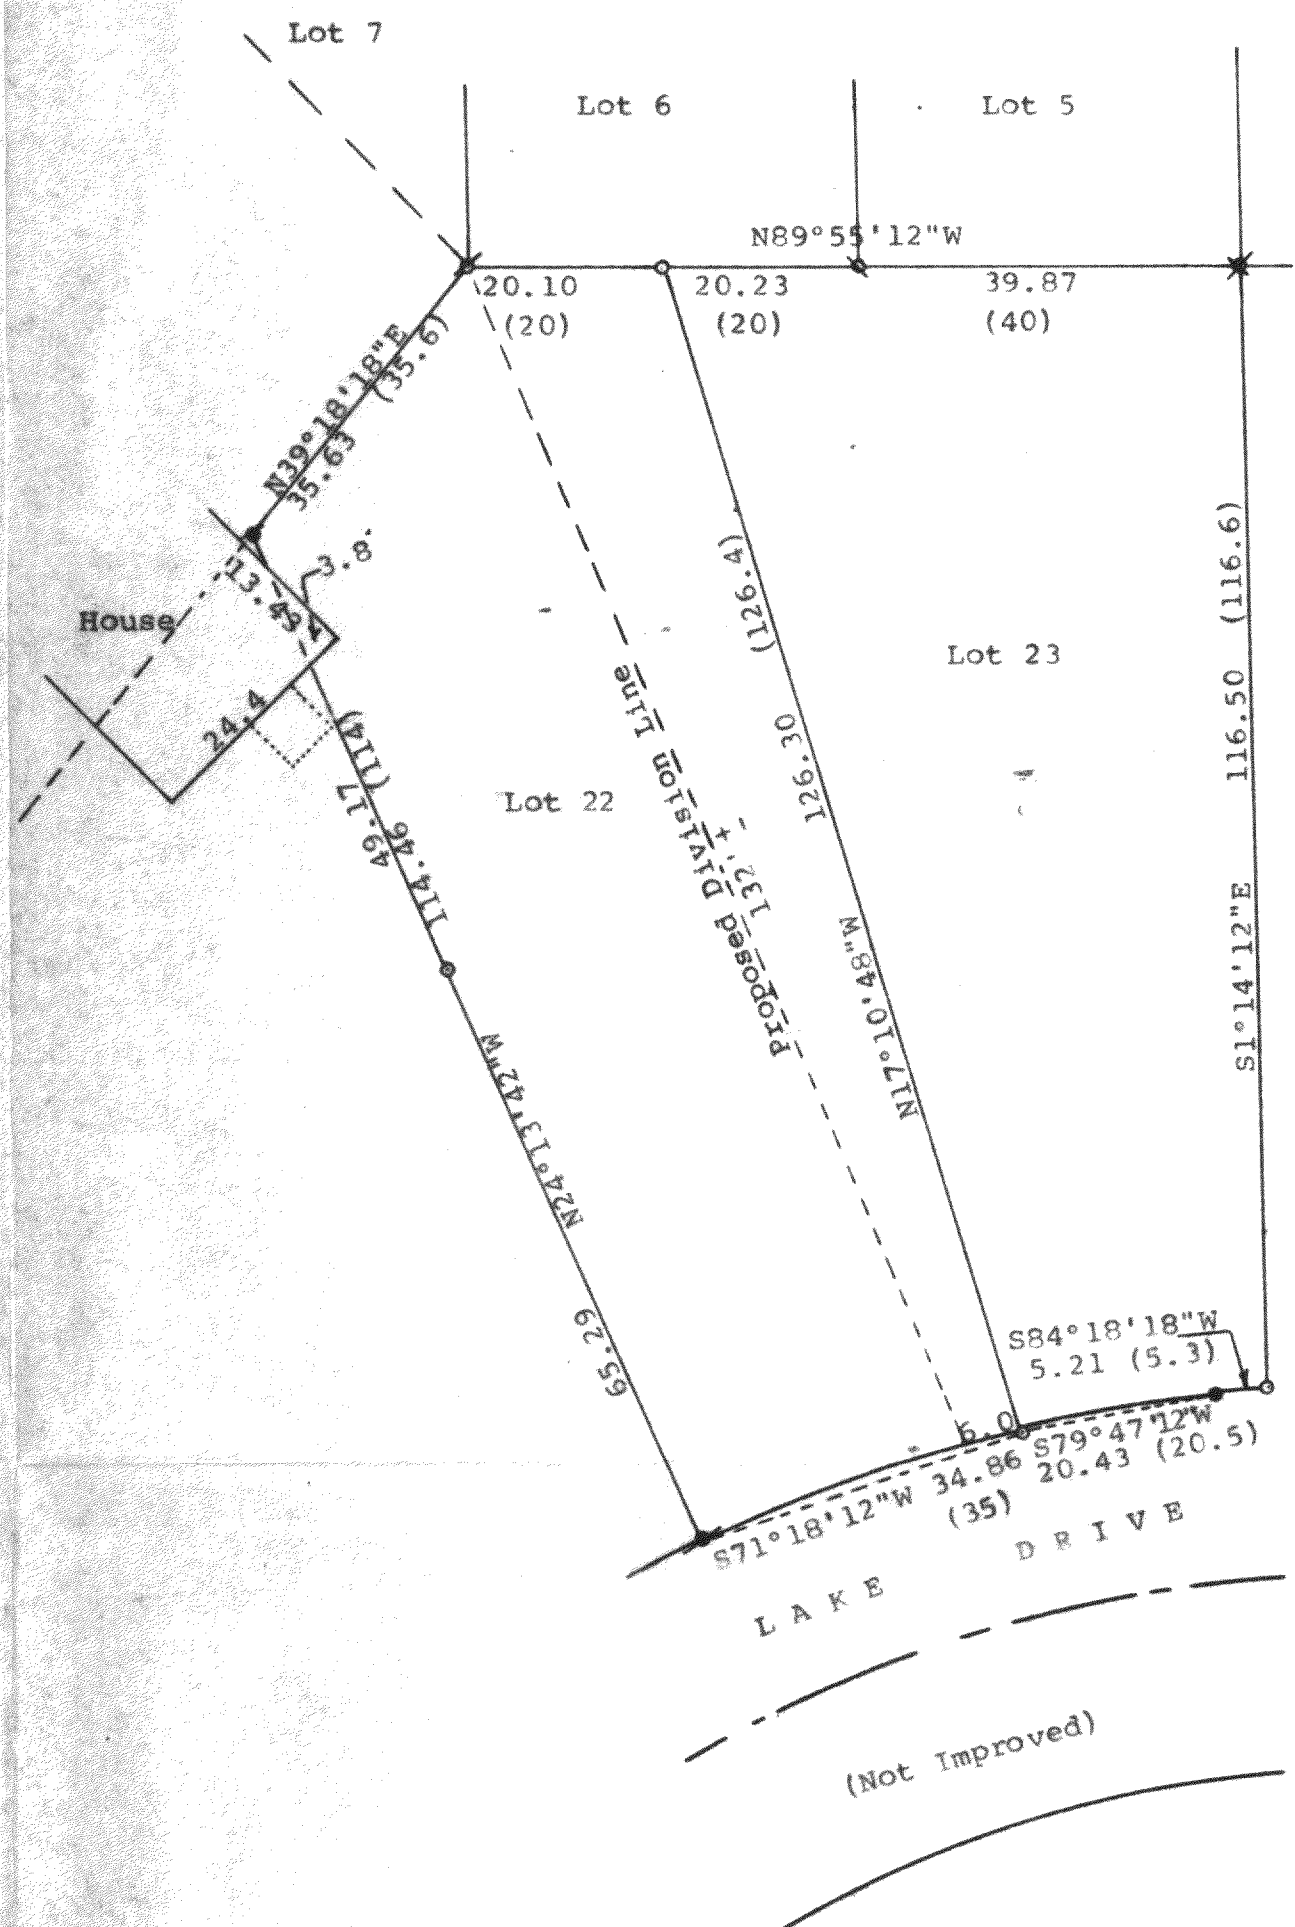

STATE OF WISCONSIN) ss
 COUNTY OF WALWORTH)

I, George T. Dunham, Surveyor, certify that I have surveyed the property described as follows:

Lots 22 and 23 in Block 4 of Forest Beach, a subdivision located in the Northwest 1/4 of Section 9, T 3 N, R 15 E, Walworth County, Wisconsin, and that the plat shown hereon is a correct representation thereof and shows the size and location of the property, its exterior boundaries, the location of all visible structures and dimensions of all principal buildings thereon, boundary fences, apparent easements, roadways and visible encroachments, if any, and that I have surveyed the property hereon described, according to the official records, to the best of my knowledge and belief.

June 19, 1989
 Revised October, 1989

George T. Dunham
 George T. Dunham, Surveyor

