

PLAT OF SURVEY OF LOTS 9, 10 AND 11, BLOCK 1
OF FOREST BEACH, A SUBDIVISION LOCATED IN SECTION 9, T3N, R1E,
TOWN OF RICHMOND, WALWORTH COUNTY, WISCONSIN.

JENSEN SURVEYING & MAPPING S.C.

45 S. WISCONSIN ST. - P.O. BOX 322, ELKHORN, WI - 53121

SURVEYED FOR: JOE NOTBUSCH

N2063 FOREST BEACH

RT # 3

WHITEWATER, WI., 53190

RESURVEYED FOR:

CARMIA REALTORS

REALTY WORLD

P.O. BOX 502

DELEVAN, WIS. 53115





BEARINGS REFERENCED TO
SUBDIVISION PLAT WEST
LINE OF BLOCK 1 S4°37'E


SCALE - 1" = 30'

- 1 1/2" DIA. IRON PIPE FOUND
- 4" SQUARE CONCRETE MON. FOUND
- △ IRON POSEY PIN FOUND
- () RECORDED DIMENSION

RECORDED CENTERLINE
CURVE DATA
CENTRAL ANGLE 4°40'22"
RADIUS 196.1

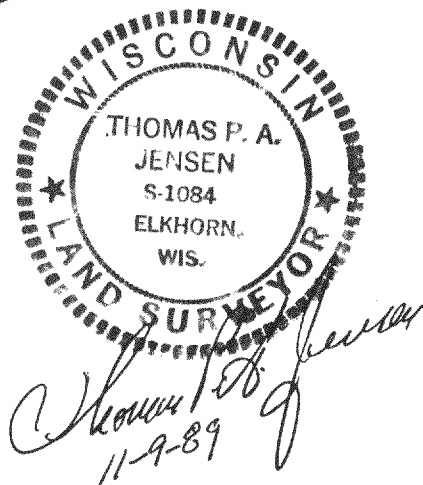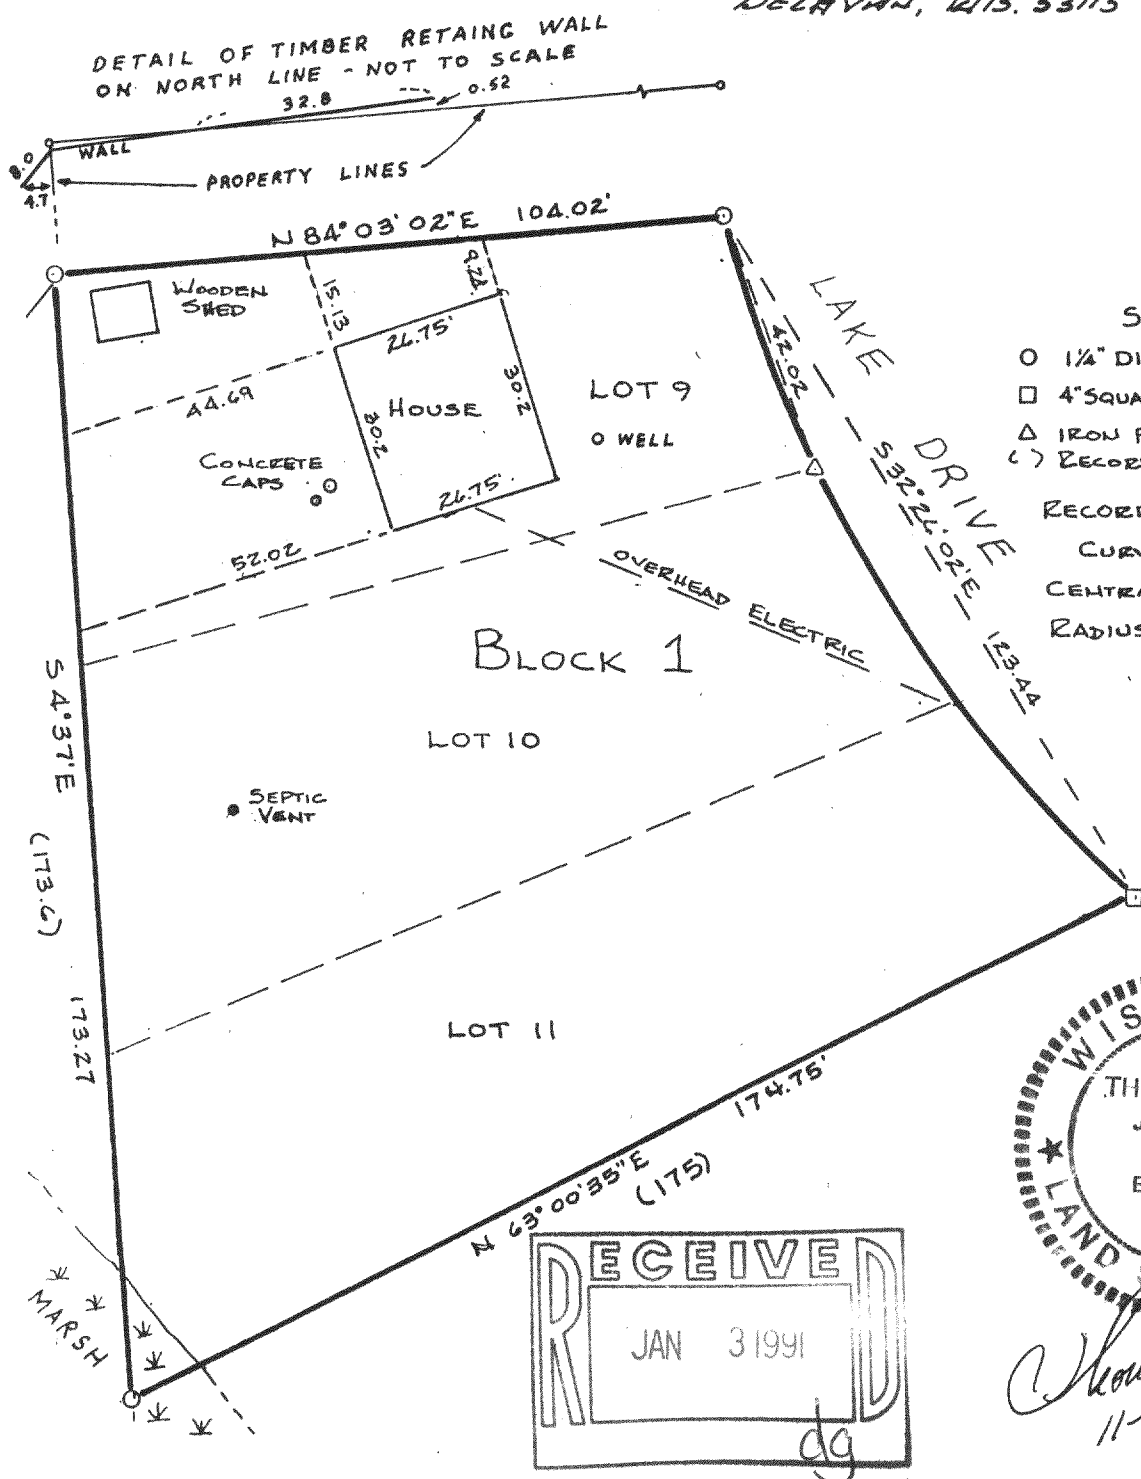

I ROBERT L. MEADOWS JR., WISCONSIN REGISTERED LAND SURVEYOR, DO HEREBY
CERTIFY THAT THIS SURVEY WAS PERFORMED BY ME IN FULL COMPLIANCE WITH
THE OWNER'S/AGENT'S INSTRUCTIONS AND CHAPTER A-E 5 OF THE WISCONSIN
ADMINISTRATIVE CODE "MINIMUM STANDARDS FOR PROPERTY SURVEYS"; AND THAT
THIS MAP IS AN ACCURATE REPRESENTATION THEREOF TO THE BEST OF
MY KNOWLEDGE AND BELIEF.

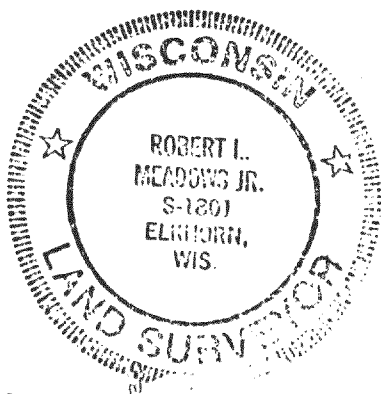

Robert L. Meadows Jr.
ROBERT L. MEADOWS JR. RLS # 1801
MARCH 28, 1985
REVISED: NOV. 9, 1989

CFB 00009
CFB 00010

1989.142
1985.020 A

315-298

1985.020 A X