


ABELL
SURVEYING & MAPPING
DELAVER, WISCONSIN 53115
414-728-6737



PLAT OF SURVEY OF

THE SOUTHERLY 20 FEET OF LOT 20, LOTS 21-24, BLOCK 2, LOT 1 BLOCK 3, AND LOTS 11-14, BLOCK 7 OF FOREST BEACH SUBDIVISION, LOCATED IN T3N, R1E, WALWORTH COUNTY, WISCONSIN.

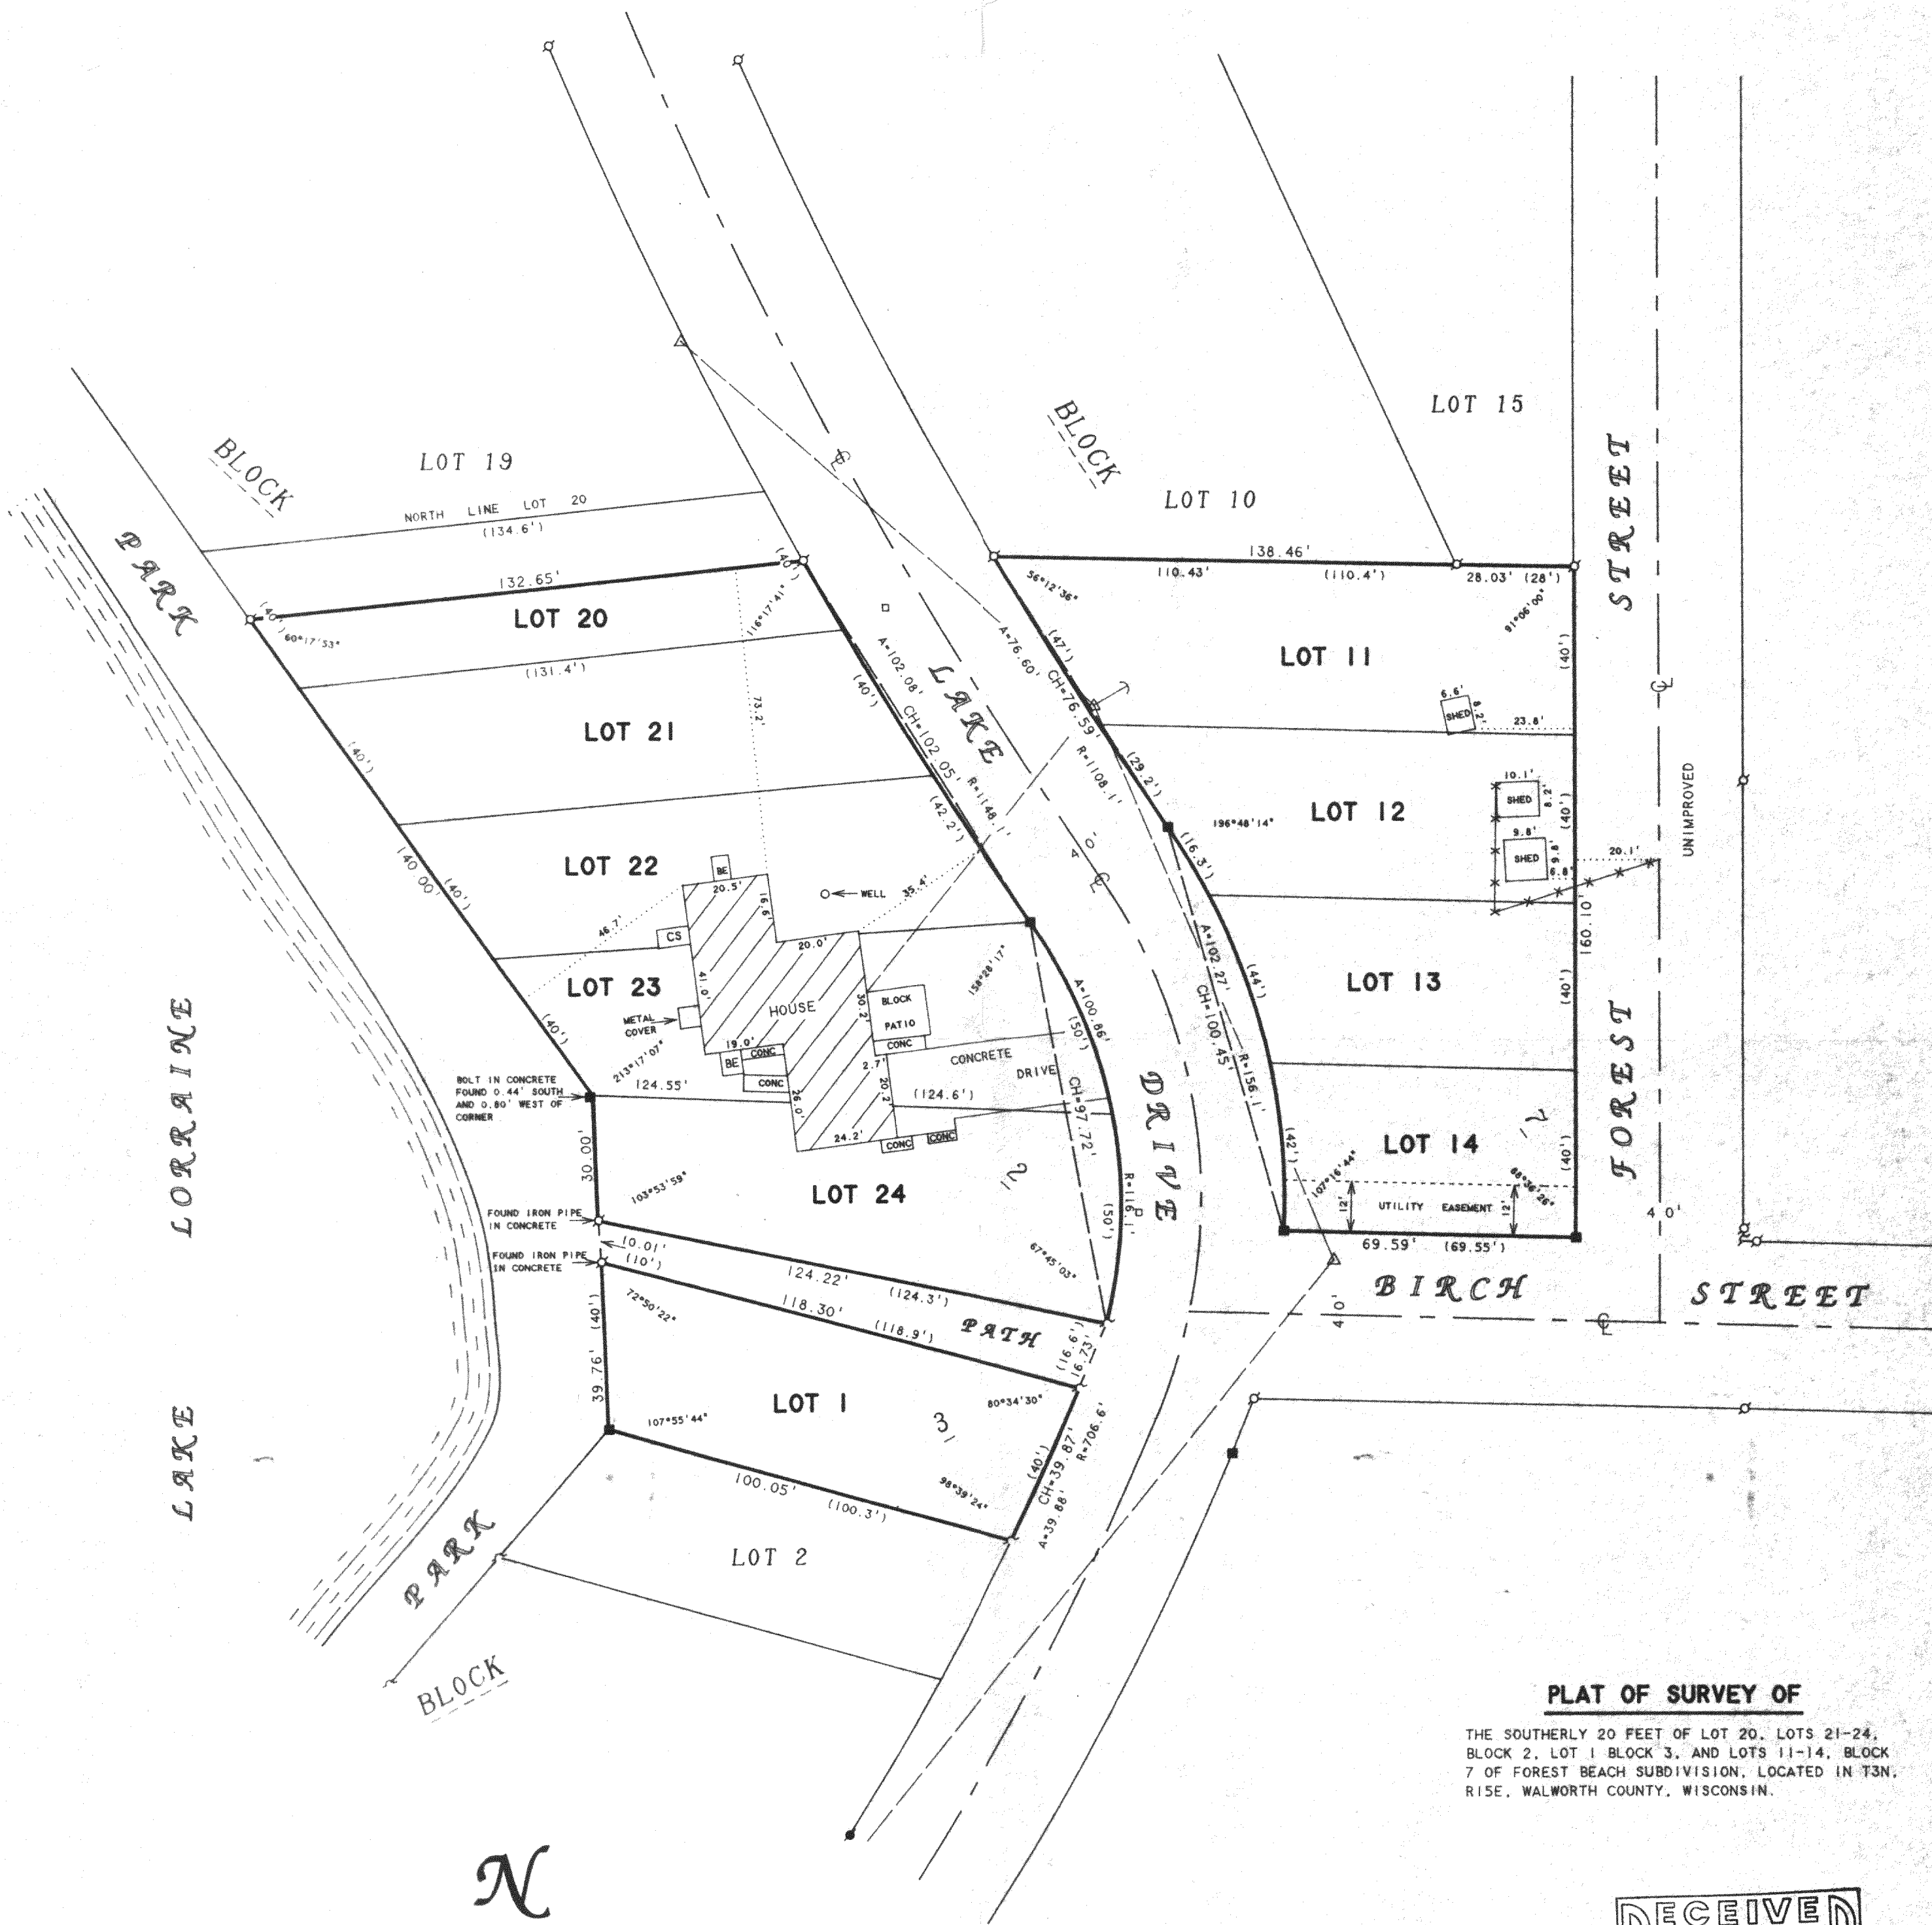

SCALE 1"=30'

LEGEND

- - IRON PIPE FOUND
- - IRON ROD FOUND
- - CONCRETE MONUMENT FOUND
- ⋈ - POSEY PIN FOUND
- BE - BASEMENT ENTRY
- CS - CONCRETE STOOP
- △ - UTILITY POLE
- GUY WIRE
- OVERHEAD UTILITY LINES
- - UTILITY PED
- SNOW FENCE
- () - RECORDED AS

ORDERED BY: TINCER REALTY
514 WEST MAIN STREET
WHITEWATER, WI 53190

I HEREBY CERTIFY THAT I HAVE SURVEYED THE ABOVE DESCRIBED PROPERTY AND THAT THE ABOVE MAP IS A TRUE REPRESENTATION THEREOF AND SHOWS THE SIZE AND LOCATION OF THE PROPERTY, ITS EXTERIOR BOUNDARIES, THE LOCATION OF ALL VISIBLE STRUCTURES AND DIMENSIONS OF ALL PRINCIPAL BUILDINGS THEREON, BOUNDARY FENCES, APPARENT EASEMENTS, ROADWAYS AND VISIBLE ENCROACHMENTS, IF ANY, TO THE BEST OF MY KNOWLEDGE AND BELIEF.

THIS SURVEY IS MADE FOR THE USE OF THE PRESENT OWNERS OF THE PROPERTY, AND ALSO THOSE WHO PURCHASE, MORTGAGE, OR GUARANTEE THE TITLE THERETO WITHIN ONE (1) YEAR FROM DATE HEREON.

David F. Abell
DAVID F. ABELL
WISCONSIN REGISTERED LAND SURVEYOR, S-1596

October 15, 1993

DATE: JOB NUMBER - 93211

NOTE: THIS IS NOT A CERTIFIED COPY UNLESS SEALED.

