


PLAT OF SURVEY


LOTS 10 - 14 INCLUSIVE OF
BLOCK 9 OF SKANSEN SWEDISH
TRIBUNE NEWS SUBDIVISION,
LOCATED IN SECTION 9, TOWN 3
NORTH, RANGE 15 EAST,
WALWORTH COUNTY, WISCONSIN.

CURRENT OWNER: CHESTER AND IRENE GROBELNY
8353 FIELDCREST
WILLOW SPRINGS, IL. 60380

BUYER: TONY S. HENRY
P.O. BOX 342
PALMYRA, WI. 53156

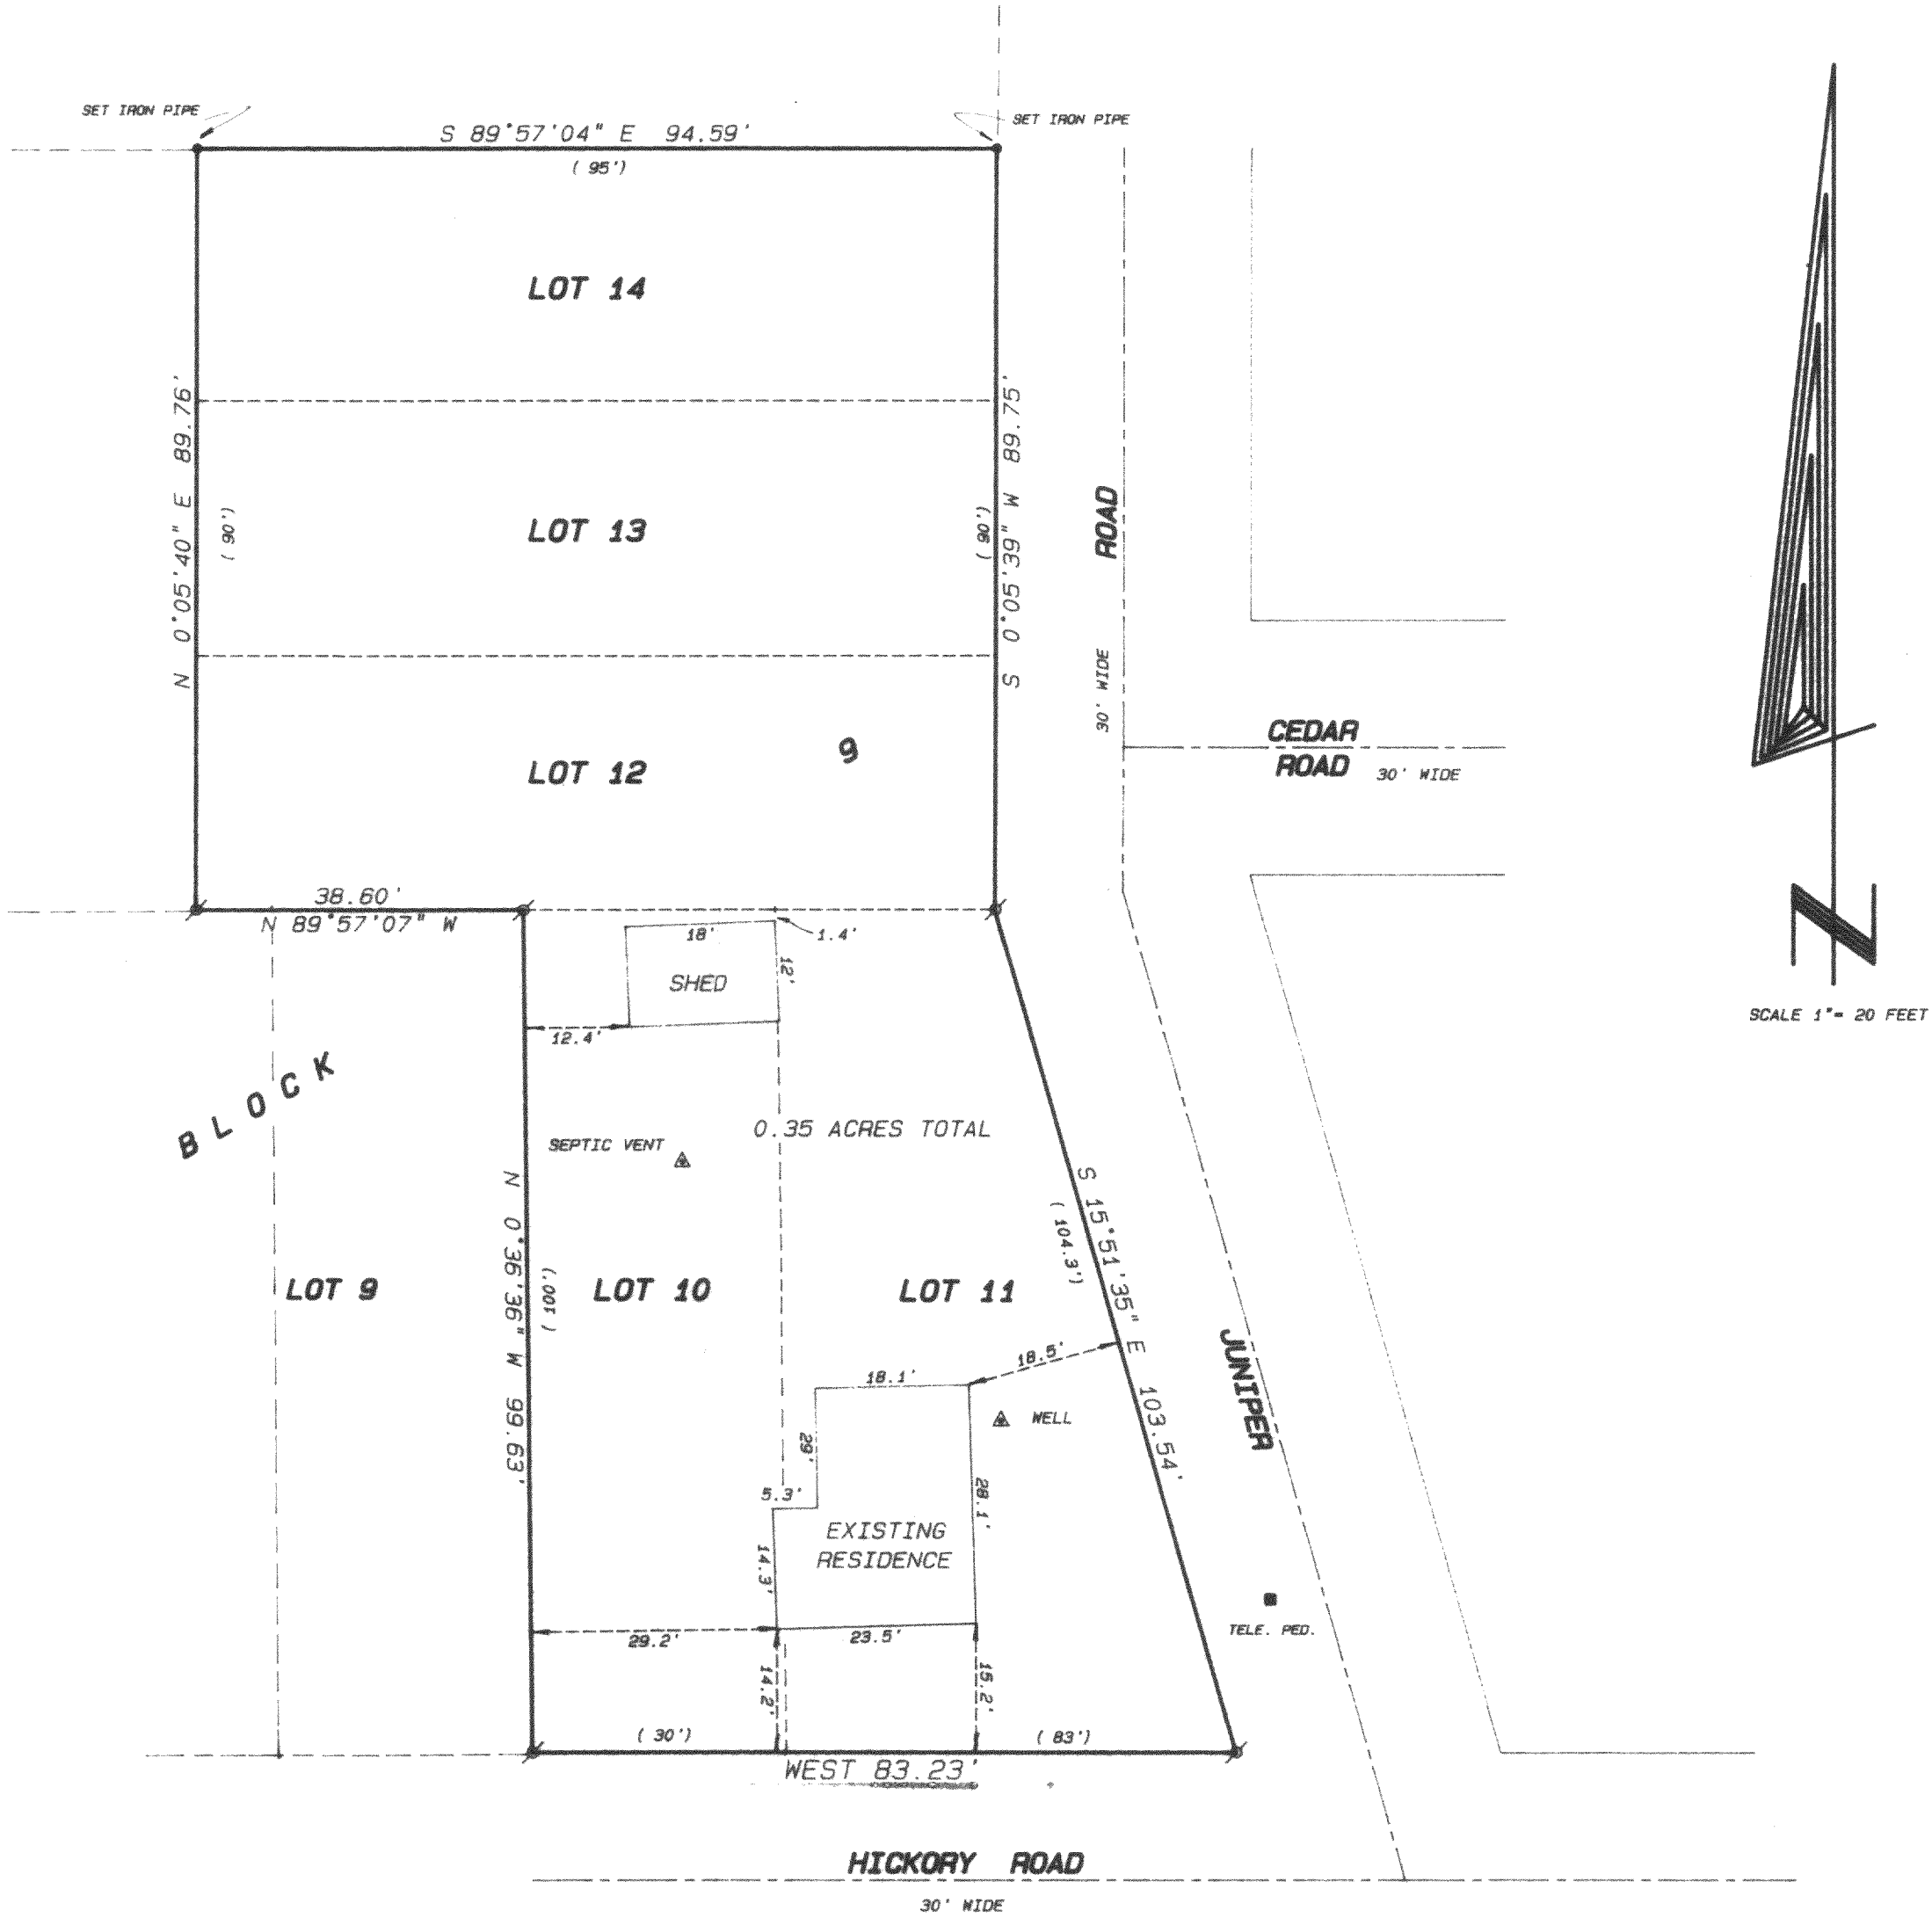

- Legend
- FOUND IRON PIPE
 - FOUND IRON ROD
 - FOUND BRASS CAPPED MONUMENT
 - FOUND CONCRETE MONUMENT
 - CHISEL CUT IN CONCRETE
 - SET IRON ROD, 24" LONG, WEIGHING 1.5 LBS./LINEAL FT., 3/8" DIA.
 - SET IRON ROD, 30" LONG, WEIGHING 4.5 LBS./LINEAL FT., 1-11/16" DIA.
 - RECORDED AS DIMENSION
 - EXISTING FENCE

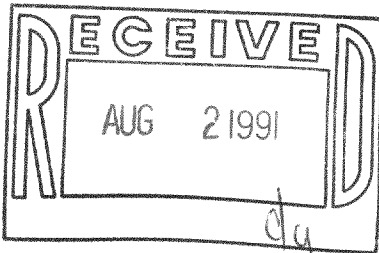

SCALE: 1" = 20 FEET

"I hereby certify that I have surveyed the above described property and that the above map is a true representation thereof and shows the size and location of the property, its exterior boundaries, the location of all visible structures and dimensions of all principal buildings thereon, boundary fences, apparent easements, roadways and visible encroachments, if any."

"This survey is made for the use of the present owners of the property, and also those who purchase, mortgage or guarantee the title thereto within one year from date hereof."

Kenneth B. Abernathy Jr.
KENNETH B. ABERNATHY, JR.
WISCONSIN REGISTERED LAND SURVEYOR,
S-1594

Date: APRIL 29, 1991 Job No. 1991.418

