


N



Realty World, Carmin Realtors
812 East Geneva Street
Delavan, WI 53115

George E. Dunham
George E. Dunham, Surveyor

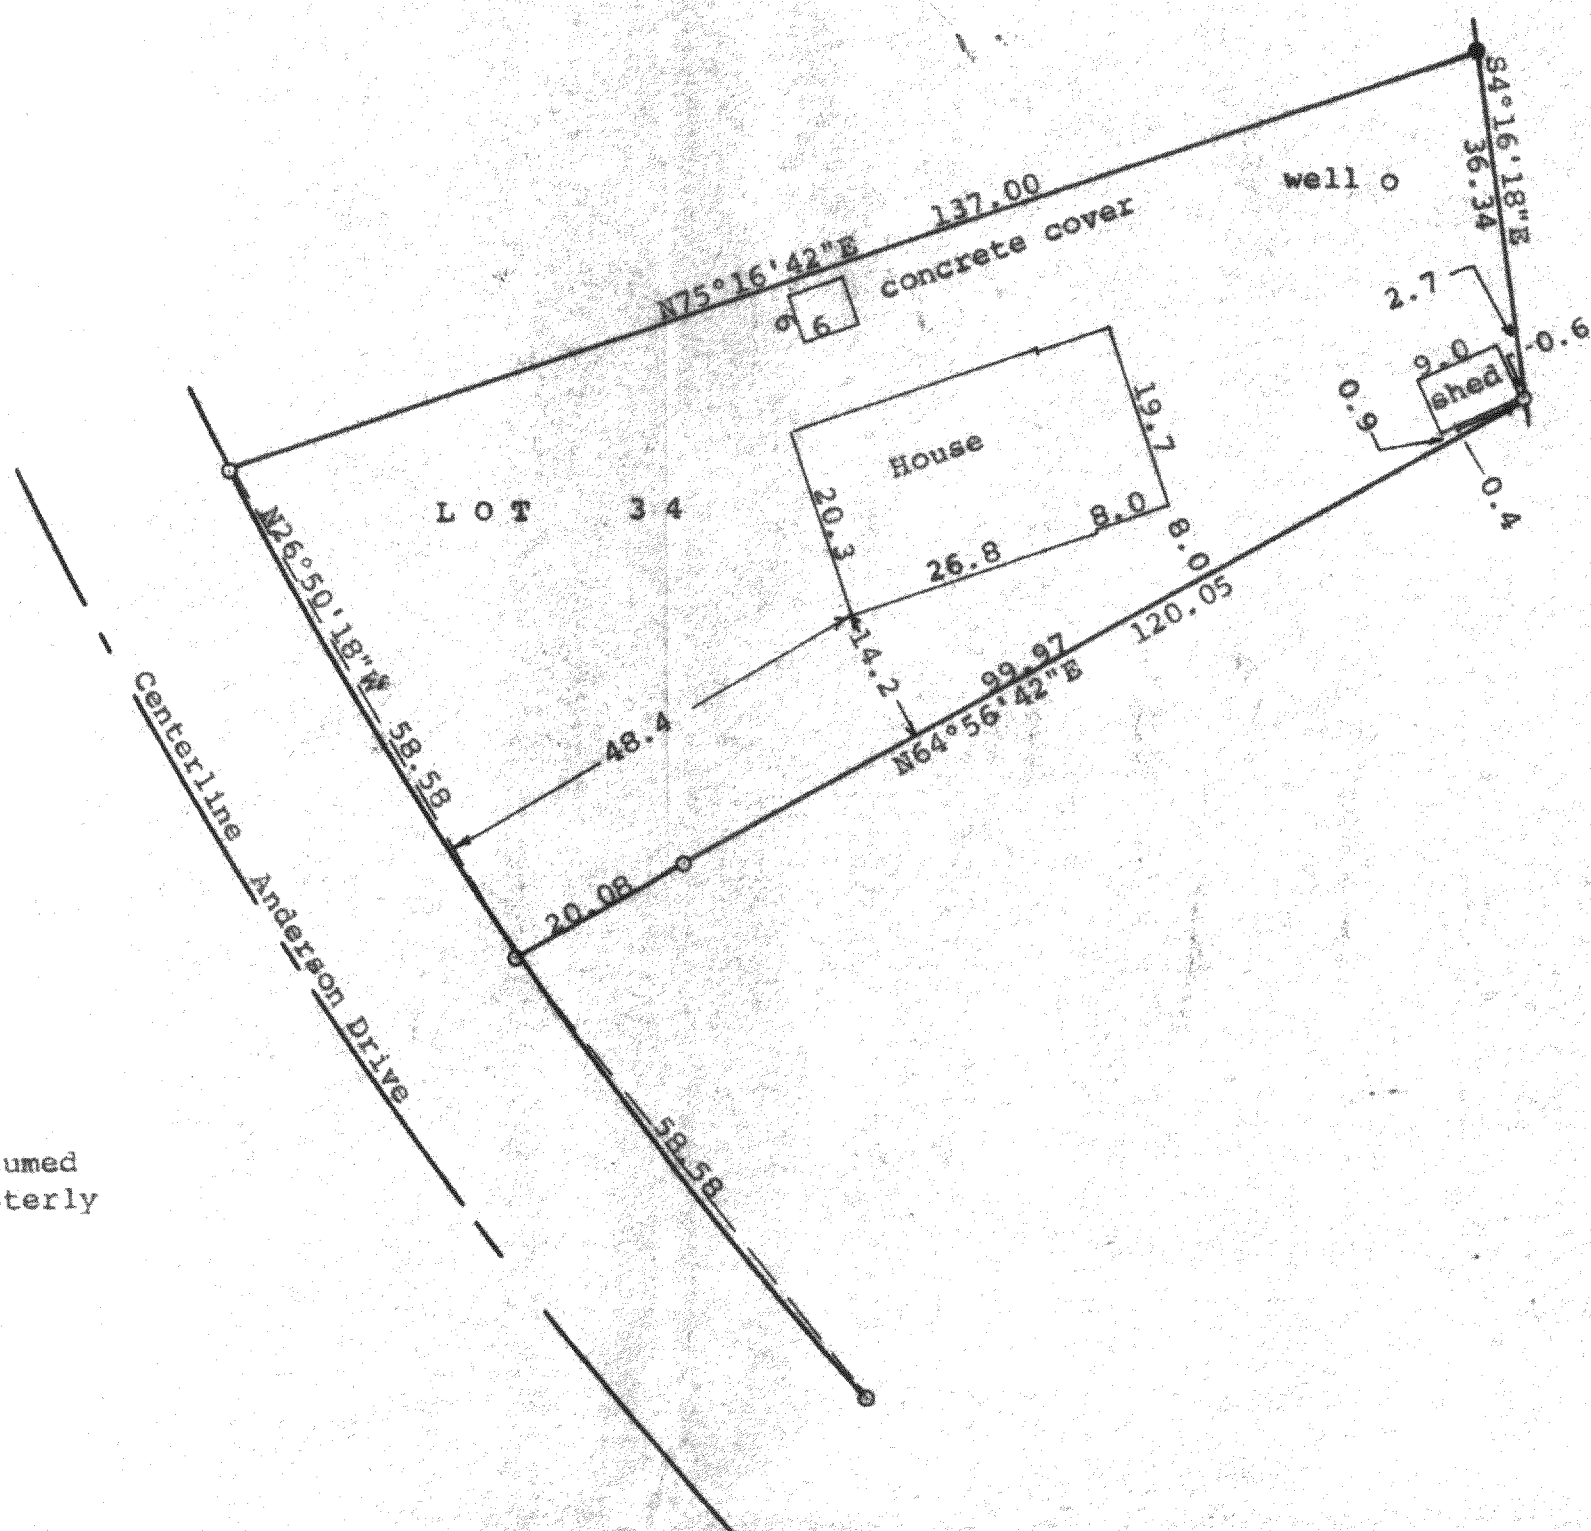