

PLAT OF SURVEY
 LOTS 1 THRU 4 & LOTS 28 THRU 31
 BLOCK 12
 FOREST BEACH SUBDIVISION
 SECTION 9, TOWN 3 NORTH, RANGE 15 EAST
 WALWORTH COUNTY, WISCONSIN

TERRITORIAL ROAD

66' W PUBLIC ROW

PLAT OF SURVEY

LOTS 1 THRU 4 & LOTS 28 THRU 31
 BLOCK 12
 FOREST BEACH SUBDIVISION
 SECTION 9, TOWN 3 NORTH, RANGE 15 EAST
 WALWORTH COUNTY, WISCONSIN


FARRIS, HANSEN & ASSOCIATES, INC.
 Engineering, Architecture, Surveying
 7 Ridgeway Court P.O. Box 437
 ELKHORN, WISCONSIN 53121
 Office: (414) 723-2098
 Fax: (414) 723-5886

REVISIONS

PROJECT NO
 3613
 DATE
 03/19/92
 SHEET NO
 2 OF 2



SOUTH LINE TERRITORIAL ROAD
 ASSIGNED BEARING N 86° 42' E

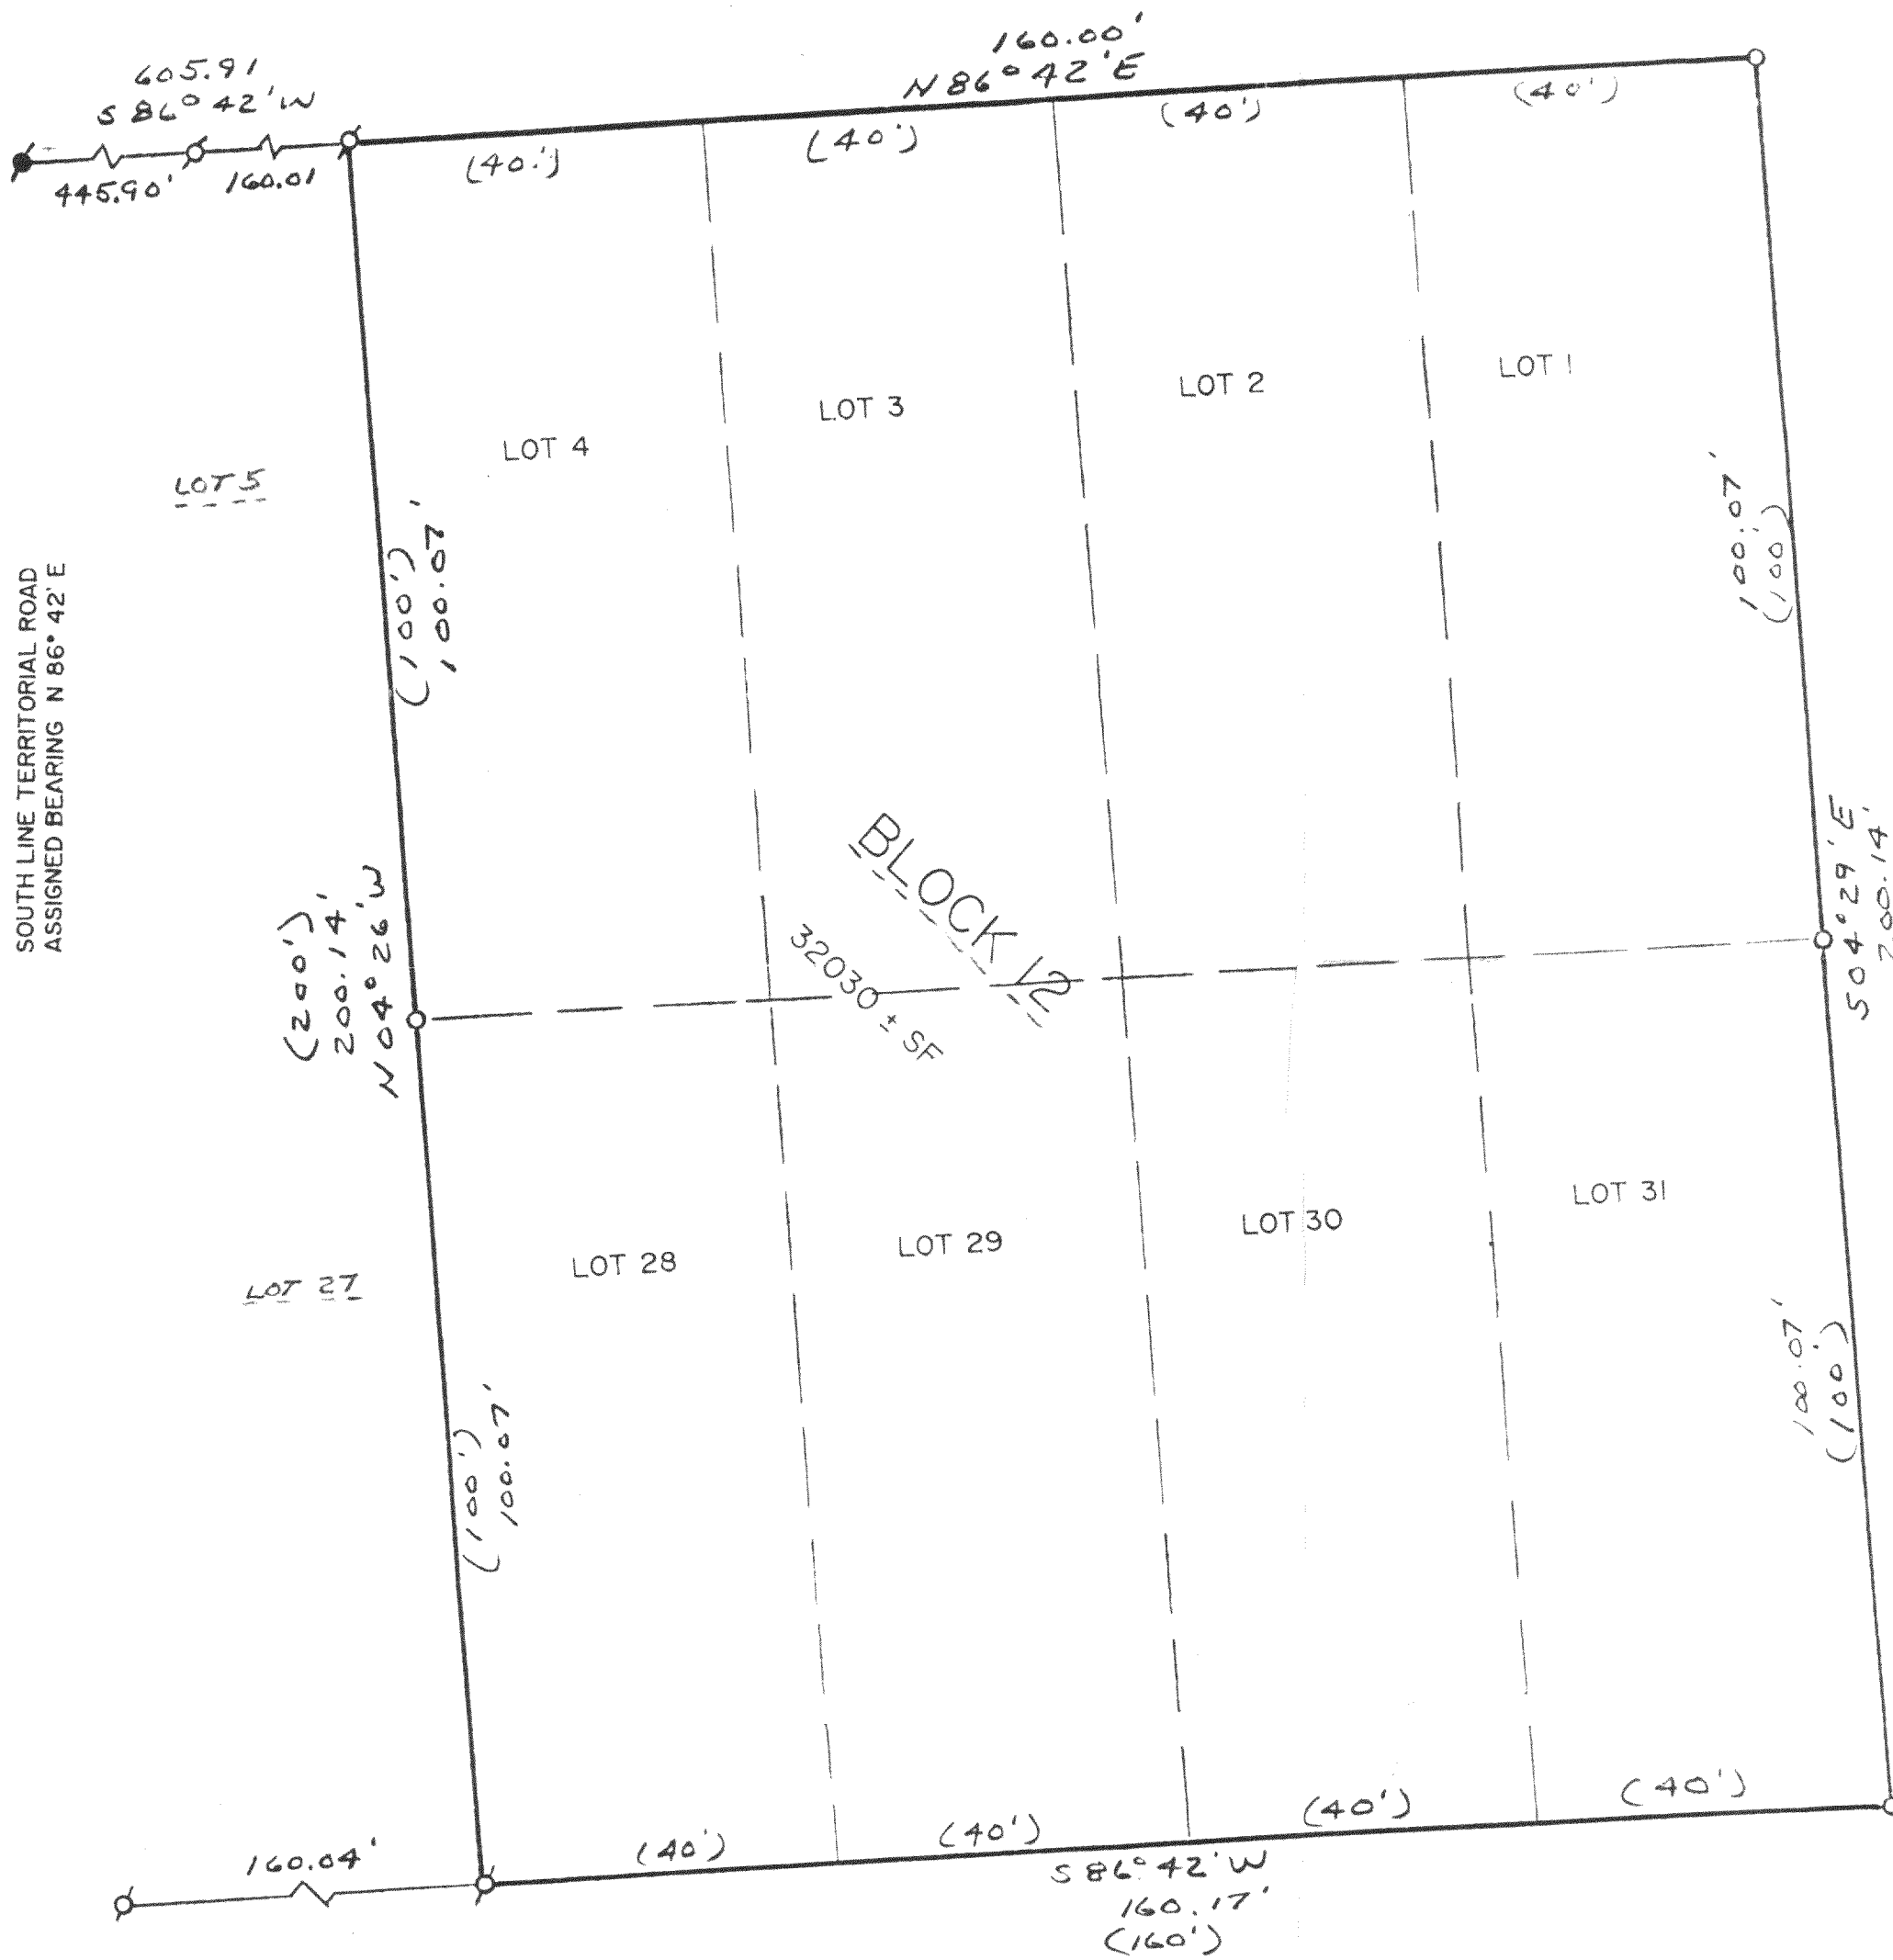

BORST STREET

40' W (NOT IMPROVED)

840.12' S 04° 29' E

200.00'

BLOCK 5

200.00'

440.12'

HICKORY STREET
 40' W (NOT IMPROVED)

LEGEND



- IRON REBAR STAKE FOUND
- IRON REBAR STAKE SET
- POZEY PIN FOUND
- CONCRETE COUNTY MONUMENT FOUND
- (xxx) RECORDED AS

NOTE: COPIES OF THIS MAP TO WHICH THE FOLLOWING CERTIFICATE WILL APPLY ARE BLUE LINE PRINTS SHOWING SURVEYOR'S ORIGINAL SEAL AND SIGNATURE IN BLACK INK. COPIES BY ANY OTHER MEANS MAY HAVE ALTERATIONS WHICH DO NOT REPRESENT THE SURVEYOR'S WORK PRODUCT.

I HEREBY CERTIFY THAT THIS PLAT OF SURVEY IS A TRUE AND ACCURATE REPRESENTATION OF THE BOUNDARY LINES OF THE SUBJECT PARCEL TO THE BEST OF MY KNOWLEDGE AND BELIEF. THIS SURVEY IS MADE FOR THE USE OF THE PRESENT OWNERS OF THE PROPERTY, AND ALSO THOSE WHO PURCHASE, MORTGAGE, OR GUARANTEE THE TITLE THERETO WITHIN ONE YEAR FROM THE DATE HEREOF.

DATED: MARCH 23, 1992

Peter S. Gordon
 PETER S. GORDON RLS 2101

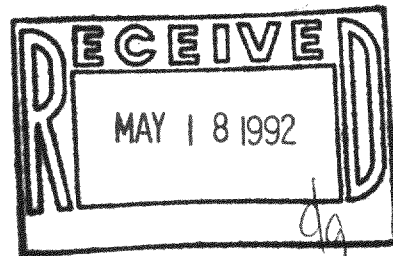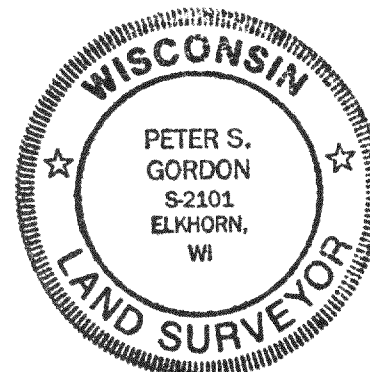

MAP SCALE IN FEET 1" = 20'

WORK ORDERED BY: JAY MYERS

CFB-73
 CFB-79