


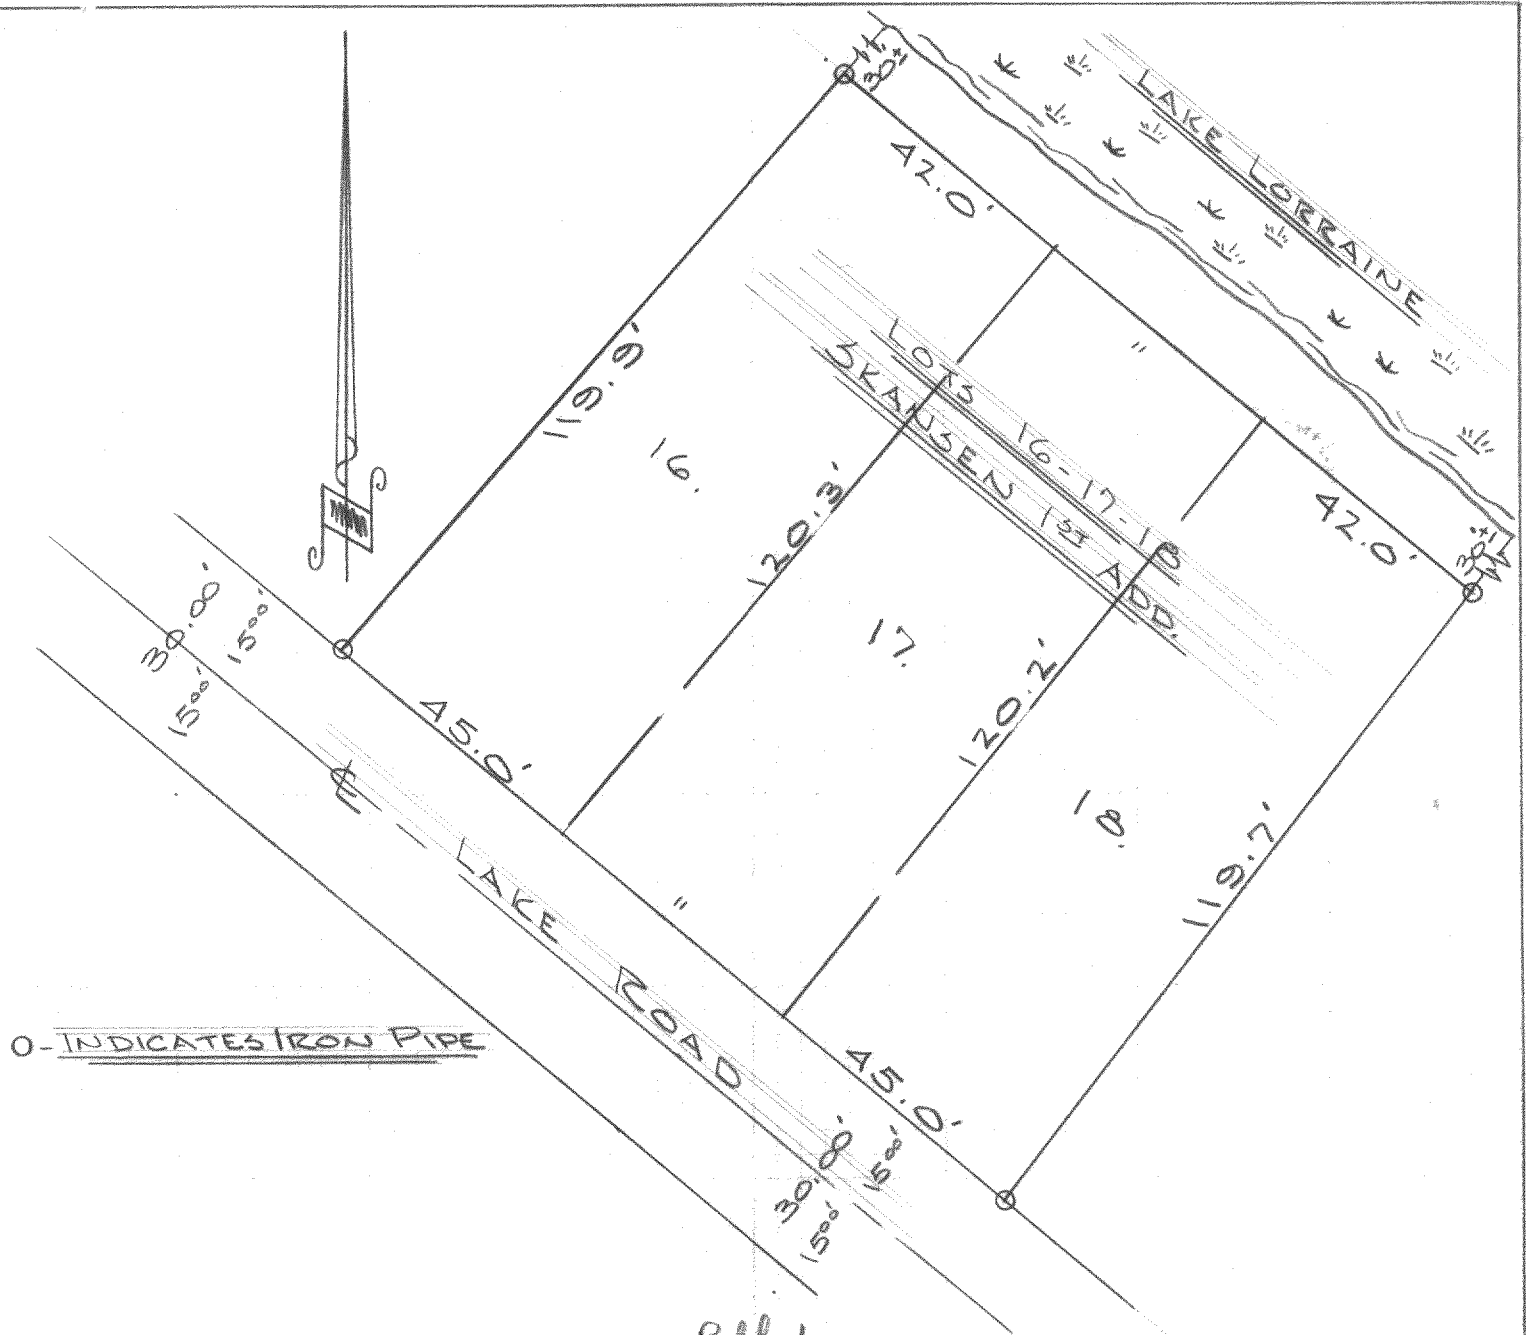

Description:

Blk 1
 Lots 16-17 & 18 of Skansen 1st Addition a subdivision located in Section 9 Town 3 north, Range 15 east, Walworth County, Wisconsin.

CERTIFICATE:

I, James F. Biagi, surveyor, do hereby certify that I have surveyed the property hereon described.

James F. Biagi
 James F. Biagi RLS 272
 Elkhorn, Wisconsin.

Date: March 30th 1970.

