


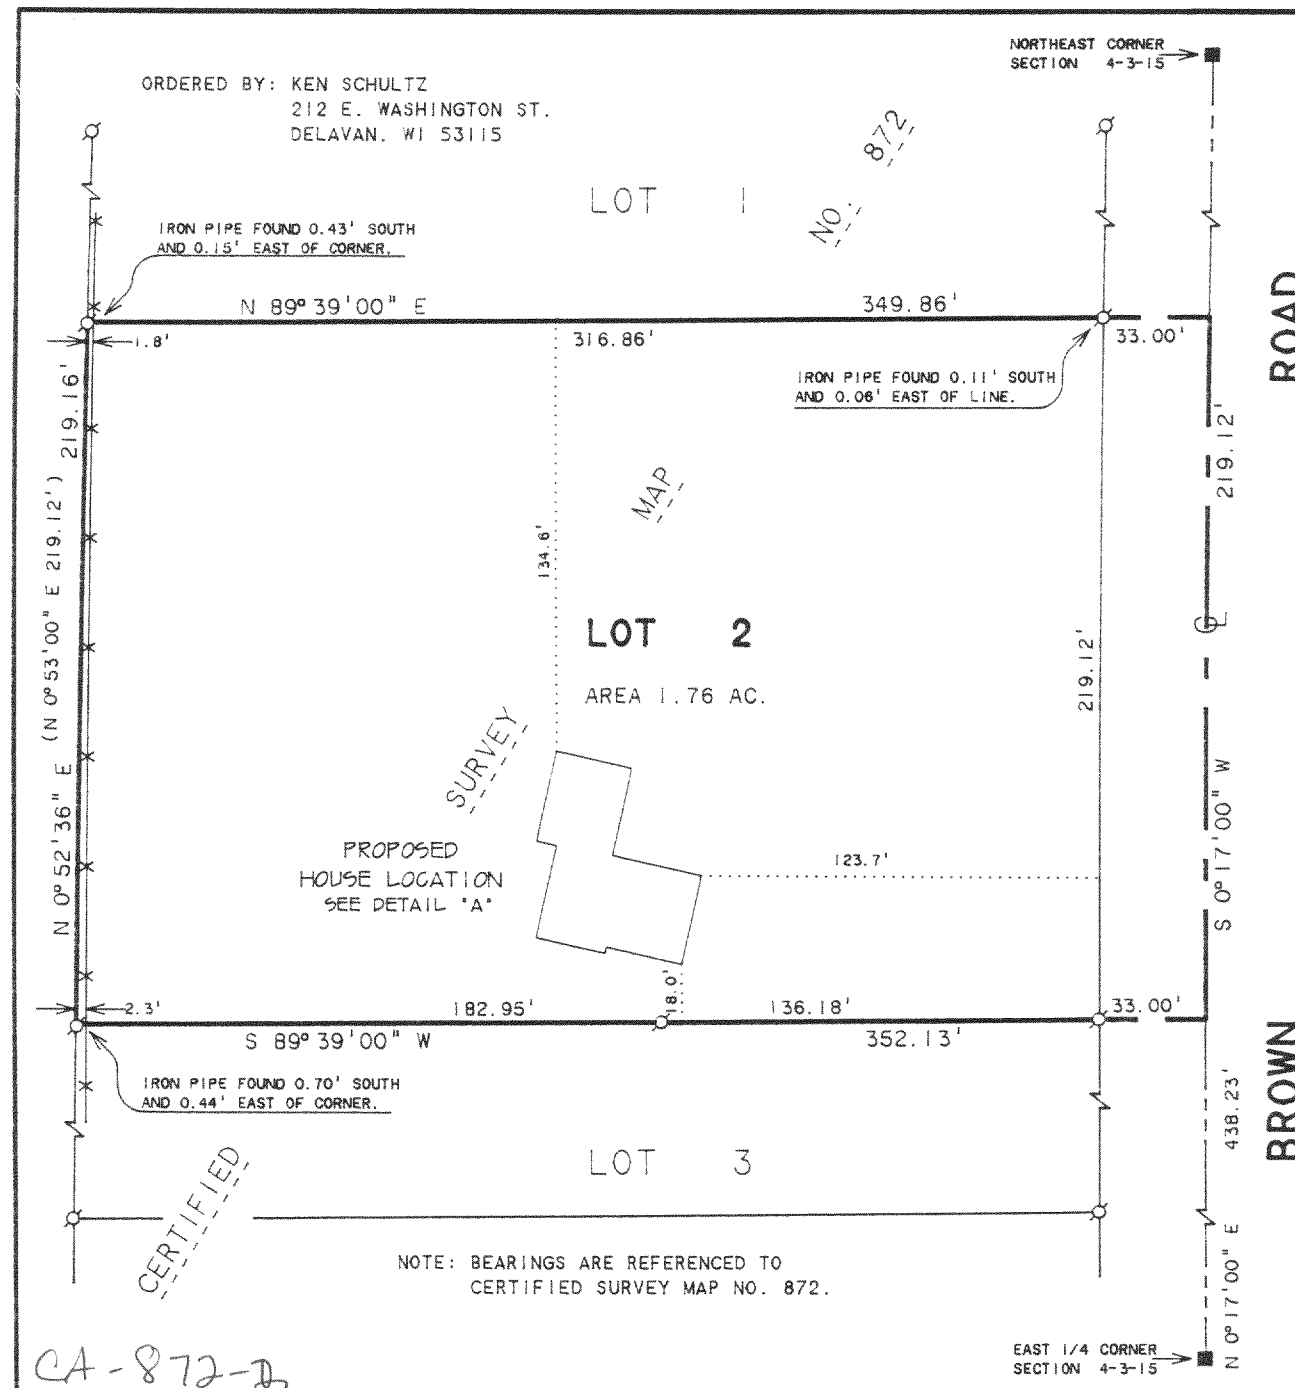

ABELL
SURVEYING & MAPPING
DELAVAN, WISCONSIN 53115
414-728-6737

PLAT OF SURVEY OF

LOT 2, CERTIFIED SURVEY MAP
NO. 872, LOCATED IN T3N, R15E,
WALWORTH COUNTY, WISCONSIN.

SCALE 1"=60'

LEGEND

- - IRON PIPE FOUND
- - CONCRETE MONUMENT FOUND
- x - 60d SPIKE SET
- - - WIRE FENCE
- () - RECORDED AS

