



**ABELL
SURVEYING & MAPPING**
DEHAVAN, WISCONSIN 53115
414-728-6737

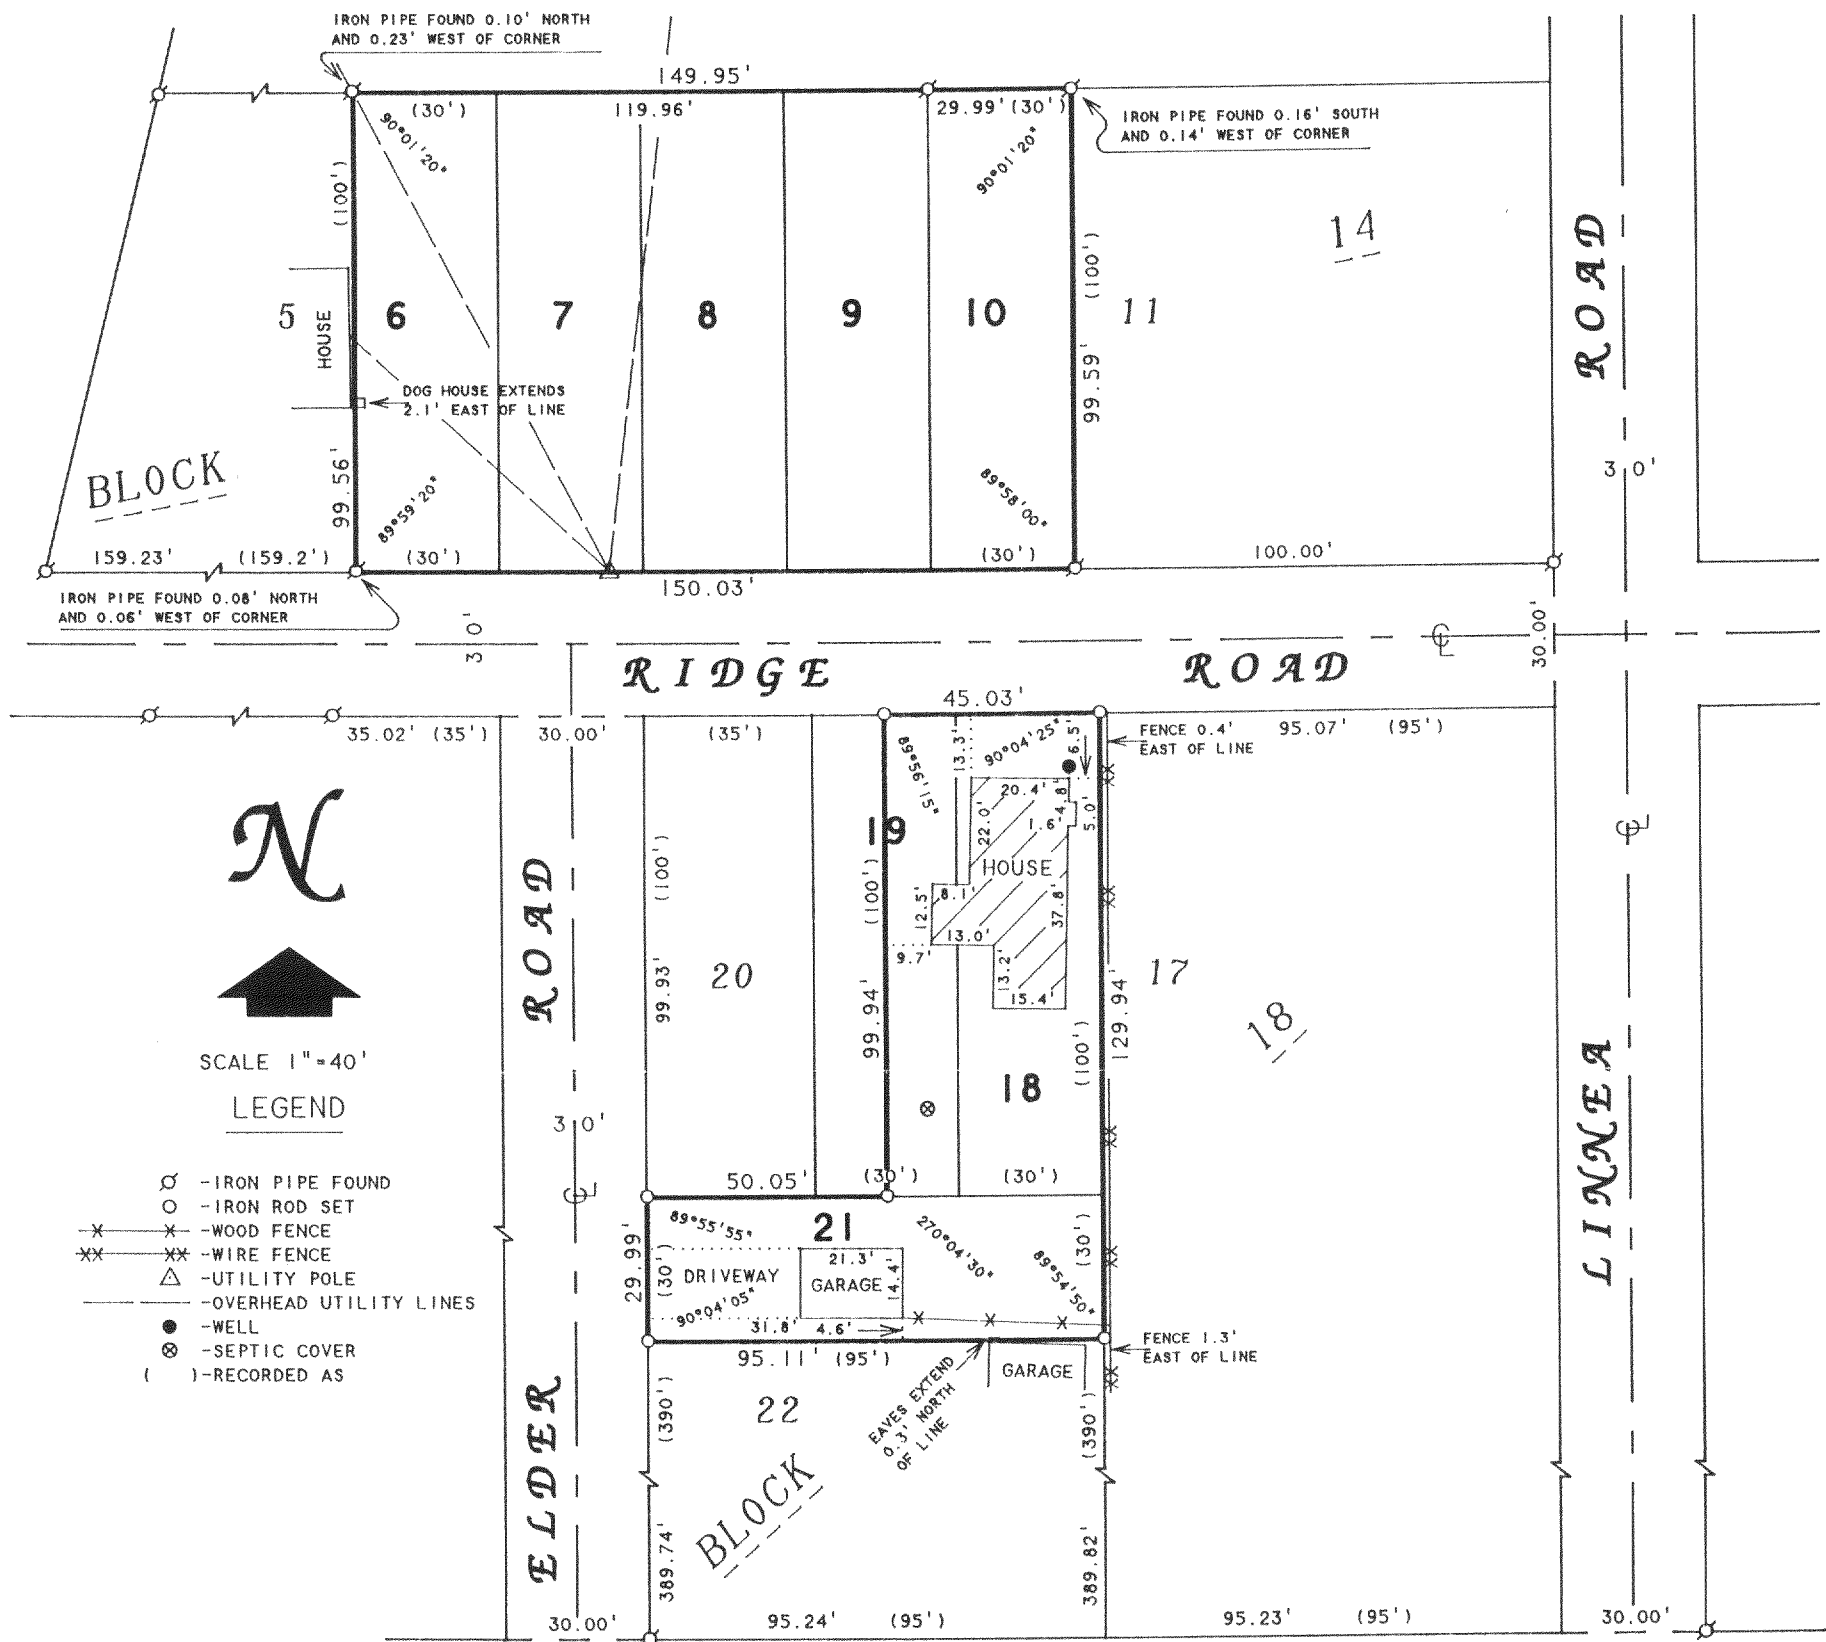

N
↑
SCALE 1" = 40'
LEGEND

- - IRON PIPE FOUND
- - IRON ROD SET
- X-X- - WOOD FENCE
- XX-XX- - WIRE FENCE
- △ - UTILITY POLE
- - OVERHEAD UTILITY LINES
- - WELL
- ⊗ - SEPTIC COVER
- () - RECORDED AS

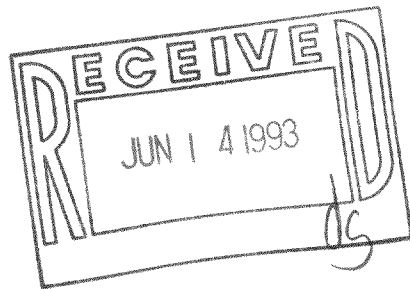

PLAT OF SURVEY OF

LOTS 6 - 10, BLOCK 14, LOT 18 AND
THE EAST 1/2 OF LOT 19, LOT 21,
BLOCK 18 OF SKANSEN SWEDISH TRIBUNE
NEWS SUBDIVISION, LOCATED IN T3N,
R15E, WALWORTH COUNTY, WISCONSIN.

ORDERED BY: CENTURY 21 - WALTON REALTY
202 EAST MAIN STREET
WHITEWATER, WI. 53190

I HEREBY CERTIFY THAT I HAVE SURVEYED THE ABOVE DESCRIBED PROPERTY AND THAT THE ABOVE MAP IS A TRUE REPRESENTATION THEREOF AND SHOWS THE SIZE AND LOCATION OF THE PROPERTY, ITS EXTERIOR BOUNDARIES, THE LOCATION OF ALL VISIBLE STRUCTURES AND DIMENSIONS OF ALL PRINCIPAL BUILDINGS THEREON, BOUNDARY FENCES, APPARENT EASEMENTS, ROADWAYS AND VISIBLE ENCROACHMENTS, IF ANY, TO THE BEST OF MY KNOWLEDGE AND BELIEF.

THIS SURVEY IS MADE FOR THE USE OF THE PRESENT OWNERS OF THE PROPERTY, AND ALSO THOSE WHO PURCHASE, MORTGAGE, OR GUARANTEE THE TITLE THERETO WITHIN ONE (1) YEAR FROM DATE HEREON.

David F. Abell

DAVID F. ABELL
WISCONSIN REGISTERED LAND SURVEYOR, S-1596

March 11, 1993

DATE: March 11, 1993 JOB NUMBER - 93030
NOTE: THIS IS NOT A CERTIFIED COPY UNLESS SEALED.

CS-227
CS-312
CS-314

315-384