
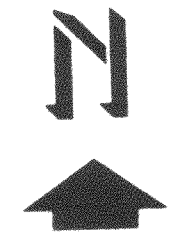


ABELL
SURVEYING & MAPPING
DELAVER, WISCONSIN 53115
414-728-6737

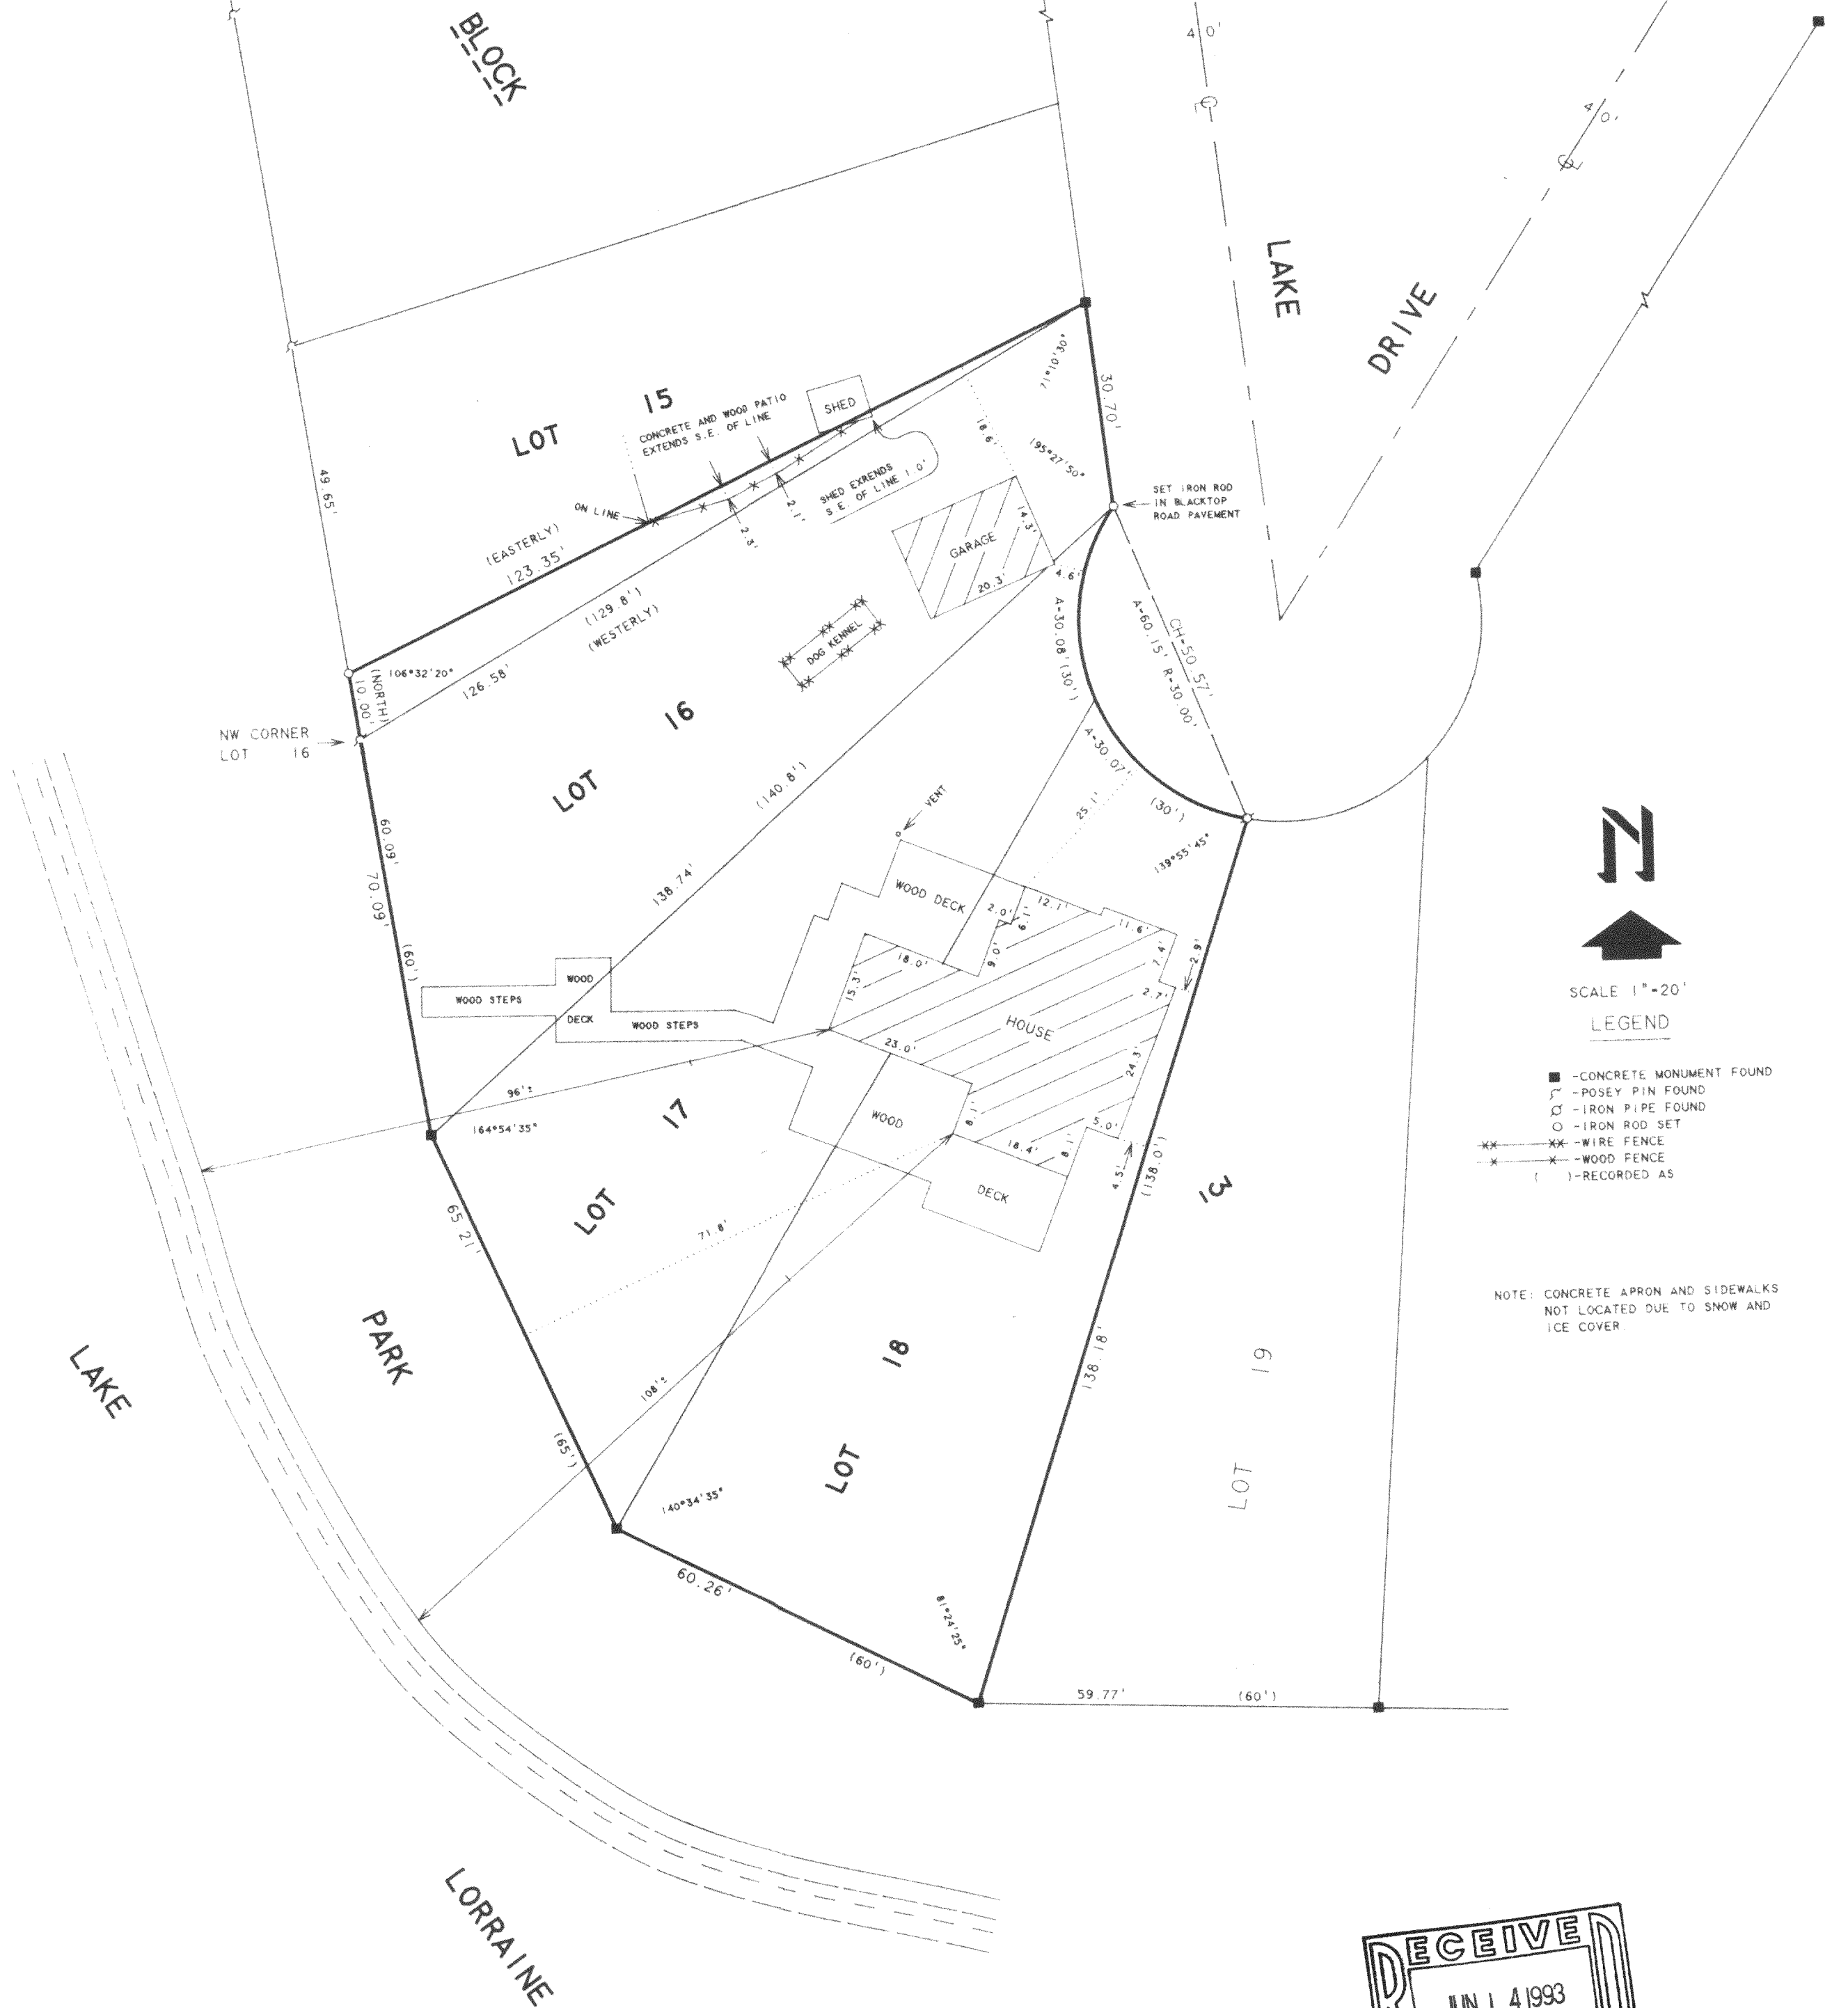


SCALE 1"=20'

LEGEND

- - CONCRETE MONUMENT FOUND
- - POSEY PIN FOUND
- - IRON PIPE FOUND
- - IRON ROD SET
- - WIRE FENCE
- - WOOD FENCE
- () - RECORDED AS

NOTE: CONCRETE APRON AND SIDEWALKS
NOT LOCATED DUE TO SNOW AND
ICE COVER

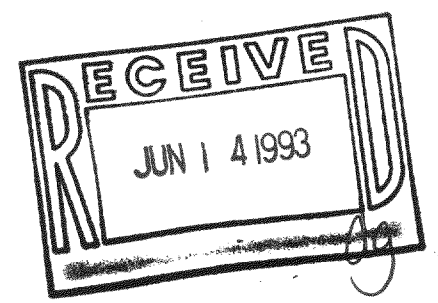

PLAT OF SURVEY OF

LOTS 16, 17, AND 18, BLOCK 3, FOREST BEACH, A SUBDIVISION
IN THE NORTHWEST 1/4 OF SECTION 9, TOWN 3 NORTH, RANGE 15
EAST, TOWN OF RICHMOND, COUNTY OF WALWORTH, STATE OF WISCONSIN.
ALSO, A PART OF LOT 15, BLOCK 3 OF SAID FOREST BEACH DESCRIBED
AS FOLLOWS: BEGINNING AT THE NORTHWEST CORNER OF LOT 16; THENCE
RUNNING NORTH 10 FEET ALONG THE WESTERLY LINE OF LOT 15; THENCE
EASTERLY TO THE NORTHEAST CORNER OF LOT 16; THENCE WESTERLY
ALONG THE NORTH LINE OF LOT 16 TO THE POINT OF BEGINNING.

I HEREBY CERTIFY THAT I HAVE SURVEYED THE ABOVE DESCRIBED PROPERTY AND THAT THE
ABOVE MAP IS A TRUE REPRESENTATION THEREOF AND SHOWS THE SIZE AND LOCATION OF
THE PROPERTY, ITS EXTERIOR BOUNDARIES, THE LOCATION OF ALL VISIBLE STRUCTURES
AND DIMENSIONS OF ALL PRINCIPAL BUILDINGS THEREON, BOUNDARY FENCES, APPARENT
EASEMENTS, ROADWAYS AND VISIBLE ENCROACHMENTS, IF ANY, TO THE BEST OF MY
KNOWLEDGE AND BELIEF.

THIS SURVEY IS MADE FOR THE USE OF THE PRESENT OWNERS OF THE PROPERTY, AND ALSO
THOSE WHO PURCHASE, MORTGAGE, OR GUARANTEE THE TITLE THERETO WITHIN ONE (1) YEAR
FROM DATE HEREON.

David F. Abell
DAVID F. ABELL
WISCONSIN REGISTERED LAND SURVEYOR, S-1596

February 5, 1993
DATE JOB NUMBER - 93008
NOTE: THIS IS NOT A CERTIFIED COPY UNLESS SEALED.

ORDERED BY: CENTURY 21-SKANDIA REALTY
312 S. 7th STREET
DELAVER, WI. 53115

CFB-17

315-387