


HAROLD H. KOLB
REGISTERED PROFESSIONAL LAND SURVEYOR
LAKE GENEVA, WISCONSIN

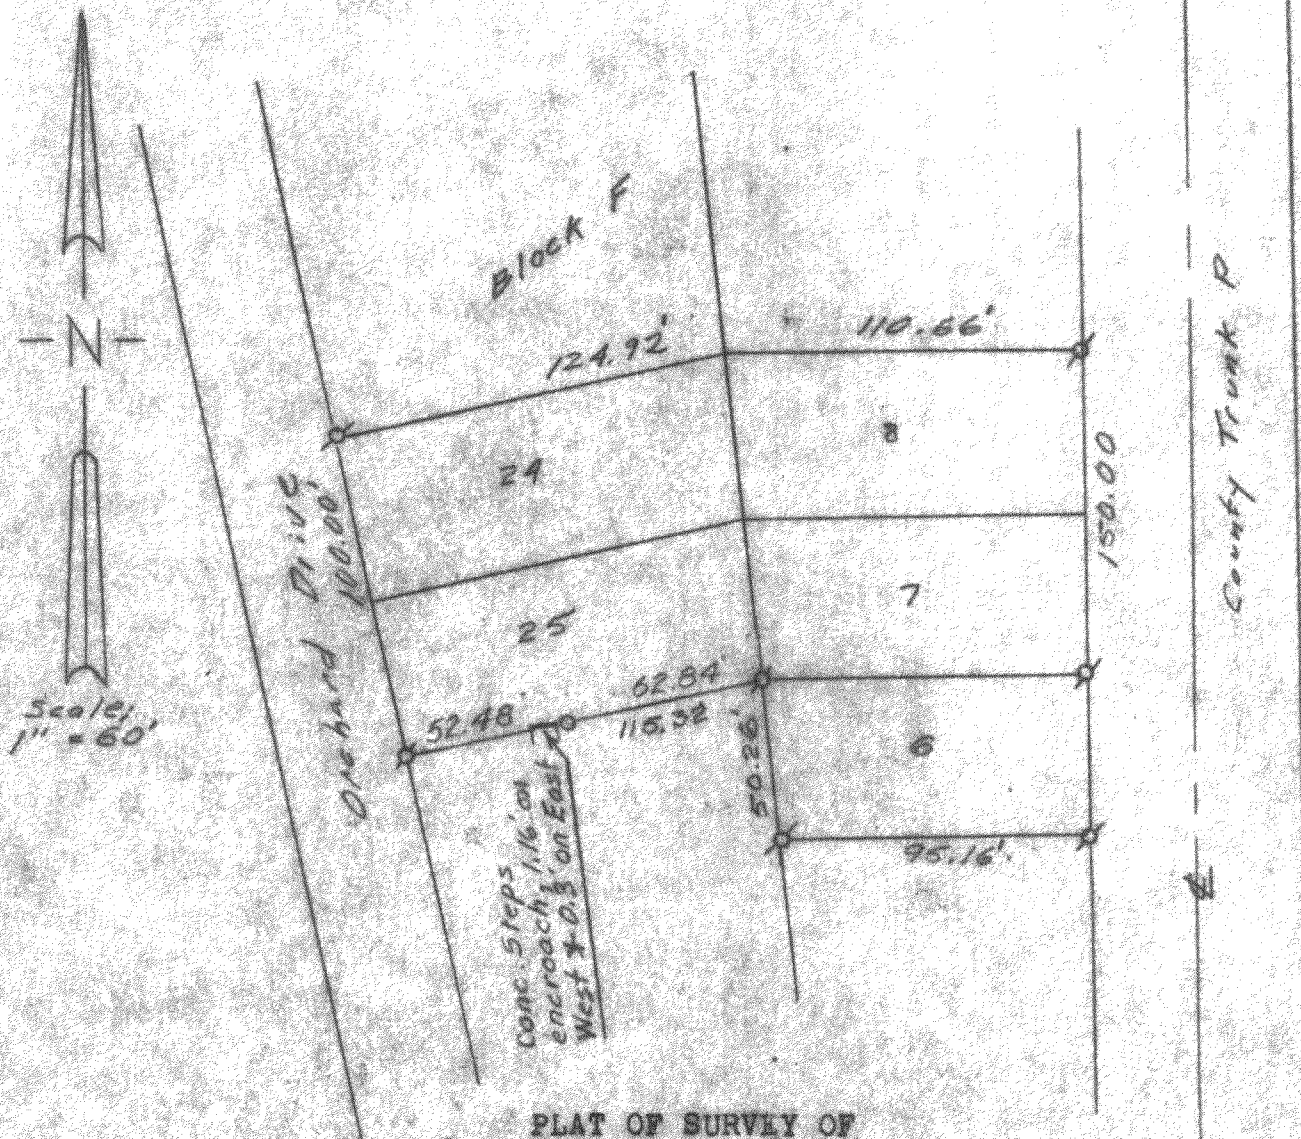

PLAT OF SURVEY OF

Lots 6-8, 24, and 25, Block F, Crystal Bowl, a subdivision located in Section 13, T 3 N, R 15 E, Walworth County, Wisconsin.

Harold H. Kolb

Harold H. Kolb, Wisconsin Surveyor, S-157

DATE: May 22, 1964.

X Iron Pipe Found
O Iron Pipe Placed

CCR-101
" 111

315-541