

PLAT OF SURVEY

OF LOTS 4 AND 5, BLOCK 14, SKANSEN
SWEDISH TRIBUNE NEWS SUBDIVISION-SOUTH PART- LOCATED IN THE SW $\frac{1}{4}$ OF SECTION 9, T3N, R15E,
TOWN OF RICHMOND, WALWORTH COUNTY, WISCONSIN.


SURVEYOR'S CERTIFICATE

I hereby certify that a field survey was conducted on the lots shown hereon under my direction and control and that this map is a true representation of the field survey made and is correct to the best of my knowledge and belief.

Dated this 13th day of MAY, 1994.


Glen L. Northrop
Glen L. Northrop S-982

This survey was ordered by Edward A. Lampsa, Jr.
for the owner of record, Lawrence V. Lampsa per
W.D. recorded in Vol. 155, P. 378, Doc. No. 01646
recorded March 29, 1976.

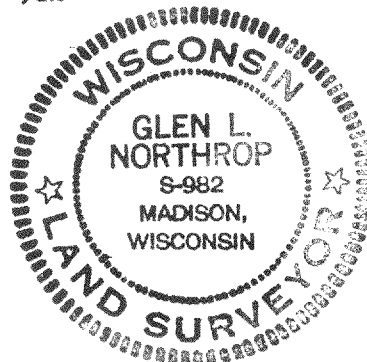


LEGEND

- Existing $\frac{1}{2}$ " I.D. pipe found unless noted different.
- () Recorded distance from original plat is shown in parenthesis.

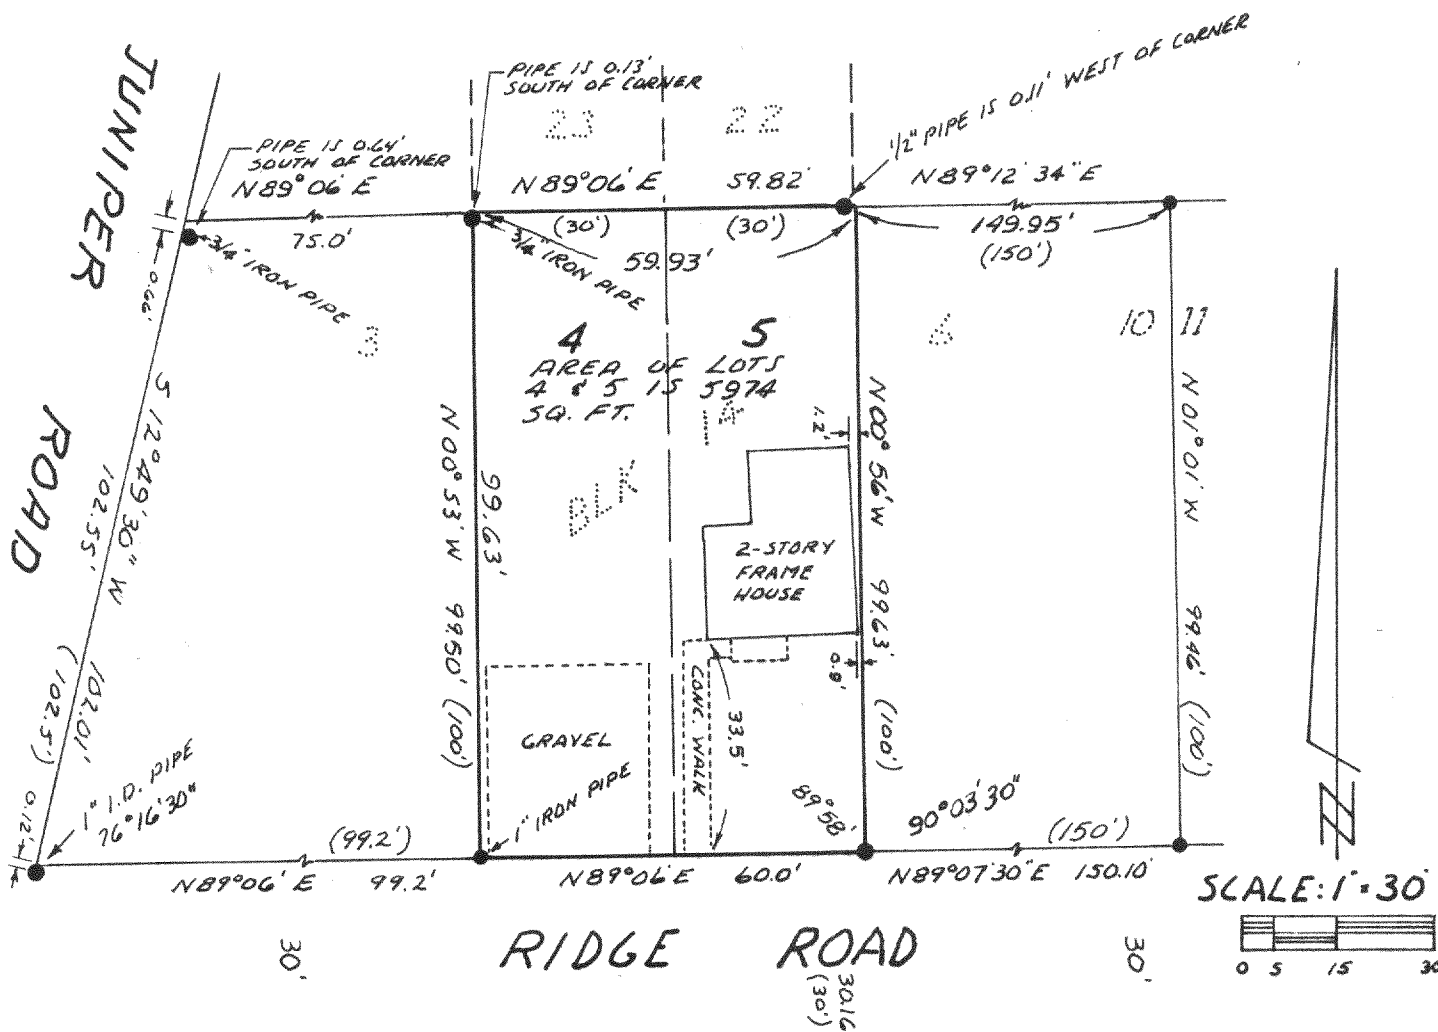

ORDER NO. AB 1952-94
Drafted at ABEX Survey Company
101 E. Main St., P.O. Box 369
Cambridge, WI 53523
TEL: 608-423-3331

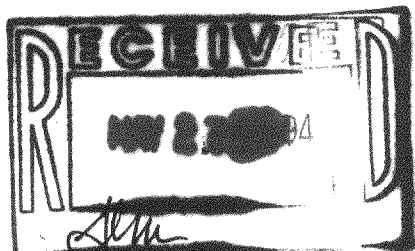

DRG. NO. 1952
SHEET 1 OF 1

ELDER
ROAD

315-429

CS-226