


PLAT OF SURVEY

of Lots 12 and 13, Block B of CRYSTAL BOWL, a subdivision of part of the Southeast Quarter of the Southwest Quarter of Section 12 and the Northeast Quarter of the Northwest Quarter of Section 13, all in Township 3 North, Range 15 East of the 4th Principal Meridian, Town of Richmond, Walworth County, Wisconsin.

AMBIT LAND SURVEYING
P.O. Box 42
Bassett, WI. 53101
414-537-4874

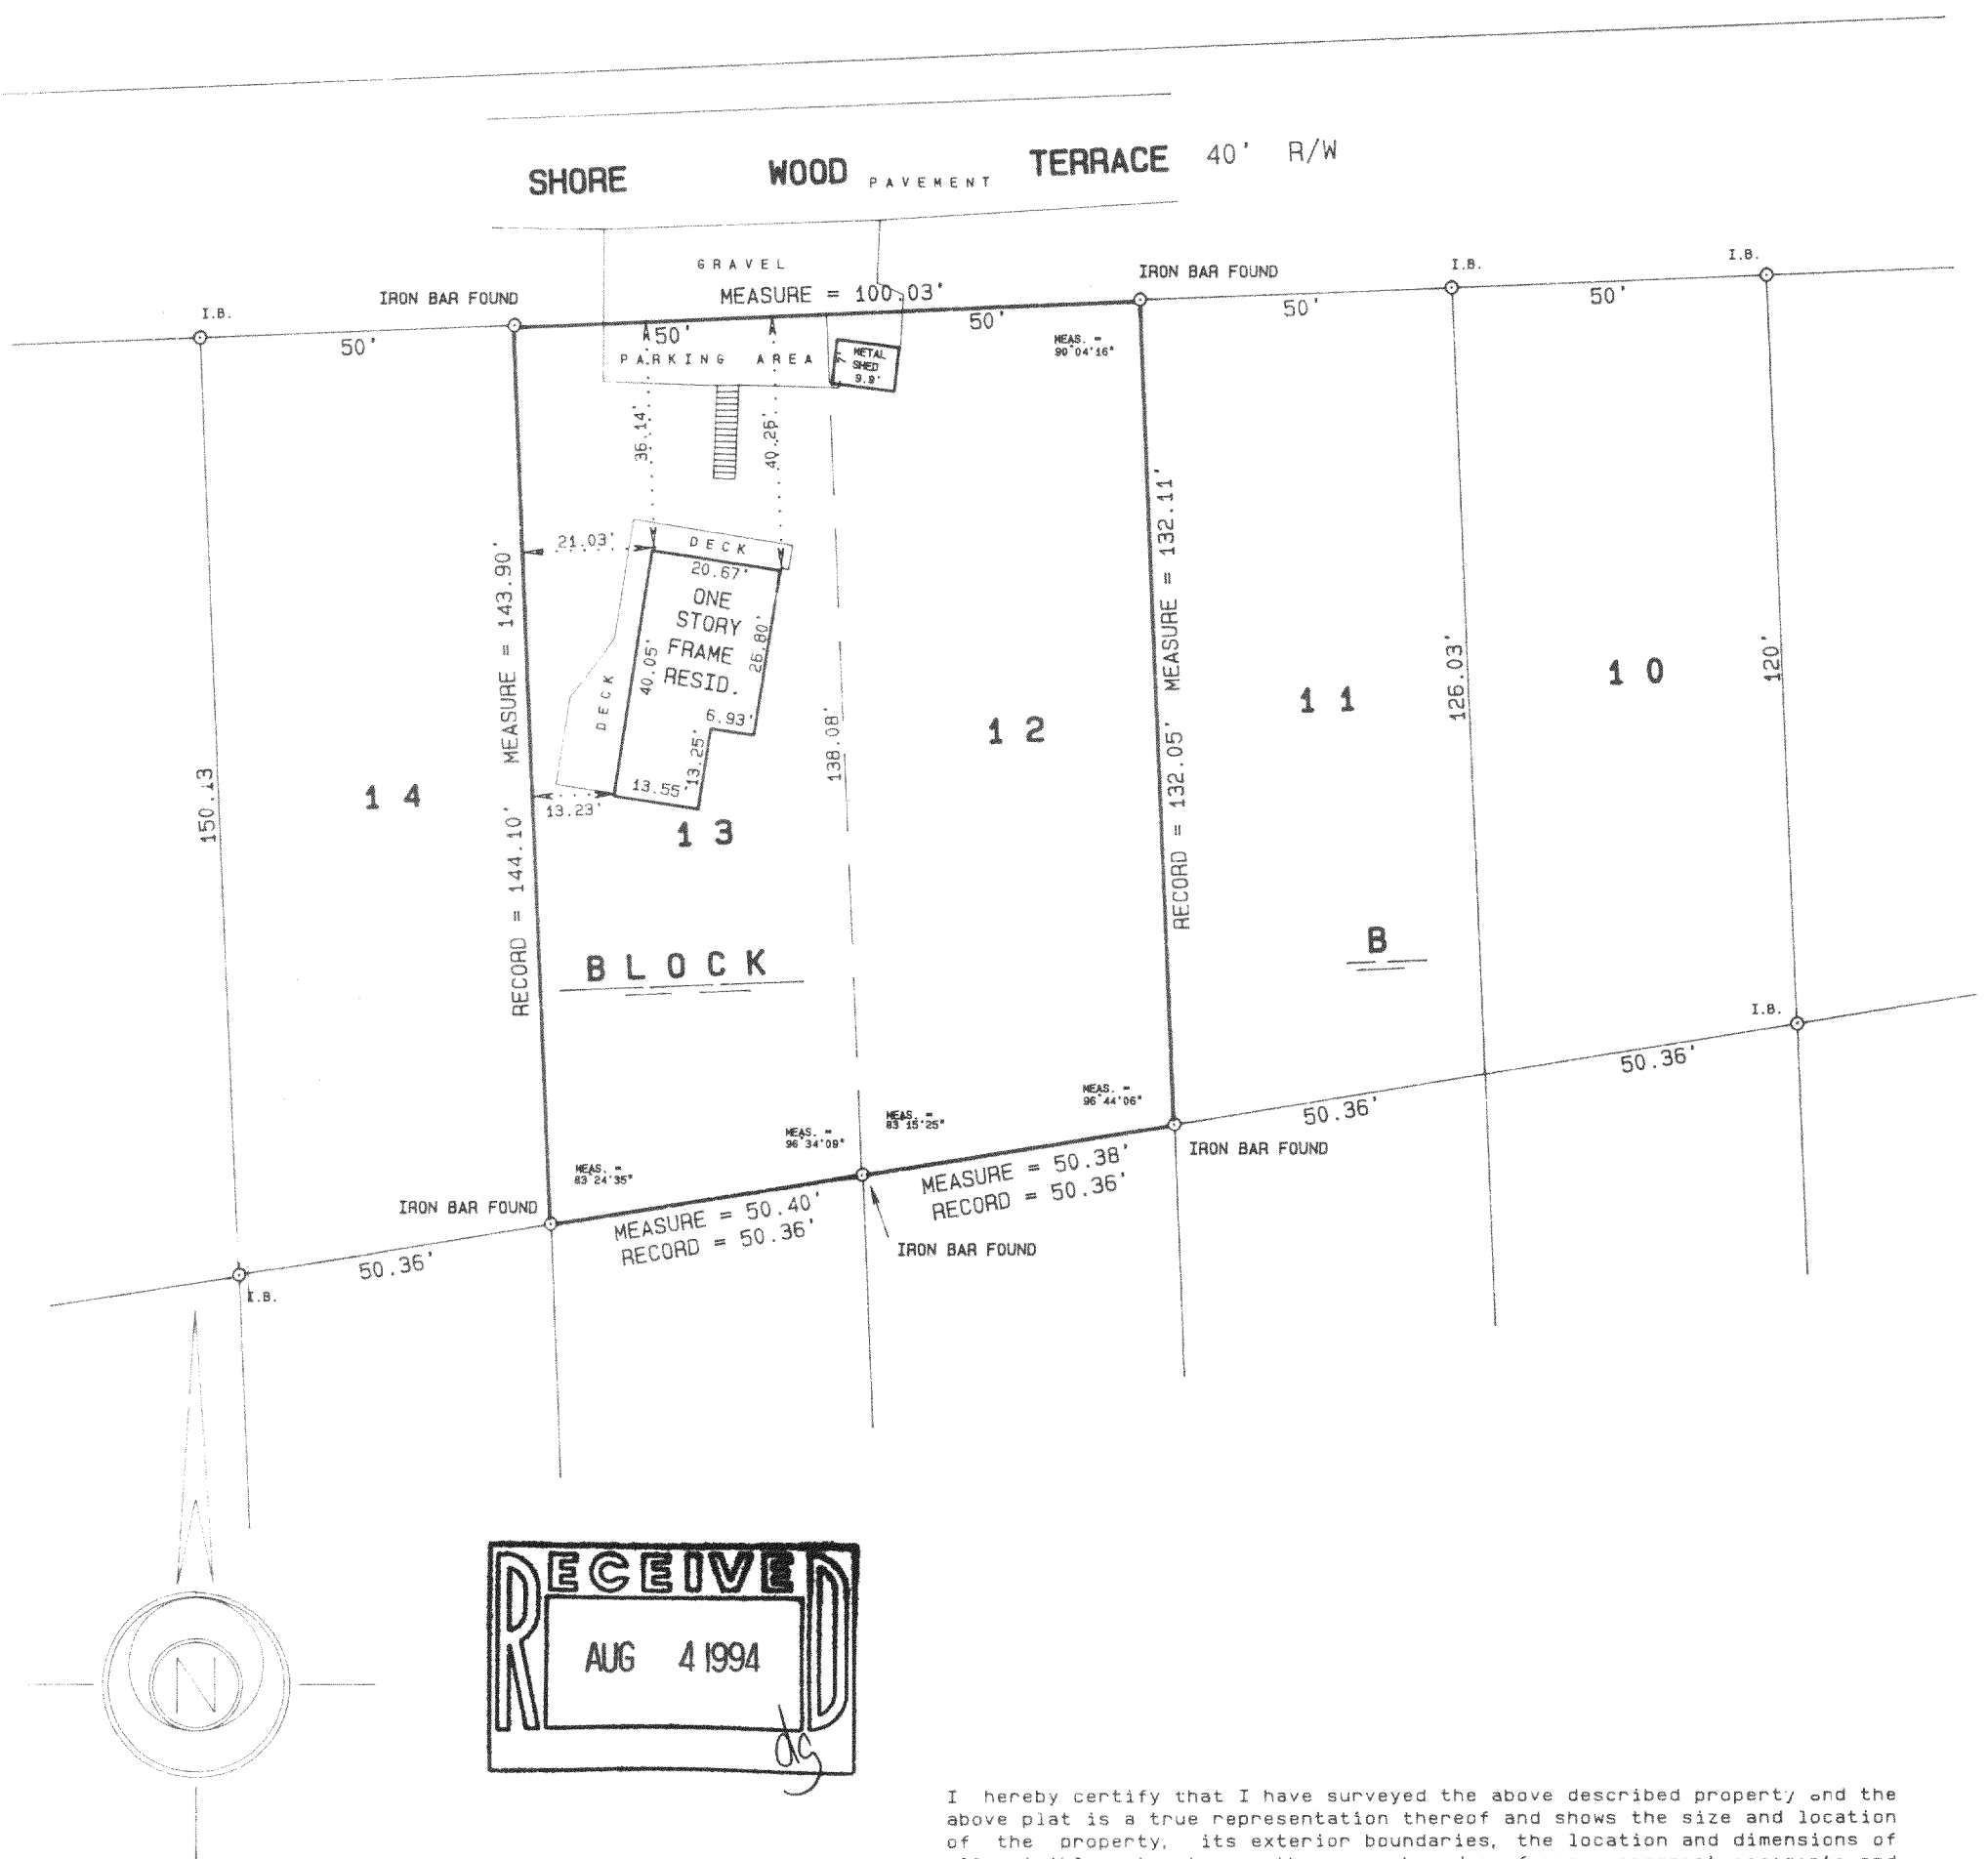

I hereby certify that I have surveyed the above described property; and the above plat is a true representation thereof and shows the size and location of the property, its exterior boundaries, the location and dimensions of all visible structures thereon, boundary fences, apparent easements and roadways and visible encroachments, if any.

This survey is made for the exclusive use of the present owners of the property, and also those who purchase, mortgage, or guarantee the title thereto within one year from the date hereof.

Dated at Bassett, Wisconsin this 14th day of JUNE 1994.

Mark A. Bolender
Mark A. Bolender
Wisconsin Registered Land Surveyor S - 1784

SCALE 1 inch = 30 feet

ORDERED BY G. Leinen/Lake Geneva Properties
JOB NO. 94211

JOB NO. 94211

COR-23
COR-24

315-4306