


ABELL
SURVEYING & MAPPING
DELAN, WISCONSIN 53115
414-728-6737

NOTE: BEARINGS ARE REFERENCED TO THE
RECORDED SUBDIVISION PLAT.

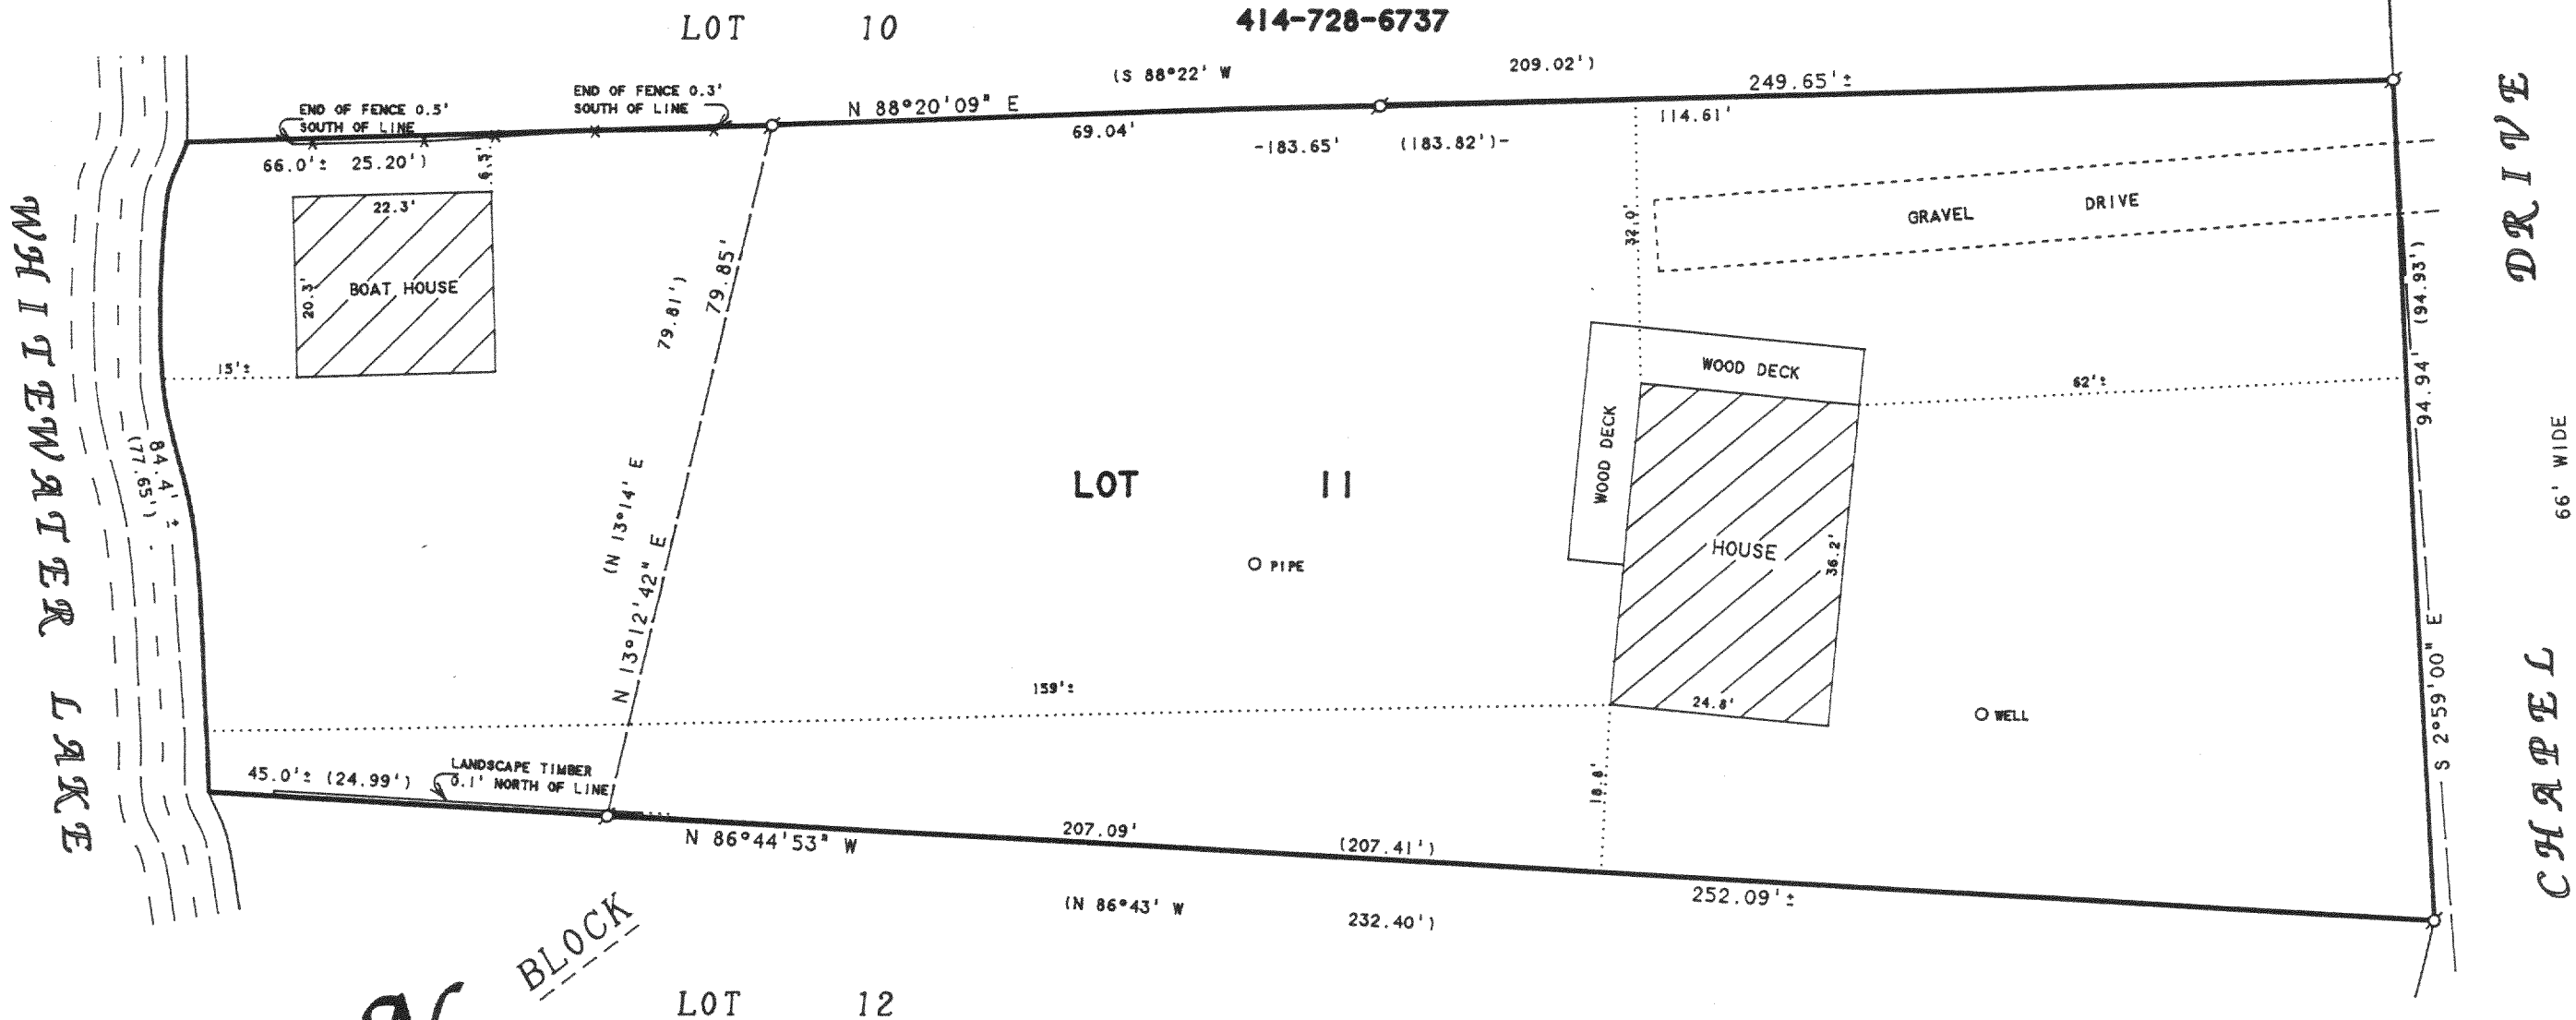


SCALE 1"=20'

LEGEND

- -IRON PIPE FOUND
- * -WOOD FENCE
- -OVERHEAD UTILITY LINES
- () -RECORDED AS

ORDERED BY: ERVIN BRAATZ
5238 S. 49th STREET
GREENFIELD, WI 53220

PLAT OF SURVEY OF
LOT 11, BLOCK 6, CHAPEL HILLS SUBDIVISION,
LOCATED IN T3N, R15E, WALWORTH COUNTY,
WISCONSIN.

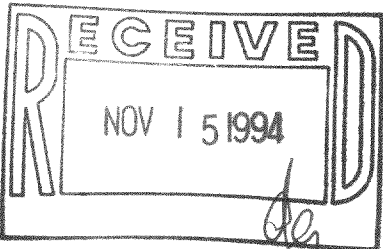

I HEREBY CERTIFY THAT I HAVE SURVEYED THE ABOVE DESCRIBED PROPERTY AND THAT THE ABOVE MAP IS A TRUE REPRESENTATION THEREOF AND SHOWS THE SIZE AND LOCATION OF THE PROPERTY, ITS EXTERIOR BOUNDARIES, THE LOCATION OF ALL VISIBLE STRUCTURES AND DIMENSIONS OF ALL PRINCIPAL BUILDINGS THEREON, BOUNDARY FENCES, APPARENT EASEMENTS, ROADWAYS AND VISIBLE ENCROACHMENTS, IF ANY, TO THE BEST OF MY KNOWLEDGE AND BELIEF.

THIS SURVEY IS MADE FOR THE USE OF THE PRESENT OWNERS OF THE PROPERTY, AND ALSO THOSE WHO PURCHASE, MORTGAGE, OR GUARANTEE THE TITLE THERETO WITHIN ONE (1) YEAR FROM DATE HEREON.

David F. Abell

DAVID F. ABELL
WISCONSIN REGISTERED LAND SURVEYOR, S-1596

September 21, 1994

DATE: JOB NUMBER - 94161
NOTE: THIS IS NOT A CERTIFIED COPY UNLESS SEALED.

CCH-15

315-450