


DUNHAM SURVEYING, S.C.
SURVEYING & SUBDIVIDING
DELAVER, WISCONSIN 53115

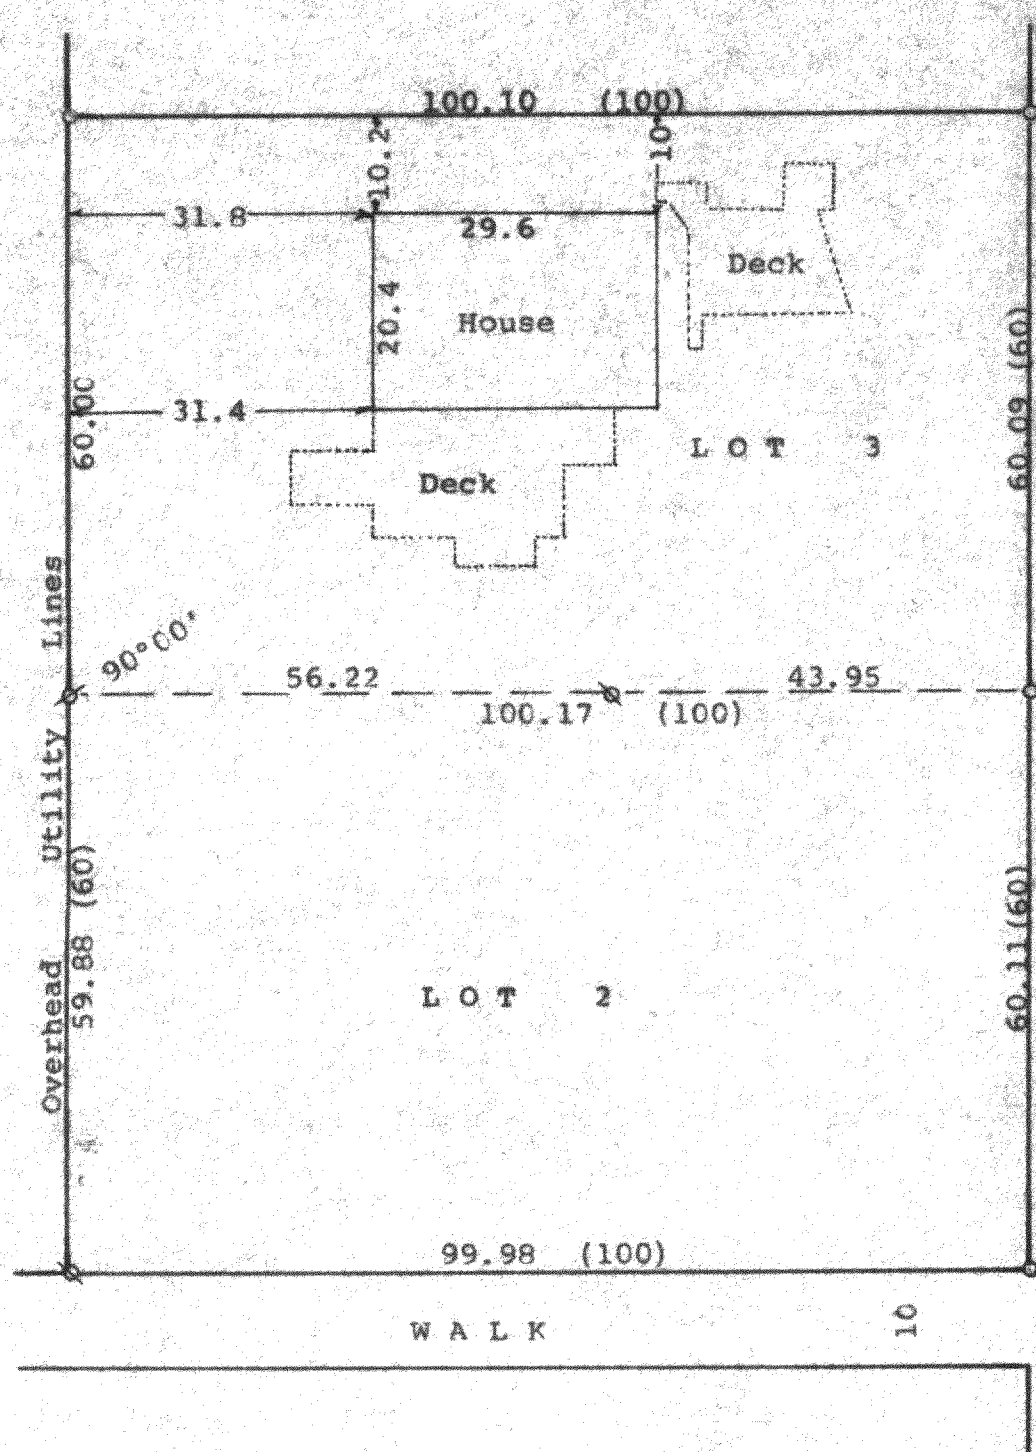

Scale - 1" = 20'
O = 5/8" Iron Rod Found
Ø = 3/4" Iron pipe Found
Ø = 1/2" Iron Pipe Found
(0.00) = recorded distance
Owners: Thaddeus J. & Mary Ann Balinski
1019 N. 14th Avenue
Melrose Park, IL 60160


STATE OF WISCONSIN)
COUNTY OF WALWORTH)

I, George T. Dunham, Surveyor, certify that I have surveyed the property described as follows:

Lots 2 and 3 in Block "D" of Crystal Bowl, a subdivision located in the SE 1/4 of the SW 1/4 of Section 12 and in the NE 1/4 of the NW 1/4 of Section 13, all in T 3 N, R 15 E, Walworth County, Wisconsin, and that the plat shown hereon is a correct representation thereof and shows the size and location of the property, its exterior boundaries, the location of all visible structures and dimensions of all principal buildings thereon, boundary fences, apparent easements, roadways and visible encroachments, if any, and that I have surveyed the property hereon described, according to the official records, to the best of my knowledge and belief.
January 9, 1995

George T. Dunham
George T. Dunham, Surveyor

CCR-73
CCR-74

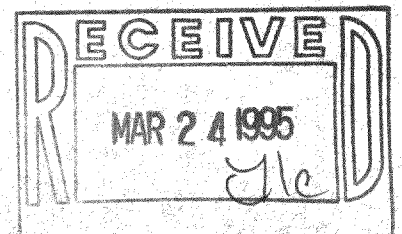

315-485