



PLAT OF SURVEY

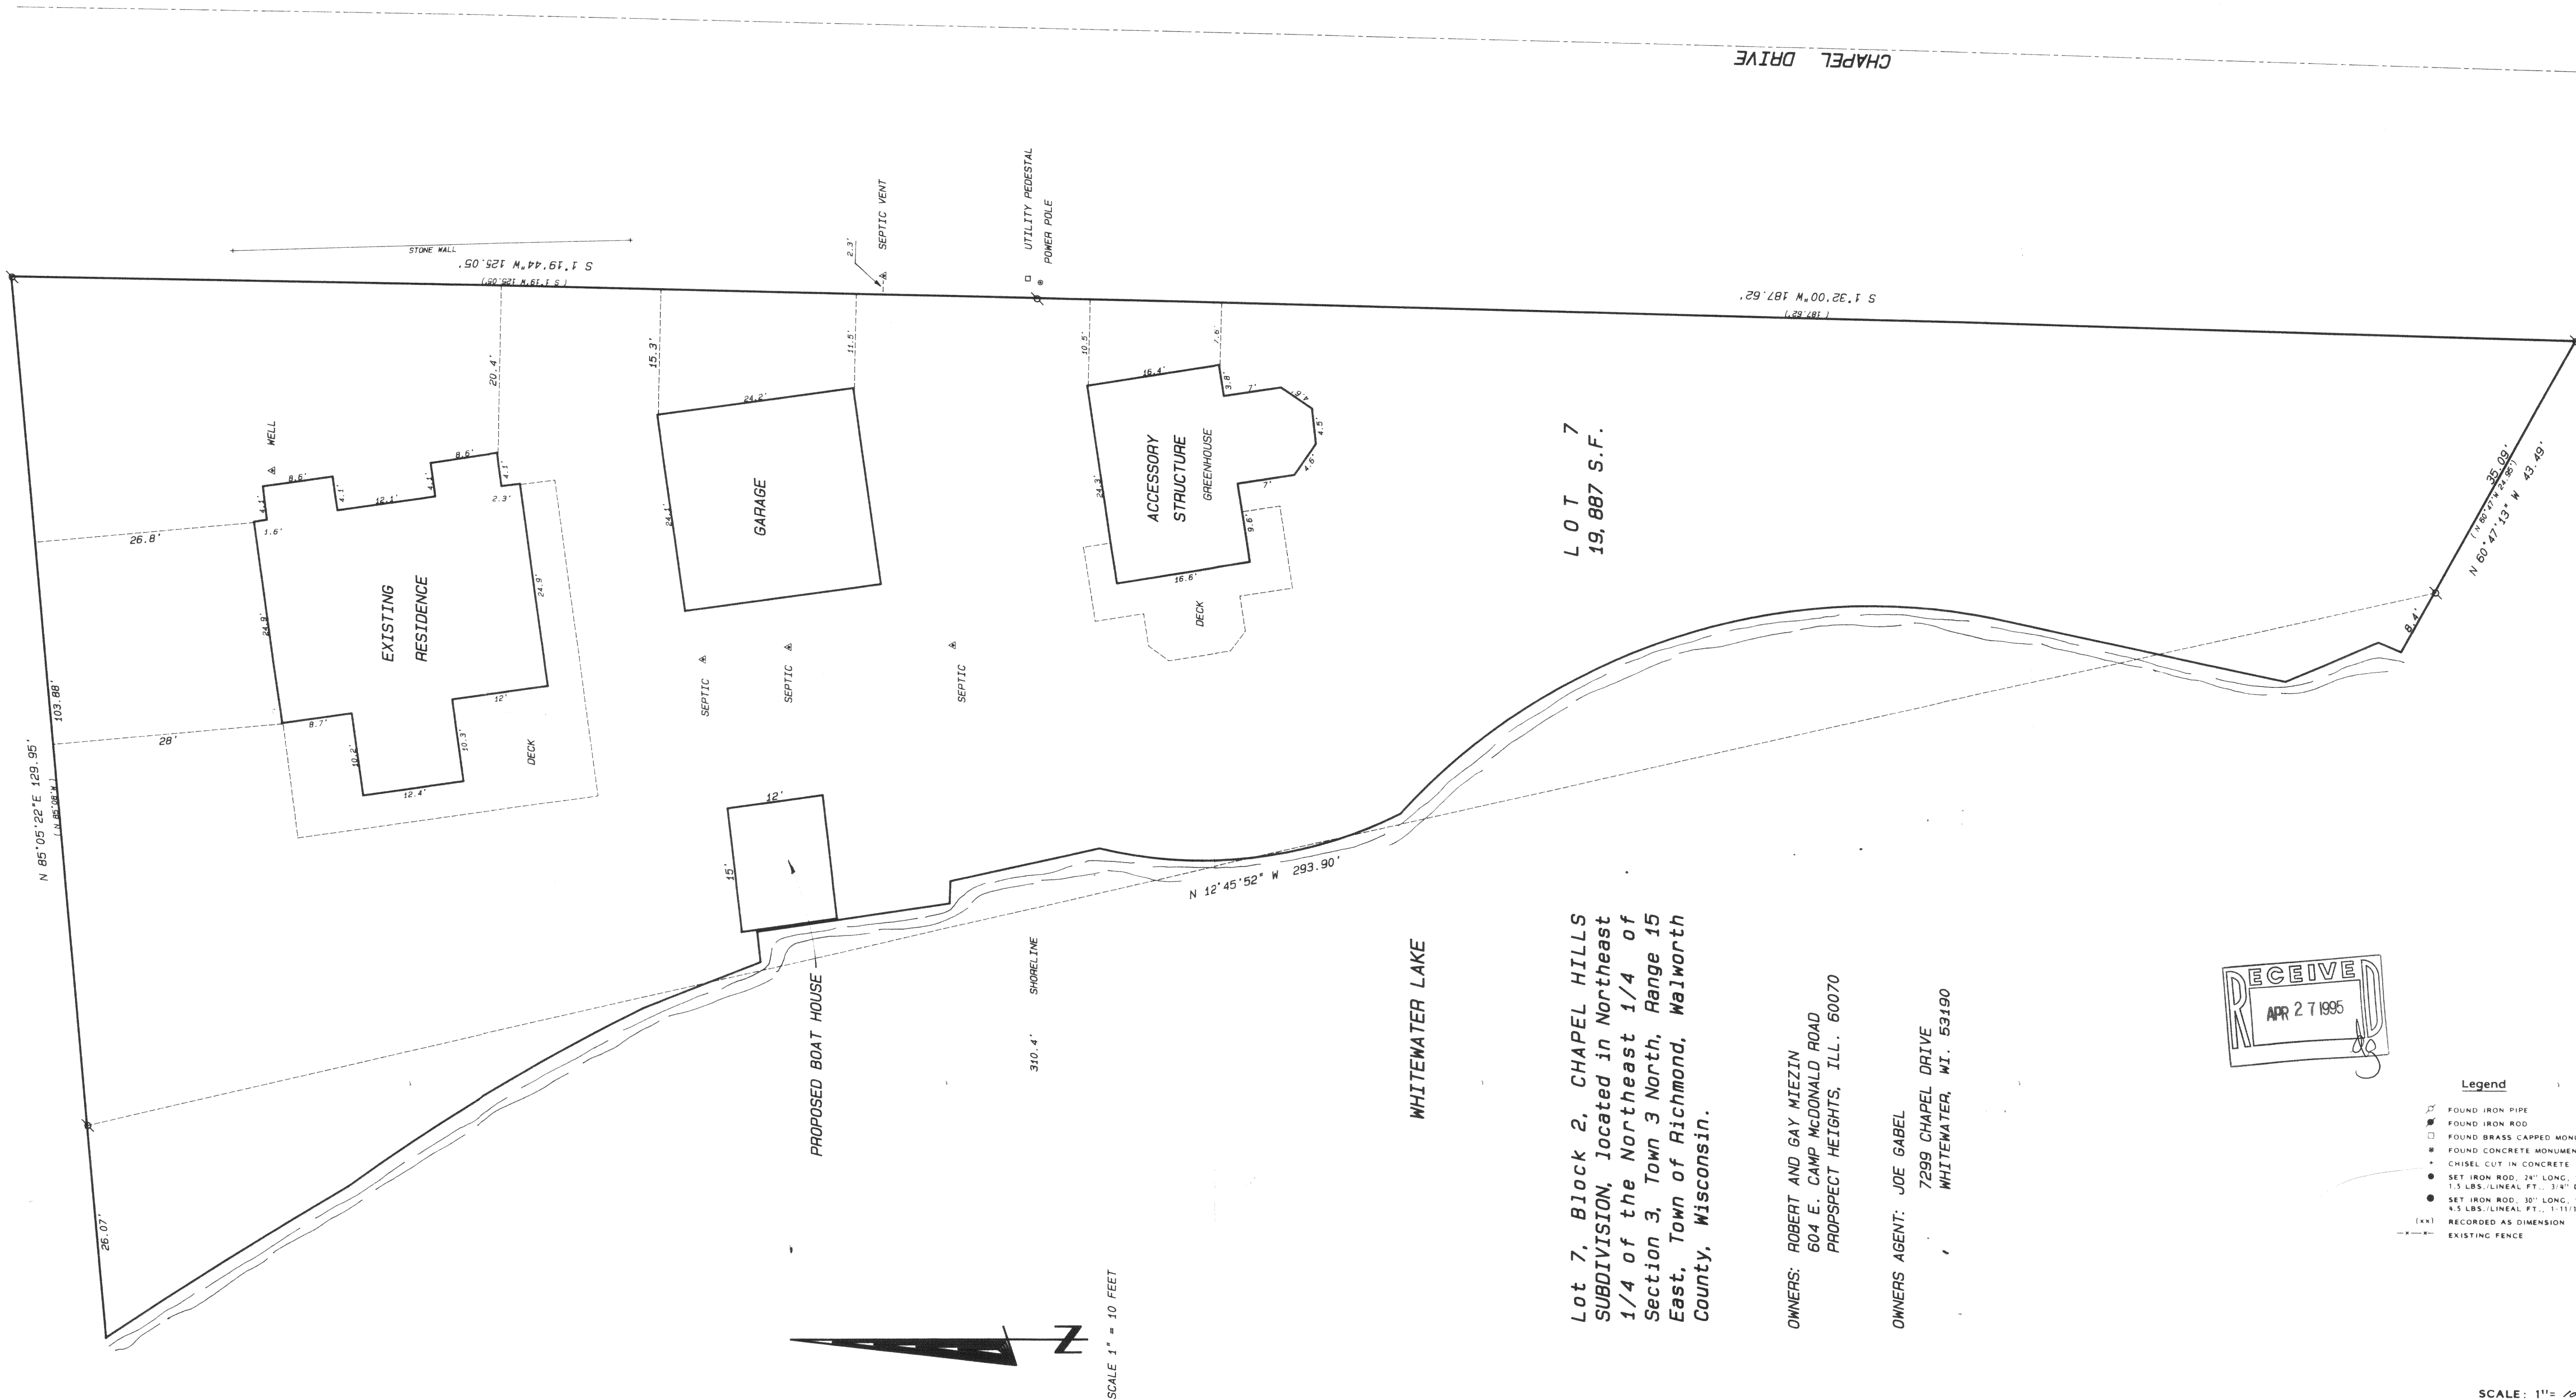

Lot 7, Block 2, CHAPEL HILLS
SUBDIVISION, located in Northeast
1/4 of the Northeast 1/4 of
Section 3, Town 3 North, Range 15
East, Town of Richmond, Walworth
County, Wisconsin.

OWNERS: ROBERT AND GAY MIEZIN
604 E. CAMP McDONALD ROAD
PROSPER HEIGHTS, ILL. 60070


OWNERS AGENT: JOE GABEL
7299 CHAPEL DRIVE
WHITEWATER, WI. 53190

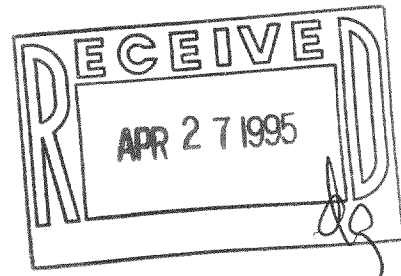

Legend

- FOUND IRON PIPE
- FOUND IRON ROD
- FOUND BRASS CAPPED MONUMENT
- FOUND CONCRETE MONUMENT
- CHISEL CUT IN CONCRETE
- SET IRON ROD, 24" LONG, WEIGHING 1.5 LBS./LINEAL FT., 1-1/8" DIA.
- SET IRON ROD, 30" LONG, WEIGHING 4.5 LBS./LINEAL FT., 1-1/16" DIA.
- RECORDED AS DIMENSION
- EXISTING FENCE

SCALE: 1" = 10 FEET

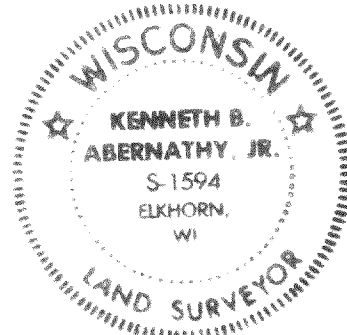

"I hereby certify that the above described property has been surveyed by me or under my direction and that the above map is a true representation thereof and shows the size and location of the property, its exterior boundaries, the location of all visible structures and dimensions of all principal buildings thereon, boundary fences, apparent easements, roadways and visible encroachments, if any."

This survey is made for the use of the present owners of the property and also those who purchase, mortgage, or guarantee the title thereto within one year from date hereof.

Kenneth B. Abernathy, Jr.

KENNETH B. ABERNATHY, JR.
WISCONSIN REGISTERED LAND SURVEYOR,
S-1594

Date: APRIL 3, 1995 Job No. 95.317