


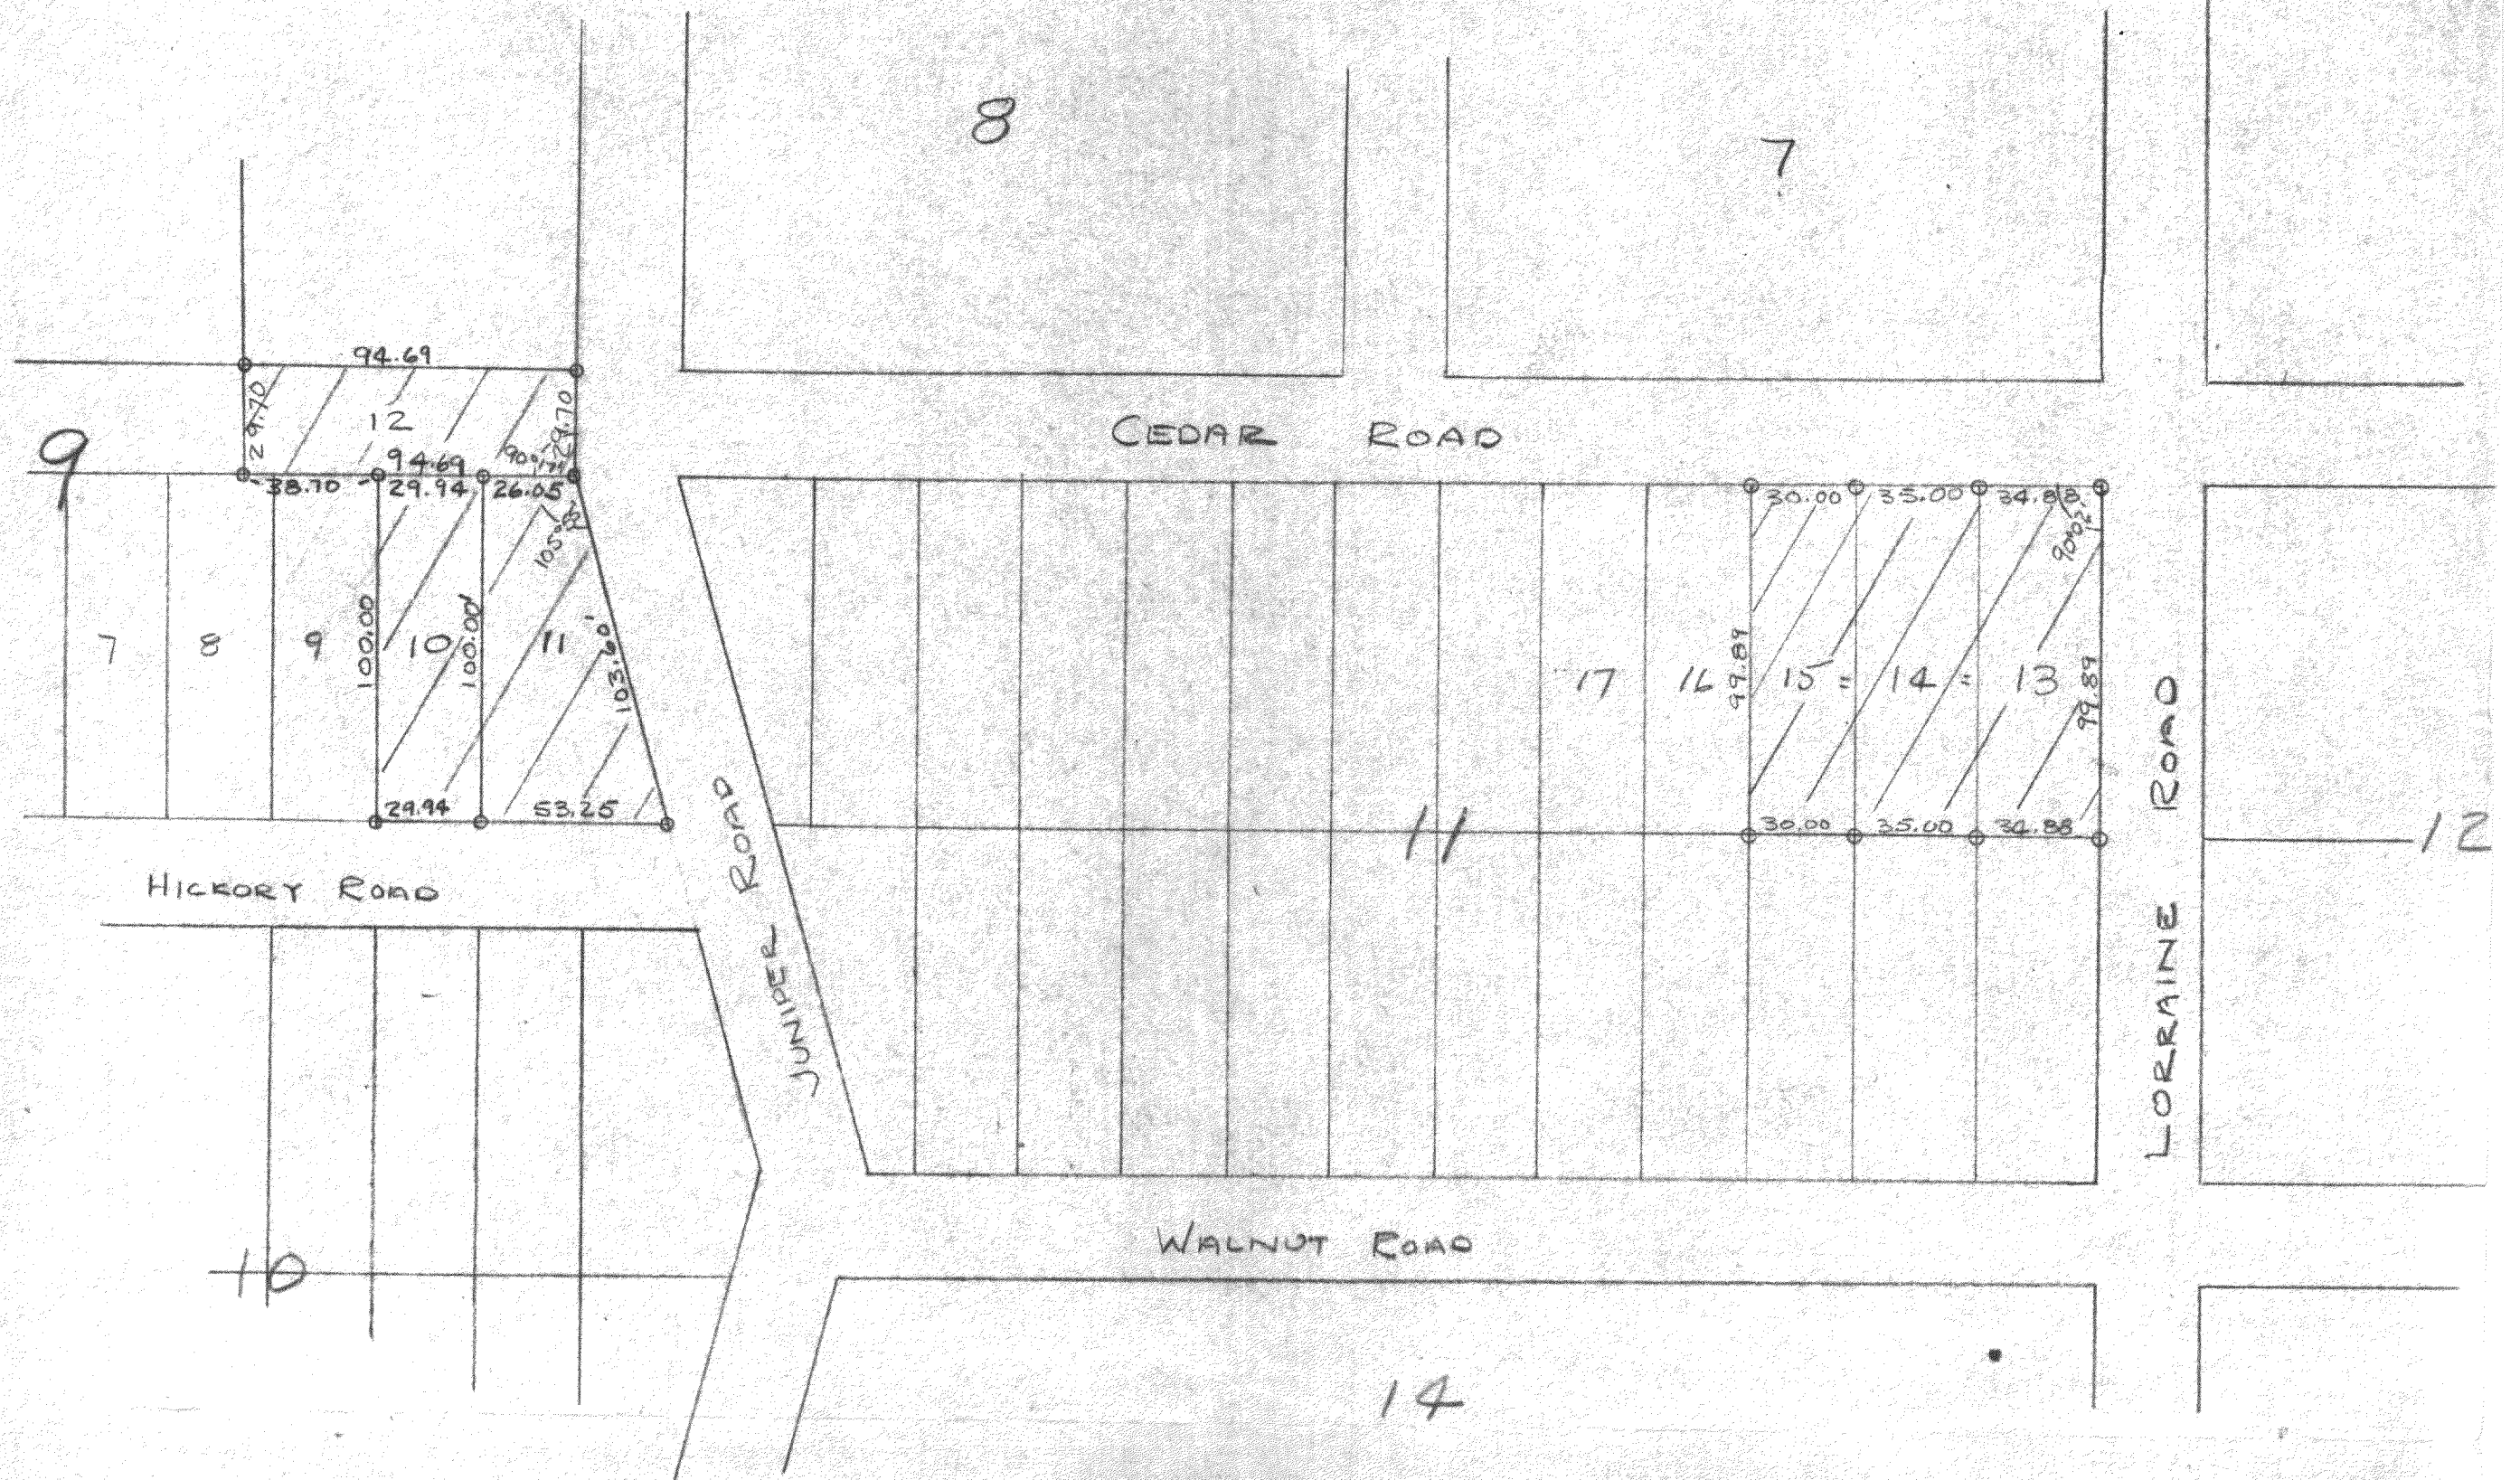

CS-149

CS-181A

SCALE 1"=50'
O = IRON PIPE

CS-149, 181A

PLAT OF SURVEY OF LOTS 10, 11, & 12 OF BLOCK 9, AND LOTS 13, 14, & 15 OF BLOCK 11 OF SKANSEN SWEDISH TRIBUNE NEWS SUBDIVISION LOCATED IN SECTION 9, T3N R15E, WALWORTH COUNTY, WIS.

JULY, 1950

Lloyd R. Jensen
COUNTY SURVEYOR

315-5.1