


PLAT OF SURVEY


Lots 13 and 14 of Block F of Crystal Bowl Subdivision, located in part of the Southeast 1/4 of the Southwest 1/4 of Section 12 and part of the Northeast 1/4 of the Northwest 1/4 of Section 13, all in Town 3 North, Range 15 East, Town of Richmond, County of Walworth, State of Wisconsin.

Owner: Peter Starin
N6523 County Trunk Highway "P"
Delavan, Wisconsin 53115

Ordered by: Kris McGill

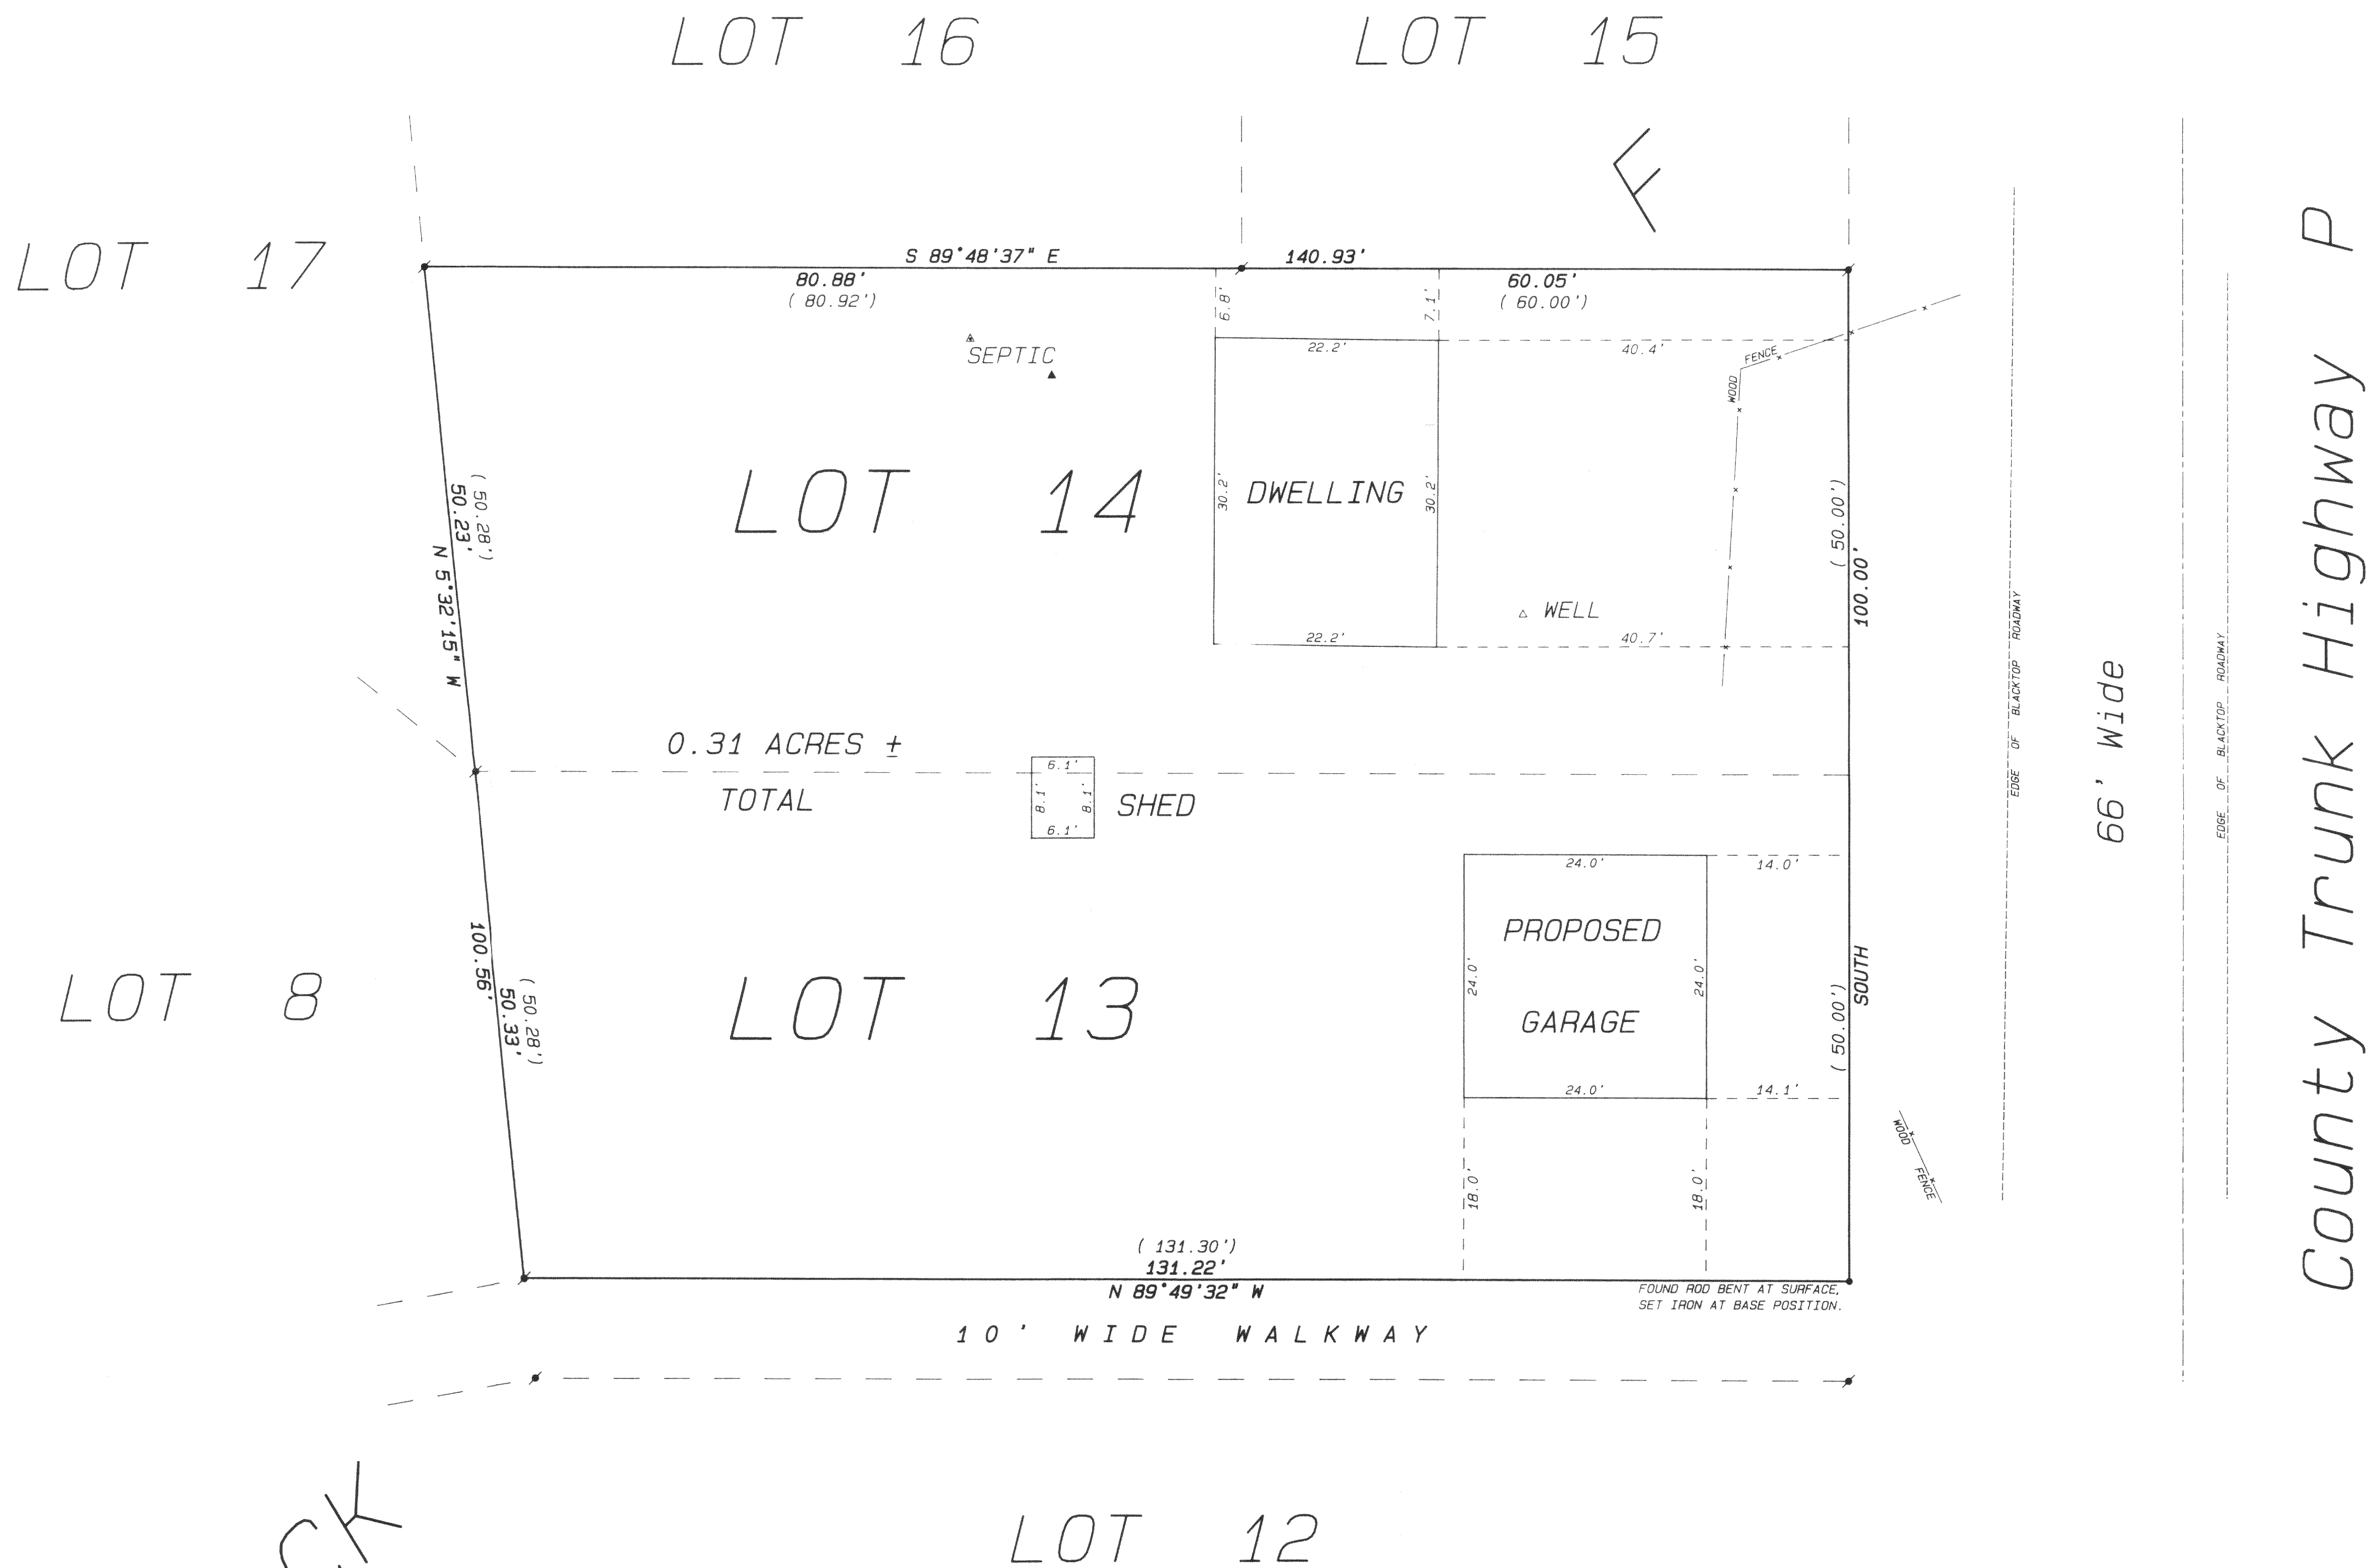

NOTE
WOOD STAKES HAVE BEEN PLACED AT BUILDING CORNERS. BUILDER IS TO VERIFY DIMENSIONS WHICH HAVE BEEN ROUNDED TO THE NEAREST TENTH OF A FOOT TO INSURE PROPER PLAN INTERPRETATION AND CONTACT THIS OFFICE IMMEDIATELY IF ANY DISCREPANCY EXISTS.

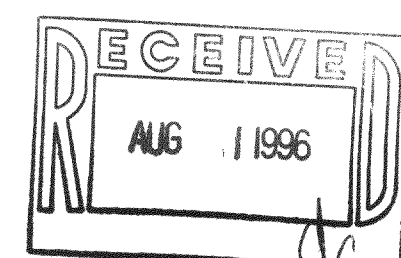

- Legend
- FOUND IRON PIPE
 - FOUND IRON ROD
 - FOUND BRASS CAPPED MONUMENT
 - FOUND CONCRETE MONUMENT
 - CHISEL CUT IN CONCRETE
 - SET IRON ROD, 24" LONG, WEIGHING 1.5 LBS./LINEAL FT., 3/4" DIA.
 - SET IRON ROD, 30" LONG, WEIGHING 4.5 LBS./LINEAL FT., 1-11/16" DIA.
 - RECORDED AS DIMENSION
 - EXISTING FENCE



SCALE: 1"= 10 FEET

I hereby certify that the above described property has been surveyed by me or under my direction and that the above map is a true representation thereof and shows the size and location of the property, its exterior boundaries, the location of all visible structures and dimensions of all principal buildings thereon, boundary fences, apparent easements, roadways and visible encroachments, if any.

Terry W. Schilling
TERRY W. SCHILLING, WISCONSIN
REGISTERED LAND SURVEYOR S-2193

Date: JULY 14, 1996 Job No. 1996.608

CCR-104

315-533