
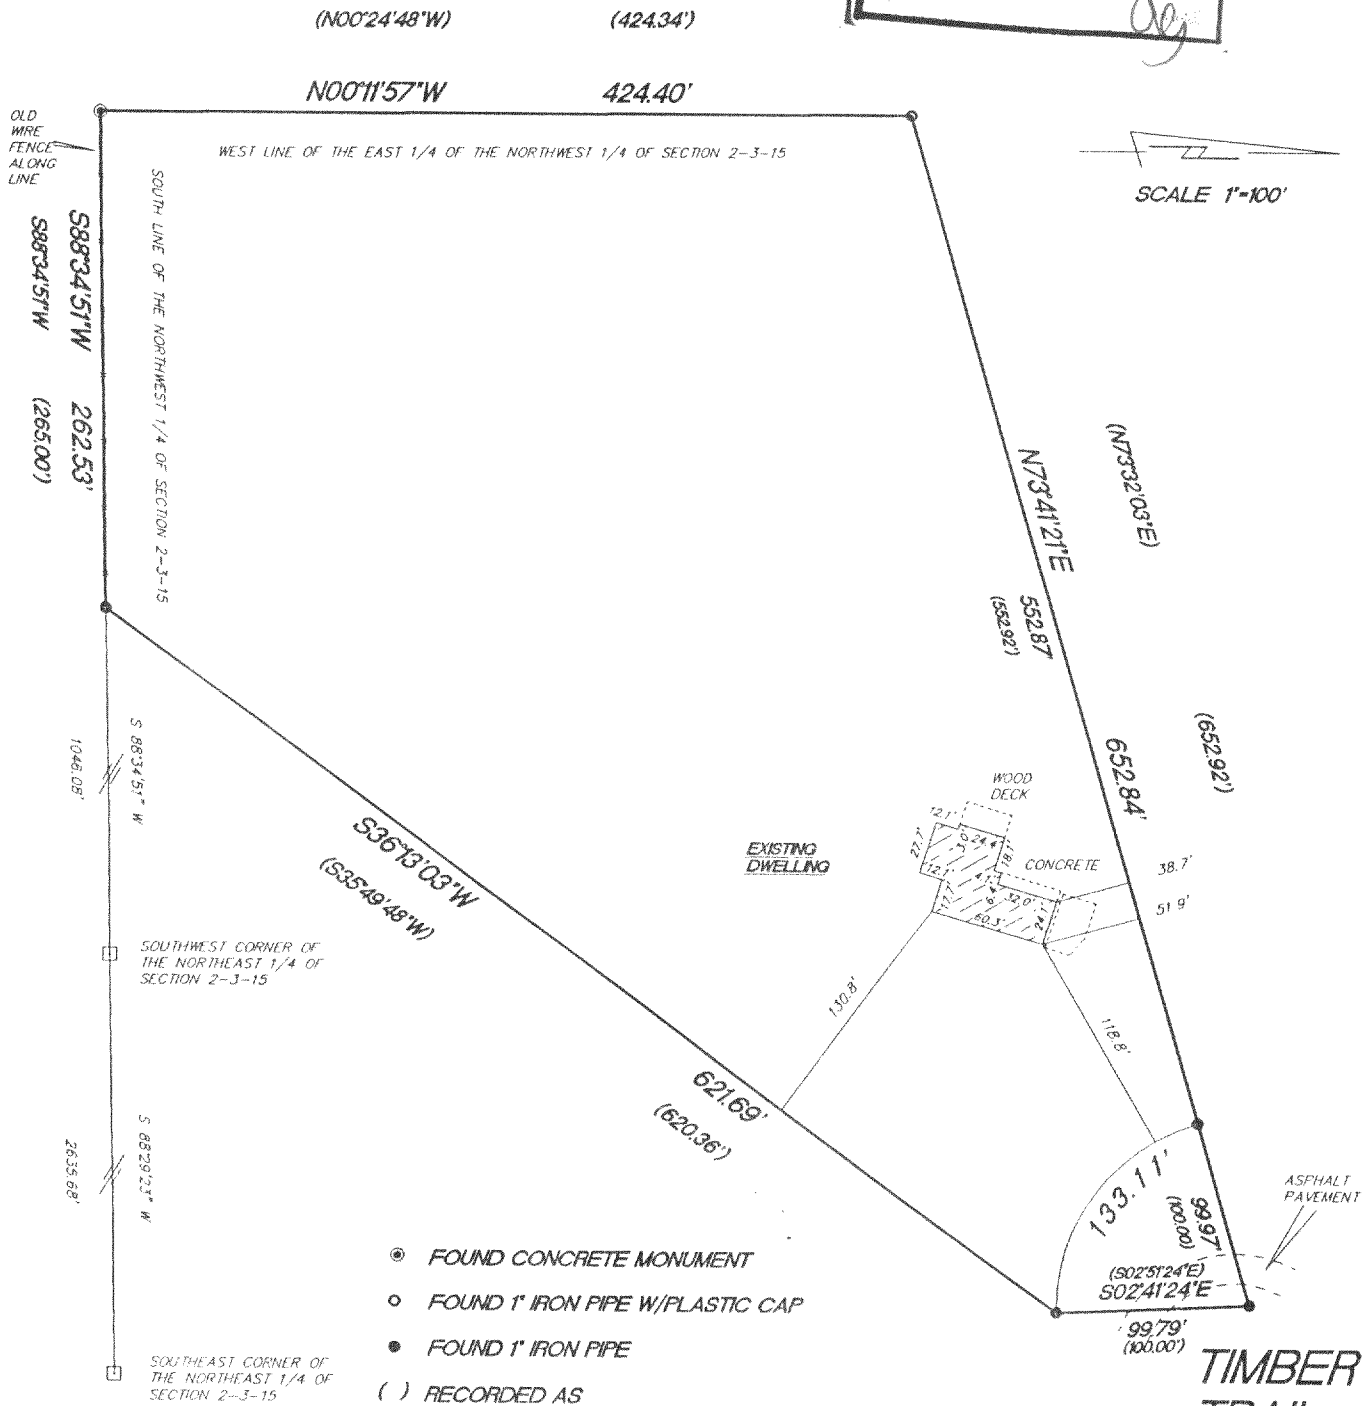


PLAT OF SURVEY

That part of the NW 1/4 of Section 2, T3N, R15E, in the Town of Richmond, Walworth County, Wisconsin, bounded and described as follows: Commencing at the center of said Section, said center being 2635.68 feet S 88° 29' 23" West of the SE corner of the NE 1/4 of said Section 2; thence 88° 34' 51" West, along the South line of said NW 1/4 of said Section 2, 1046.08 feet to the point of beginning; continuing thence S 88° 34' 51" West, along said South line 265.00 feet to a point being the SW corner of the SE 1/4 of the NW 1/4 of said Section 2, thence N 0° 24' 48" West, along the West line of the East 1/2 of the NW 1/4 of said Section 2, 424.34 feet to a point; thence N 73° 32' 03" East 652.92 feet to a point being a center of a 100 foot radius cul-de-sac, thence S 2° 51' 54" East 100.00 feet to a point in the South line of said cul-de-sac; thence S 35° 49' 48" West 620.36 feet to the point of beginning.

Surveyed for: Walton Reality

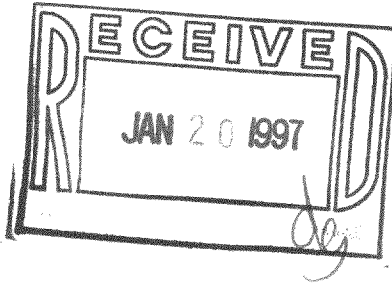


"I hereby certify that I have surveyed the above described property and that the above map is a true representation thereof and shows the size and location of the property, its exterior boundaries, the location of all visible structures and dimension of all principal buildings thereon, boundary fences, apparent easements, roadways and encroachments if any."

"This survey is made for the use of the present owners of the property, and also those who purchase, mortgage or guarantee the title thereto within one year from date hereof."



W362 S10227 Lewin Lane
Eagle, Wisconsin 53119
Terrance E. Pisarek R.L.S.

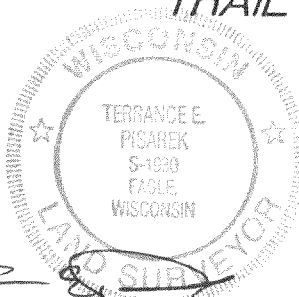

(414) 594-3484
fax (414) 594-5904

THIS IS NOT AN ORIGINAL SURVEY UNLESS THE SEAL IS RED.

10/16/96 DATE DRE/JPB FIELD WORK BY

TEP DRAWN BY 96170 JOB NUMBER

CR-2-27

315-568