


ABERNATHY and ASSOCIATES
Kenneth B. Abernathy Jr.
Wisconsin Registered Land Surveyor **S-1594**

Rt. 3, Box 273
Elkhorn, Wisconsin 53121
Phone: (414) 723 4260 (office)
(414) 723 7209 (FAX)

PLAT OF SURVEY

LOTS 4, 5, 6 & 7, BLOCK 14, SKANSEN'S SUBDIVISION
SOUTH PART, LOCATED IN THE SW 1/4 OF SECTION 9,
TOWN 3 NORTH, RANGE 15 EAST, RICHMOND TOWNSHIP,
WALWORTH COUNTY, WISCONSIN.

OWNERS: THOMAS AND KATHARINE STONEQUIST
W8770 RIDGE ROAD
DELAVAN, WIS. 53115

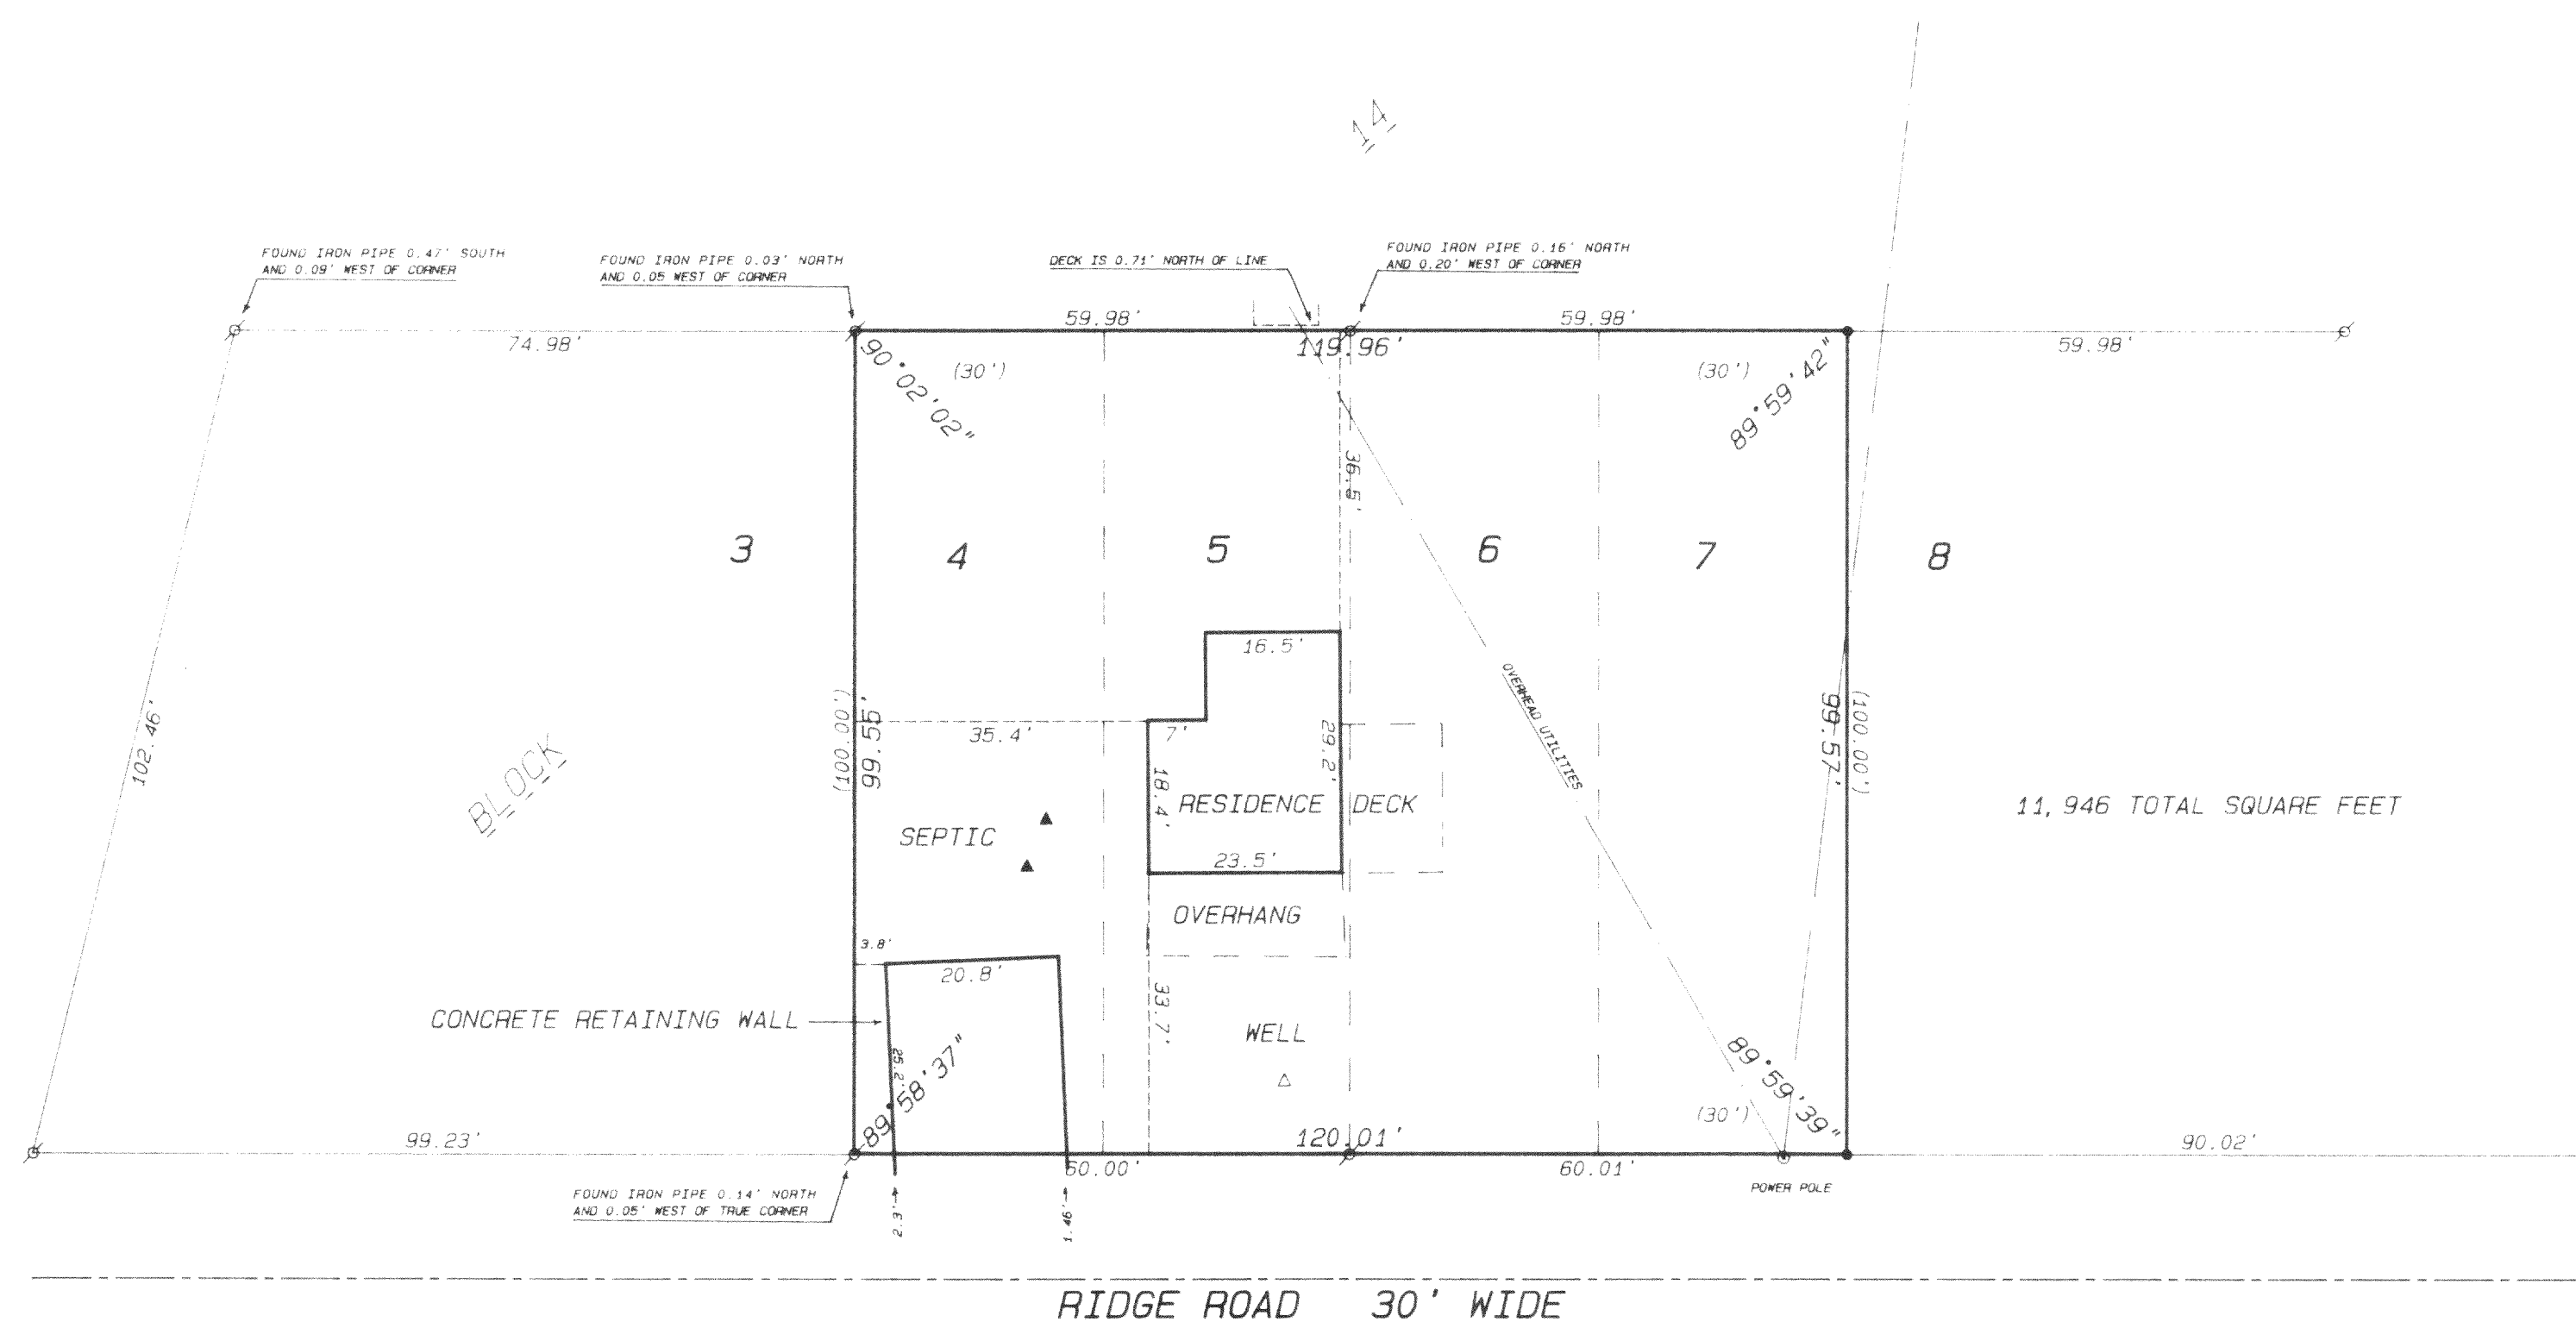


SCALE: 1" = 20 FEET


Legend

- FOUND IRON PIPE
- FOUND IRON ROD
- FOUND BRASS CAPPED MONUMENT
- FOUND CONCRETE MONUMENT
- CHISEL CUT IN CONCRETE
- SET IRON ROD, 24" LONG, WEIGHING 1.5 LBS. LINEAL FT., 3/4" DIA.
- SET IRON ROD, 30" LONG, WEIGHING 4.5 LBS. LINEAL FT., 1 11/16" DIA.
- (XX) RECORDED AS DIMENSION
- EXISTING FENCE

NOTE: THIS SURVEY RETRACES A DAVE ABELL SURVEY DATED MARCH 11, 1993

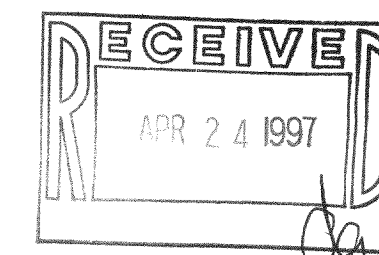

SCALE: 1" = 20 FEET

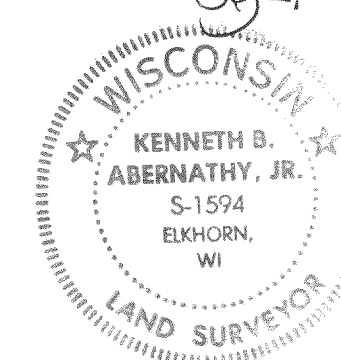

"I hereby certify that the above described property has been surveyed by me or under my direction and that the above map is a true representation thereof and shows the size and location of the property, its exterior boundaries, the location of all visible structures and dimensions of all principal buildings thereon, boundary fences, apparent easements, roadways and visible encroachments, if any."

"This survey is made for the use of the present owners of the property and also those who purchase, mortgage, or guarantee the title thereto within one year from date hereof."

Kenneth B. Abernathy, Jr.
WISCONSIN REGISTERED LAND SURVEYOR,
S-1594

Date: MARCH 10, 1997 Job No. 97.311

CS-226
CS-227

315-582