
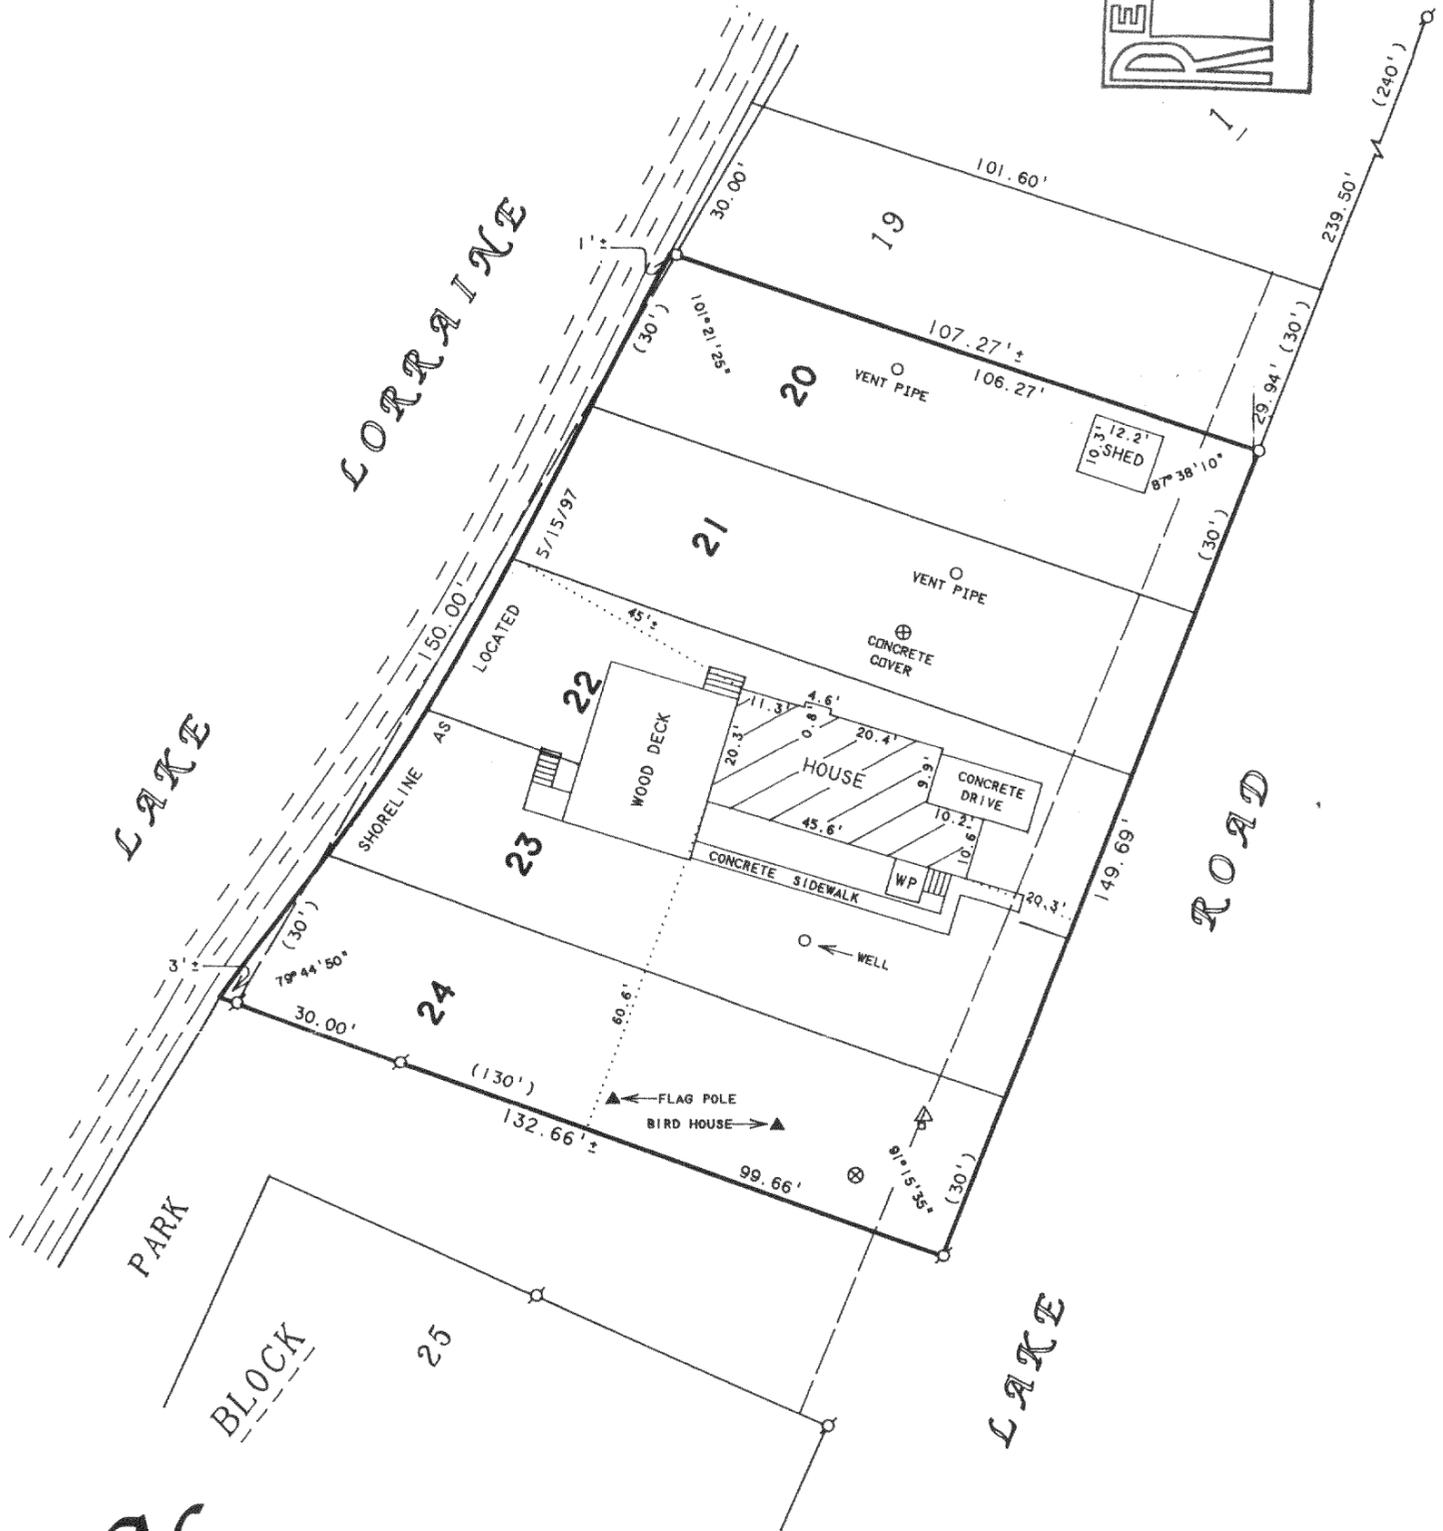


ABELL
SURVEYING & MAPPING

1140 SEQUOIA STREET • DELAVAN, WISCONSIN 53115
414-728-6737

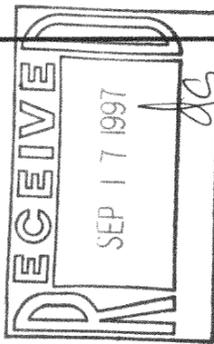

SCALE 1"=30'

LEGEND

- ⊙ - IRON PIPE FOUND
- - IRON PIPE SET, found 5/15/97
- △ - UTILITY POLE
- - OVERHEAD UTILITY LINES
- WP - WOOD PORCH
- - UTILITY PED
- ⊗ - MANHOLE COVER
- () - RECORDED AS

ORDERED BY: DENNIS HOFFMANN
1090 HARRISON LANE
HOFFMAN ESTATES, IL. 60195

REVISED DATE: MAY 19, 1997
REVISED TO SHOW IMPROVEMENTS AND
SHORELINE LOCATION

ORDERED BY: COLDWELL BANKER, TLC
5 WEST WALWORTH STREET
ELKHORN, WI 53121

PLAT OF SURVEY OF

LOTS 20 - 24, BLOCK 1 OF SKANSEN'S SWEDISH
TRIBUNE NEWS SUBDIVISION, LOCATED IN T3N, R15E,
WALWORTH COUNTY, WISCONSIN.

I HEREBY CERTIFY THAT I HAVE SURVEYED THE ABOVE DESCRIBED PROPERTY AND THAT THE ABOVE MAP IS A TRUE REPRESENTATION THEREOF AND SHOWS THE SIZE AND LOCATION OF THE PROPERTY, ITS EXTERIOR BOUNDARIES, THE LOCATION OF ALL VISIBLE STRUCTURES AND DIMENSIONS OF ALL PRINCIPAL BUILDINGS THEREON, BOUNDARY FENCES, APPARENT EASEMENTS, ROADWAYS AND VISIBLE ENCROACHMENTS, IF ANY, TO THE BEST OF MY KNOWLEDGE AND BELIEF.

THIS SURVEY IS MADE FOR THE USE OF THE PRESENT OWNERS OF THE PROPERTY, AND ALSO THOSE WHO PURCHASE, MORTGAGE, OR GUARANTEE THE TITLE THERETO WITHIN ONE (1) YEAR FROM DATE HEREON.

David F. Abell

DAVID F. ABELL
WISCONSIN REGISTERED LAND SURVEYOR, S-1596

MAY 7, 1992

REVISED MAY 14, 1992

DATE JOB NUMBER - 92088
NOTE: THIS IS NOT A CERTIFIED COPY UNLESS SEALED.

CS-16
CS-17
CS-18
CS-19

315-602