

N



SCALE 1"=20'

LEGEND

⊙ - IRON PIPE FOUND
() - RECORDED AS

ABELL
SURVEYING & MAPPING
DELAVAN, WISCONSIN 53115
414-728-6737

NOTE: BEARINGS ARE REFERENCED TO THE
RECORDED SUBDIVISION PLAT.

WHITEWATER

LAKE

BLOCK

LOT 9

LOT 10
0.30 ACRES±

LOT 11

PLAT OF SURVEY OF

LOT 10, BLOCK 3, CHAPEL HILLS SUBDIVISION,
LOCATED IN T3N.15E, WALWORTH COUNTY,
WISCONSIN.

ORDERED BY: RONALD SHAPIRO
222 E. CHESTNUT STREET
APT. 5C
CHICAGO, IL 60611


I, DAVID F. ABELL, DO HEREBY CERTIFY THAT I HAVE SURVEYED THE PROPERTY HEREON
DESCRIBED ACCORDING TO THE OFFICIAL RECORDS AND THAT THE PLAT HEREON IS A
CORRECT REPRESENTATION OF THE PROPERTY LINES TO THE BEST OF MY KNOWLEDGE AND
BELIEF.

David F. Abell


DAVID F. ABELL
WISCONSIN REGISTERED LAND SURVEYOR, S-1596

February 11, 1999

DATE: February 11, 1999 JOB NUMBER - 99009
NOTE: THIS IS NOT A CERTIFIED COPY UNLESS SEALED.

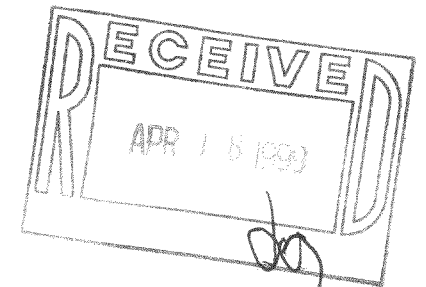

CHAPEL DRIVE

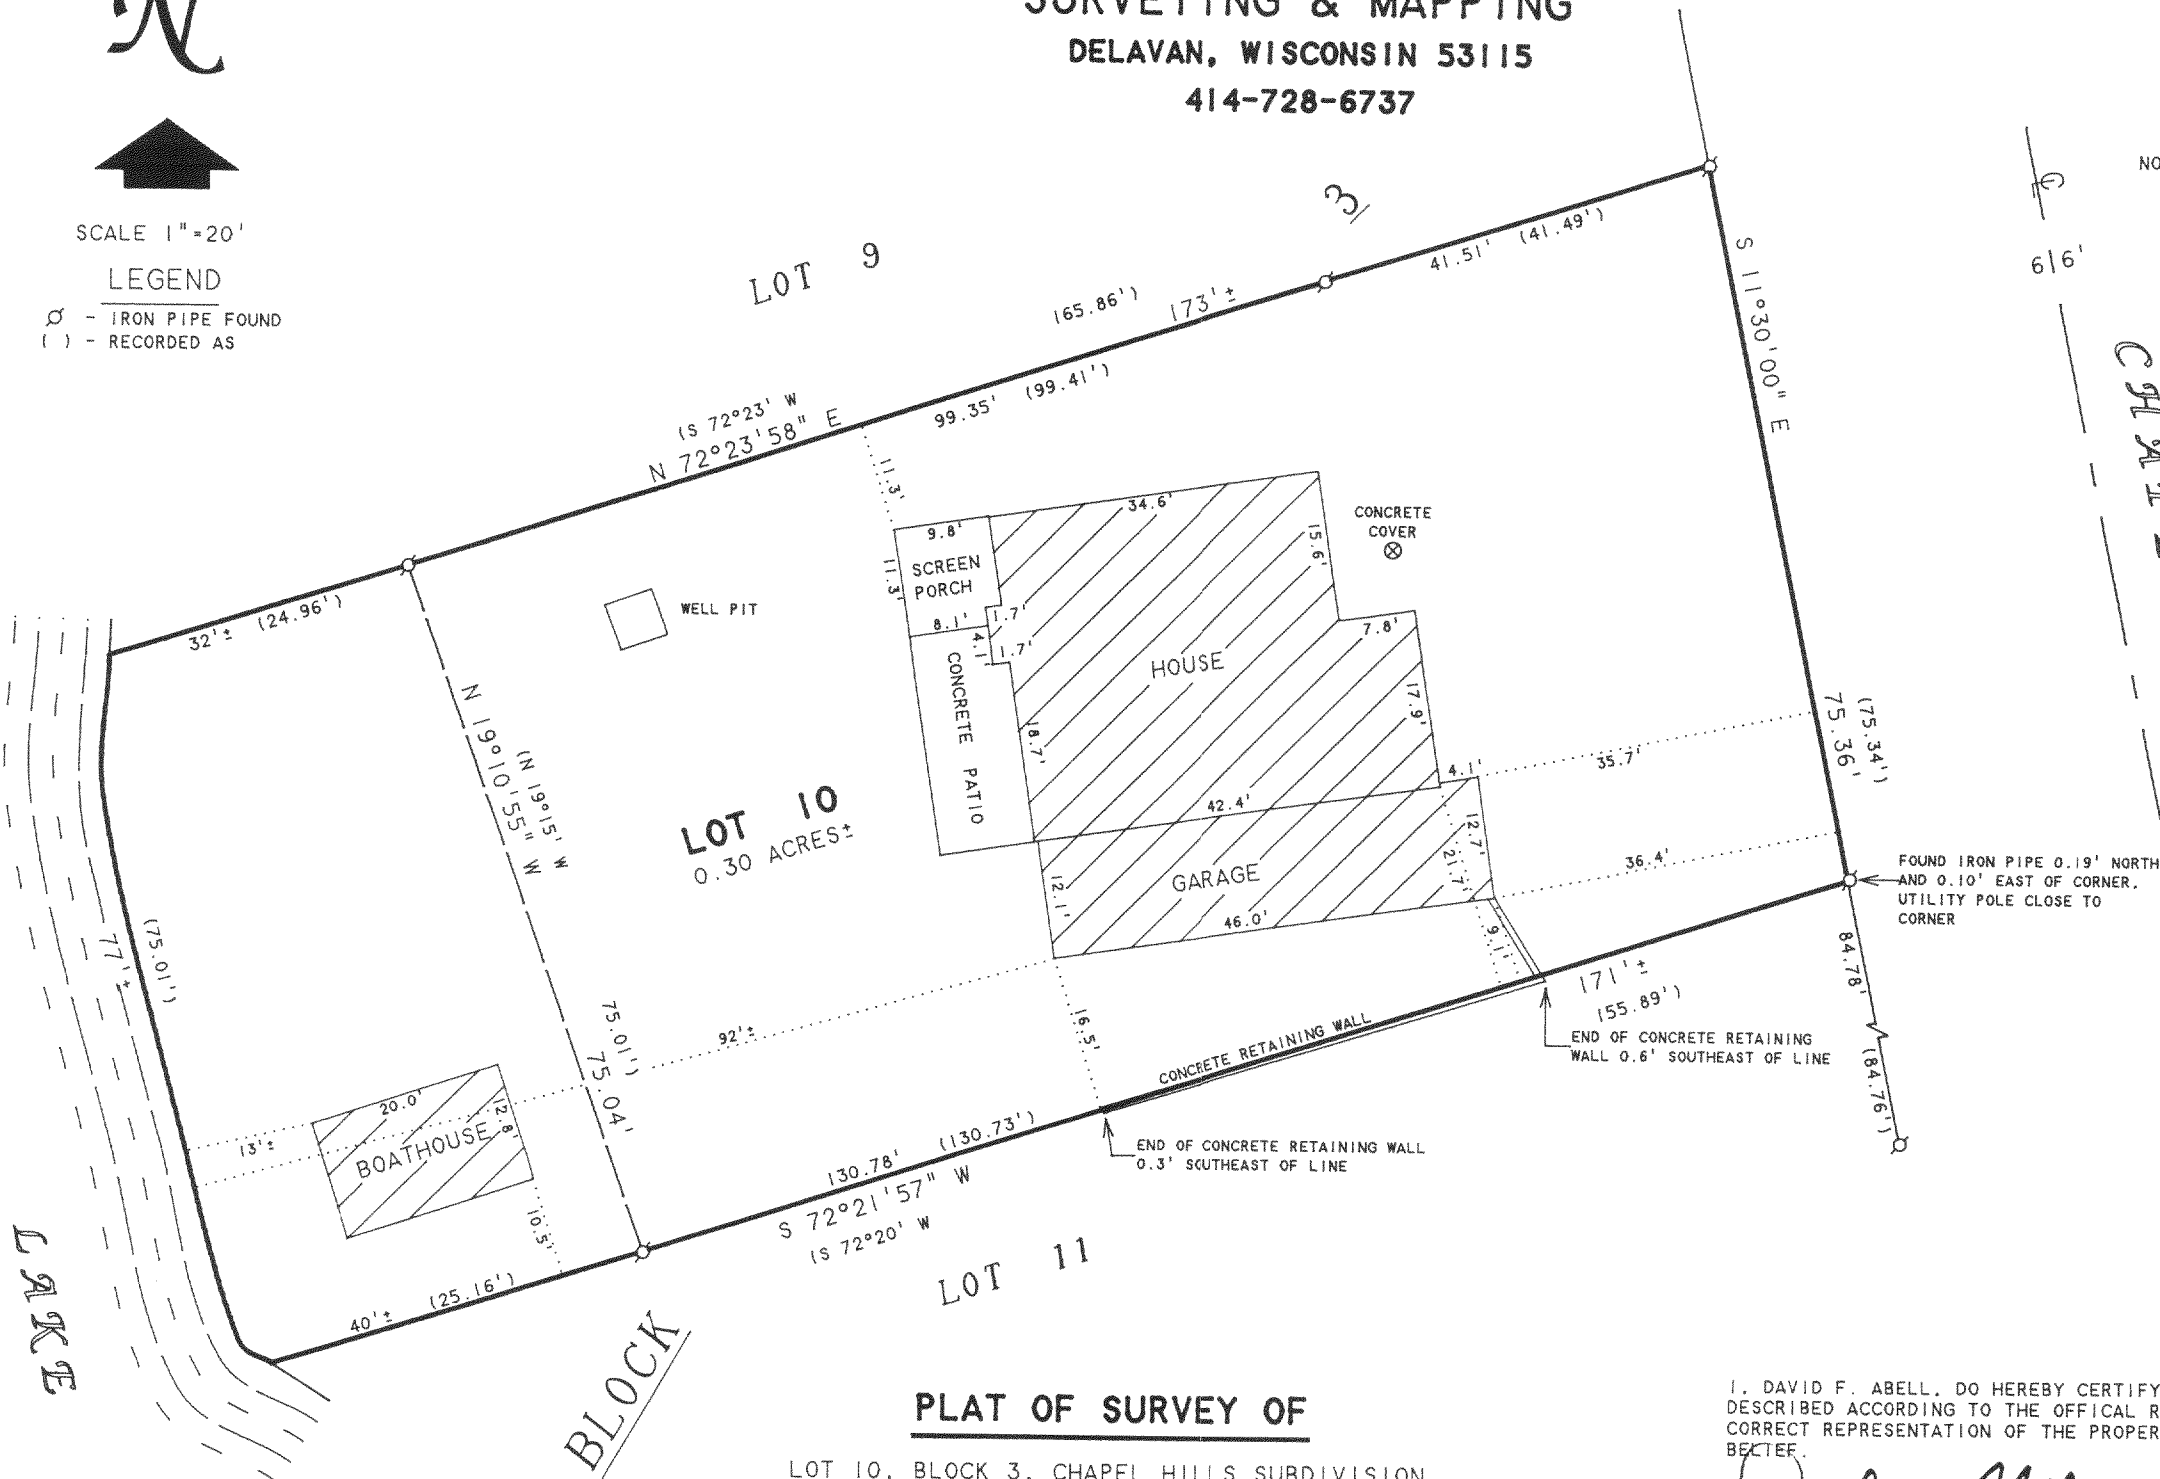

CCH-8D

315-656