
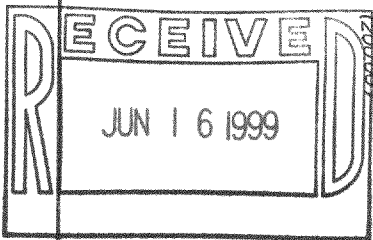


PLAT OF SURVEY
LOTS 4-6 AND 29-31, BLOCK 9, FOREST BEACH SUBDIVISION, being a part of Section 9, Town 3 North, Range 15 East, Town of Richmond, Walworth County, Wisconsin.

Surveyed for: Tinch Realty

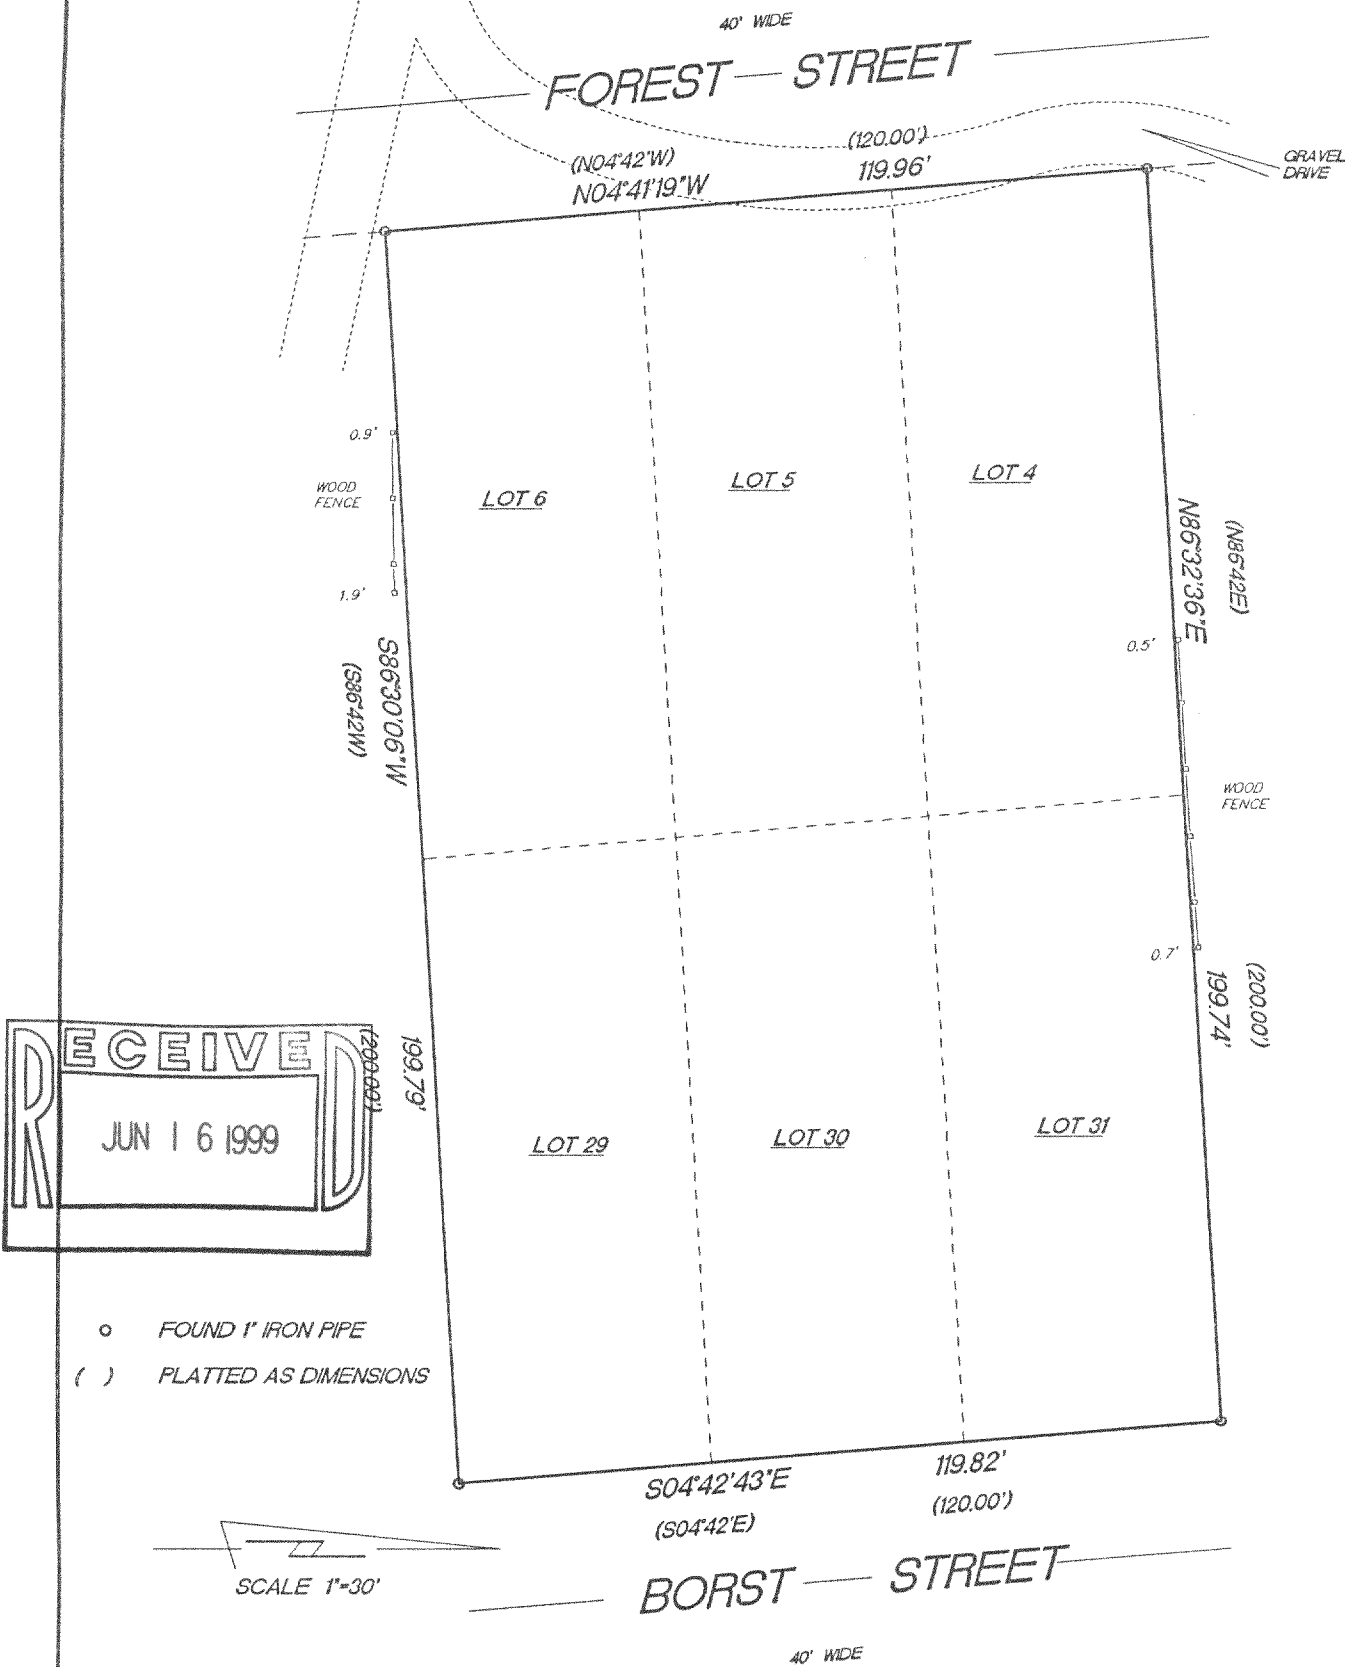


- o FOUND 1" IRON PIPE
- () PLATTED AS DIMENSIONS

"I hereby certify that I have surveyed the above described property and that the above map is a true representation thereof and shows the size and location of the property, its exterior boundaries, the location of all visible structures and dimension of all principal buildings thereon, boundary fences, apparent easements, roadways and encroachments if any."

"This survey is made for the use of the present owners of the property, and also those who purchase, mortgage or guarantee the title thereto within one year from date hereof."



W356 S9050 Godfrey Lane
P.O. Box 357
Eagle WI. 53119

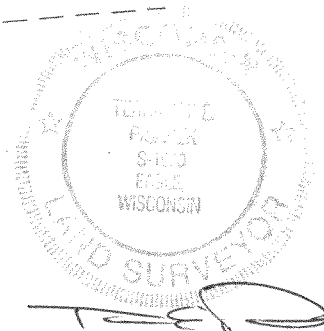

(414) 594-3484
fax (414) 594-5904

THIS IS NOT AN ORIGINAL SURVEY UNLESS THE SEAL IS RED.

5/19/99	TEP/BJ	TEP	99143
DATE	FIELD WORK BY	DRAWN BY	JOB NUMBER

CFB-54A
CFB-60A
315-663