


# PLAT OF SURVEY

That part of the NW 1/4 of Section 2, T3N, R15E, in the Town of Richmond, Walworth County, Wisconsin, bounded and described as follows: Commencing at the center of said Section, said center being 2635.68 feet S 88° 29' 23" West of the SE corner of the NE 1/4 of said Section 2; thence 88° 34' 51" West, along the South line of said NW 1/4 of said Section 2, 1311.08 feet to a point being the Southwest corner of the Southeast 1/4 of the Northwest 1/4 of said Section 2; thence North 00°24'48" West along the West line of the East 1/2 of the Northwest 1/4 of said Section 2, 424.34 feet to the point of beginning; continuing thence North 00°24'48" West along said West line, 720.00 feet to a point; thence South 49°49'59" East 727.49 feet to a point on the Northwesterly line of a 100 foot radius cul de sac; thence South 48°56'52" East 100.00 feet to the center of said cul de sac; thence South 73°32'03" West 652.92 feet to the point of beginning. Said parcel is also described as Parcel 18 of Timber Trails, unrecorded Subdivision.

Surveyed for: Tim and Darlene Stark

| RADIUS  | LENGTH    | CHORD    | BEARING       | DELTA       |
|---------|-----------|----------|---------------|-------------|
| 100.00' | 100.41'   | 96.24'   | S12°28'45"W   | 57°31'45"   |
|         | (100.39') | (96.23') | (S12°17'36"W) | (57°31'05') |


- FOUND CONC. MON.
- FOUND 1" IRON PIPE W/PLASTIC CAP
- FOUND 1" IRON PIPE
- ( ) RECORDED AS DIMENSIONS

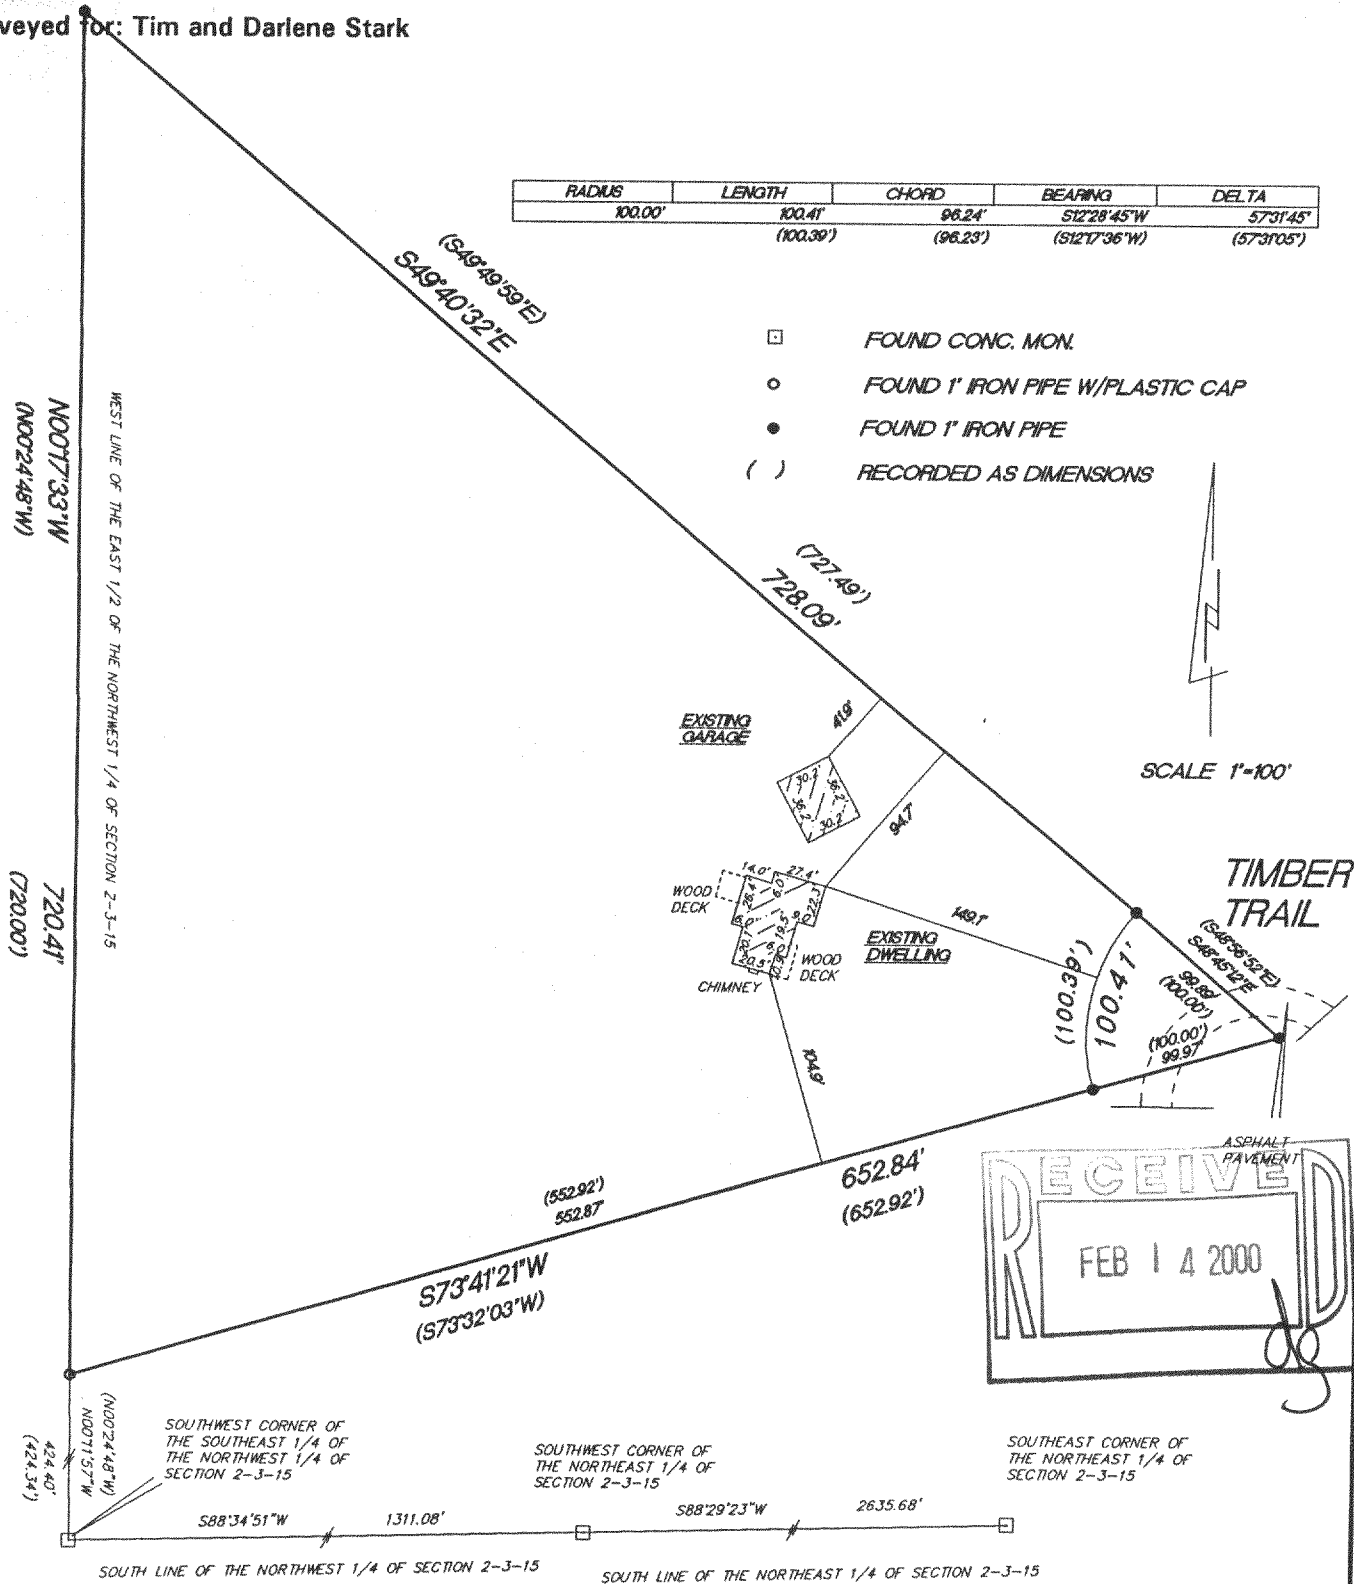

"I hereby certify that I have surveyed the above described property and that the above map is a true representation thereof and shows the size and location of the property, its exterior boundaries, the location of all visible structures and dimension of all principal buildings thereon, boundary fences, apparent easements, roadways and encroachments if any."

"This survey is made for the use of the present owners of the property, and also those who purchase, mortgage or guarantee the title thereto within one year from date hereof."

KETTLE MORaine SURVEYING  
W356 S9050 Godfrey Lane  
Eagle Wisconsin 53119  
P.O. Box 357  
(262) 594-3484  
Terrance E. Pisarek R.L.S.

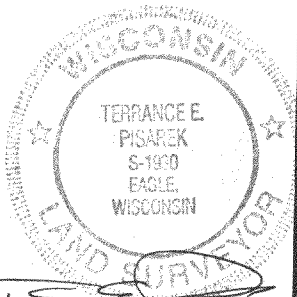

THIS IS NOT AN ORIGINAL SURVEY UNLESS THE SEAL IS RED.

1/21/00

DATE

TEP/DW

FIELD WORK BY

TEP

DRAWN BY

00012

JOB NUMBER

CR-2-26

315-698