


PLAT OF SURVEY

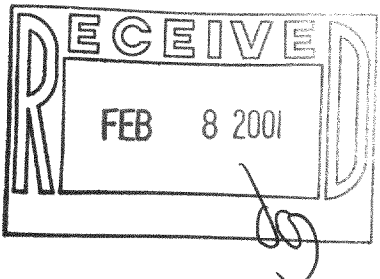

LOTS 9-16 INCLUSIVE OF
BLOCK "J" OF CRYSTAL BOWL,
A SUBDIVISION LOCATED IN
SECTIONS 12 AND 13 TOWN 3
NORTH, RANGE 15 EAST,
WALWORTH COUNTY, WISCONSIN.



ORDERED BY: CONNIE POGGENSEE
RAULAND AGENCY
P.O. BOX 159
WALWORTH, WI. 53184

OWNERS: T. SHAWN SHARPE AND JACKI SHARPE
N6424 KENOSHA DR.
DELAVER, WI. 53115
LOTS 9-12 BLOCK "J"

KRISTOPHER SHARPE
LOTS 13 - 14 BLOCK "J"

KRISTAL SHARPE
LOTS 15 - 16 BLOCK "J"

NOTE: THERE ARE (7)
INDIVIDUAL TAX PARCELS
OWNED BY (3) PARTIES.

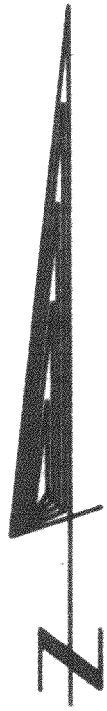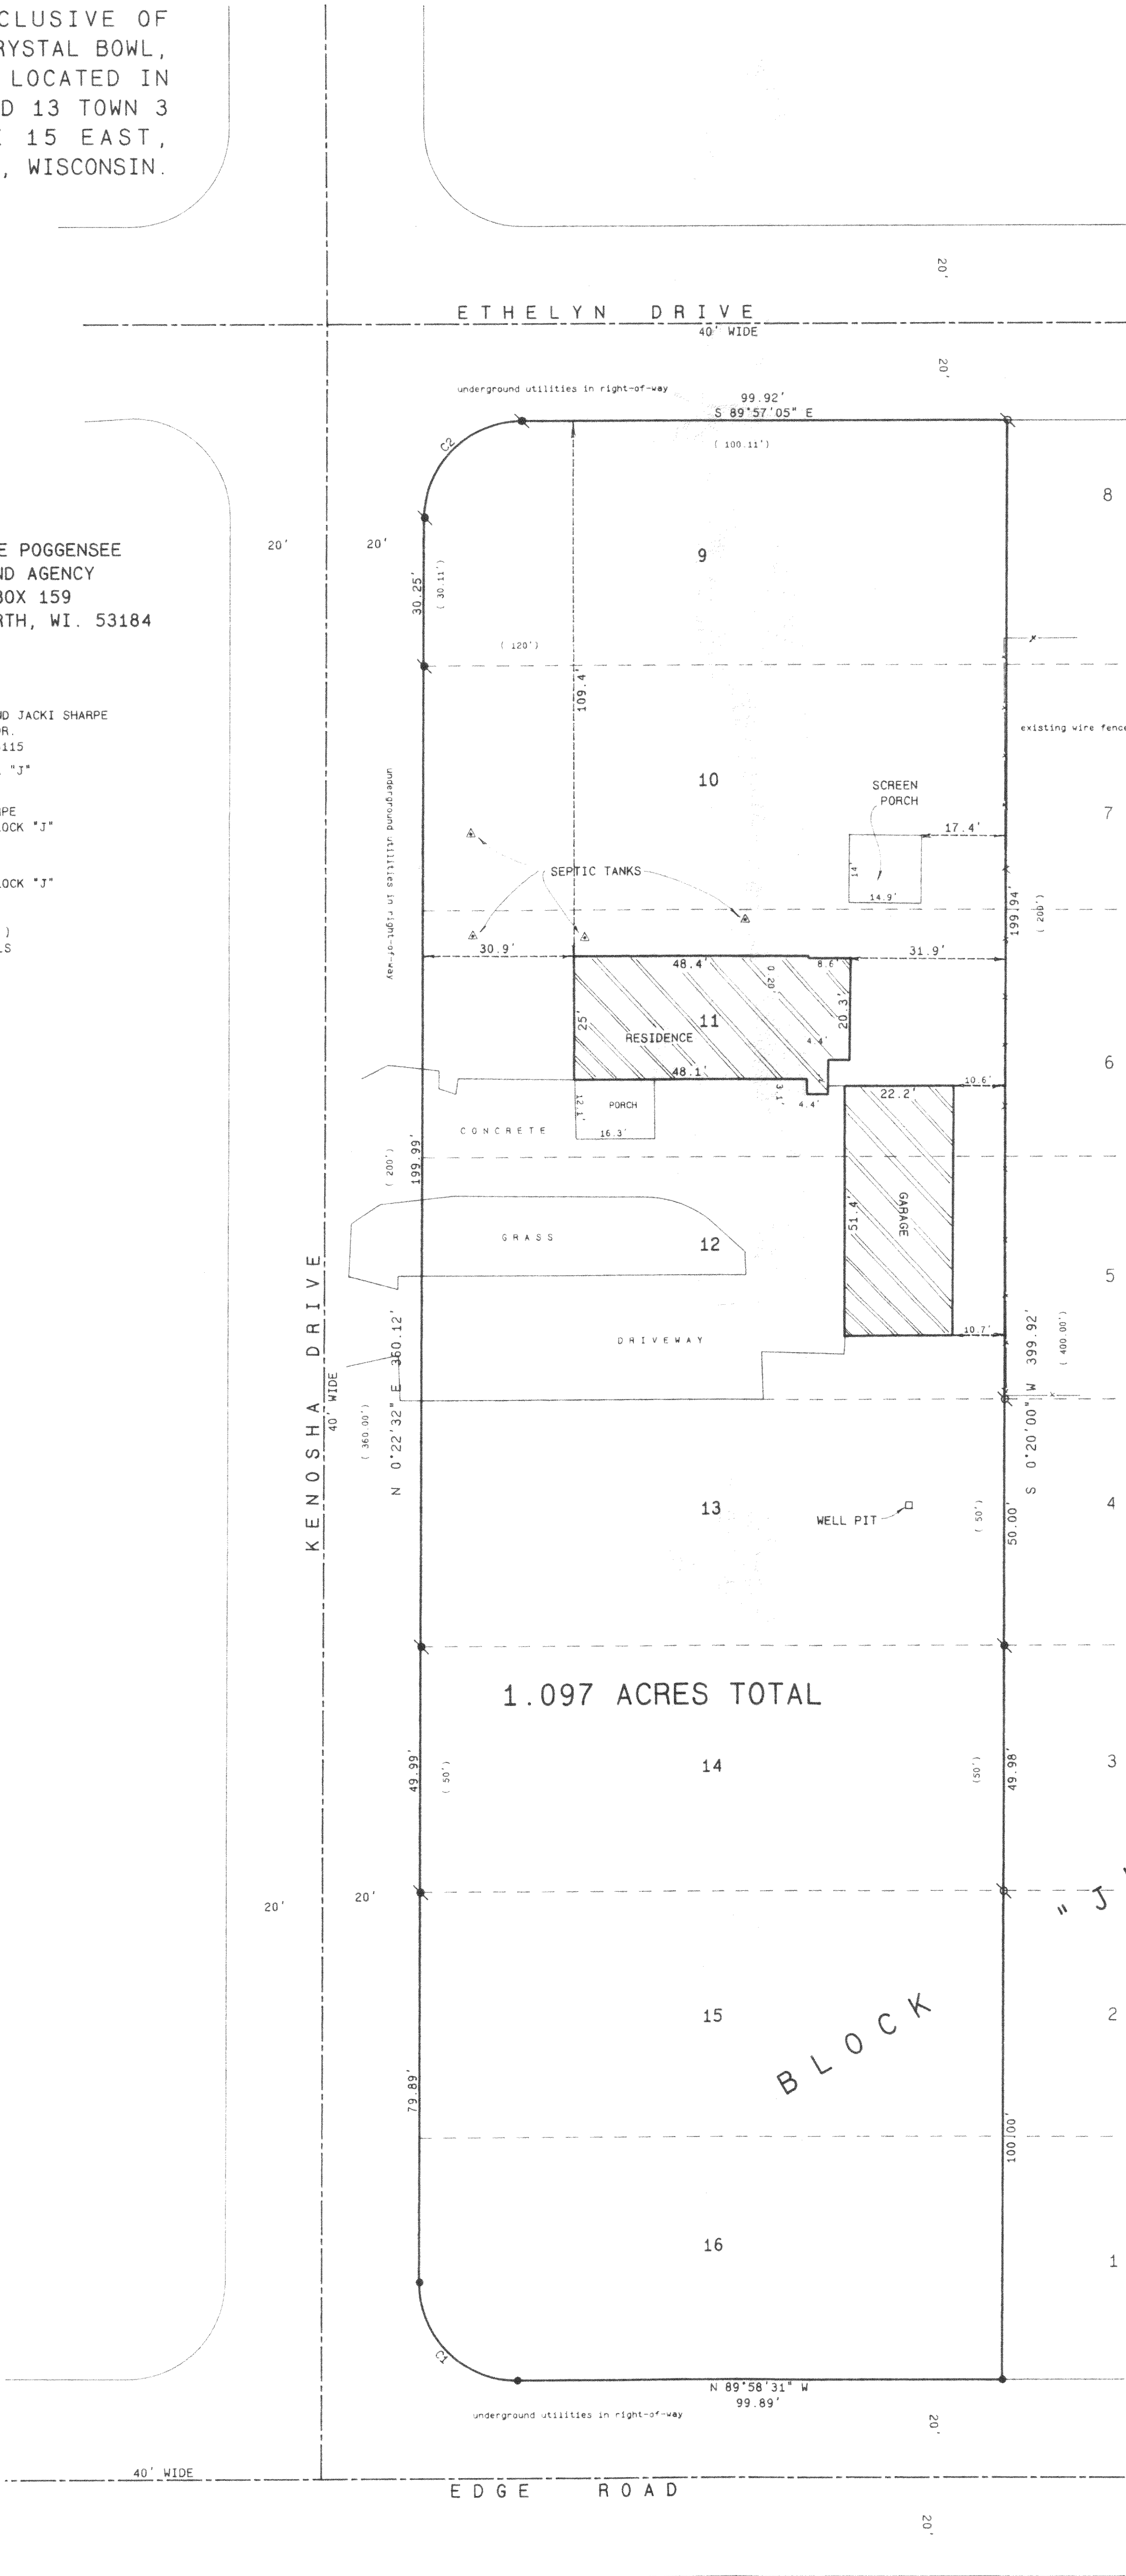

SCALE 1" = 20 FEET

THE EAST LINE OF LOTS
9-16 OF BLOCK "J" WAS
ASSUMED TO BEAR
N 0°20'00" E AS SHOWN
ON PREVIOUS PLATS OF
SURVEYS IN THIS BLOCK.

- Legend
- FOUND IRON PIPE
 - FOUND IRON ROD
 - FOUND BRASS CAPPED MONUMENT
 - FOUND CONCRETE MONUMENT
 - CHISEL CUT IN CONCRETE
 - SET IRON ROD, 3/4" LONG, WEIGHING 1.5 LBS., LINEAL FT., 1-1/2" DIA.
 - SET IRON ROD, 30" LONG, WEIGHING 4.5 LBS., LINEAL FT., 1-1/2" DIA.
 - RECORDED AS DIMENSION
 - EXISTING FENCE

CURVE	ARC	DELTA	RADIUS	CHORD LENGTH	CHORD BEARING
C1	31.57	90°26'00"	20.00	28.39	N 44°53'30" W
C2	31.12	89°09'17"	20.00	28.07	N 45°21'33" E



SCALE: 1"= 20 FEET

I hereby certify that the above described property has been surveyed by me or under my direction and that the above map is a true representation thereof and shows the size and location of the property, its exterior boundaries, the location of all visible structures and dimensions of all principal buildings thereon, boundary fences, apparent easements, roadways and visible encroachments, if any.

This survey is made for the use of the present owners of the property and also those who purchase, mortgage, or guarantee the title thereto within one year from date hereof.

Kenneth B. Abernathy, Jr.
KENNETH B. ABERNATHY, JR.
WISCONSIN REGISTERED LAND SURVEYOR,
S-1594
Date: OCTOBER 4, 2000 Job No. 00.1002

CCR-161
CCR-162
CCR-163
CCR-164
CCR-165
CCR-166
CCR-167

315-731