


ABERNATHY and ASSOCIATES

Kenneth B. Abernathy Jr.

Wisconsin Registered Land Surveyor S-1594

W4056 BRAY RD.
ELKHORN, WI. 53121
PHONE: (262) 723-4260 (OFFICE)
(262) 723-7209 (FAX)
Email: abernathy@elknet.net

PLAT OF SURVEY

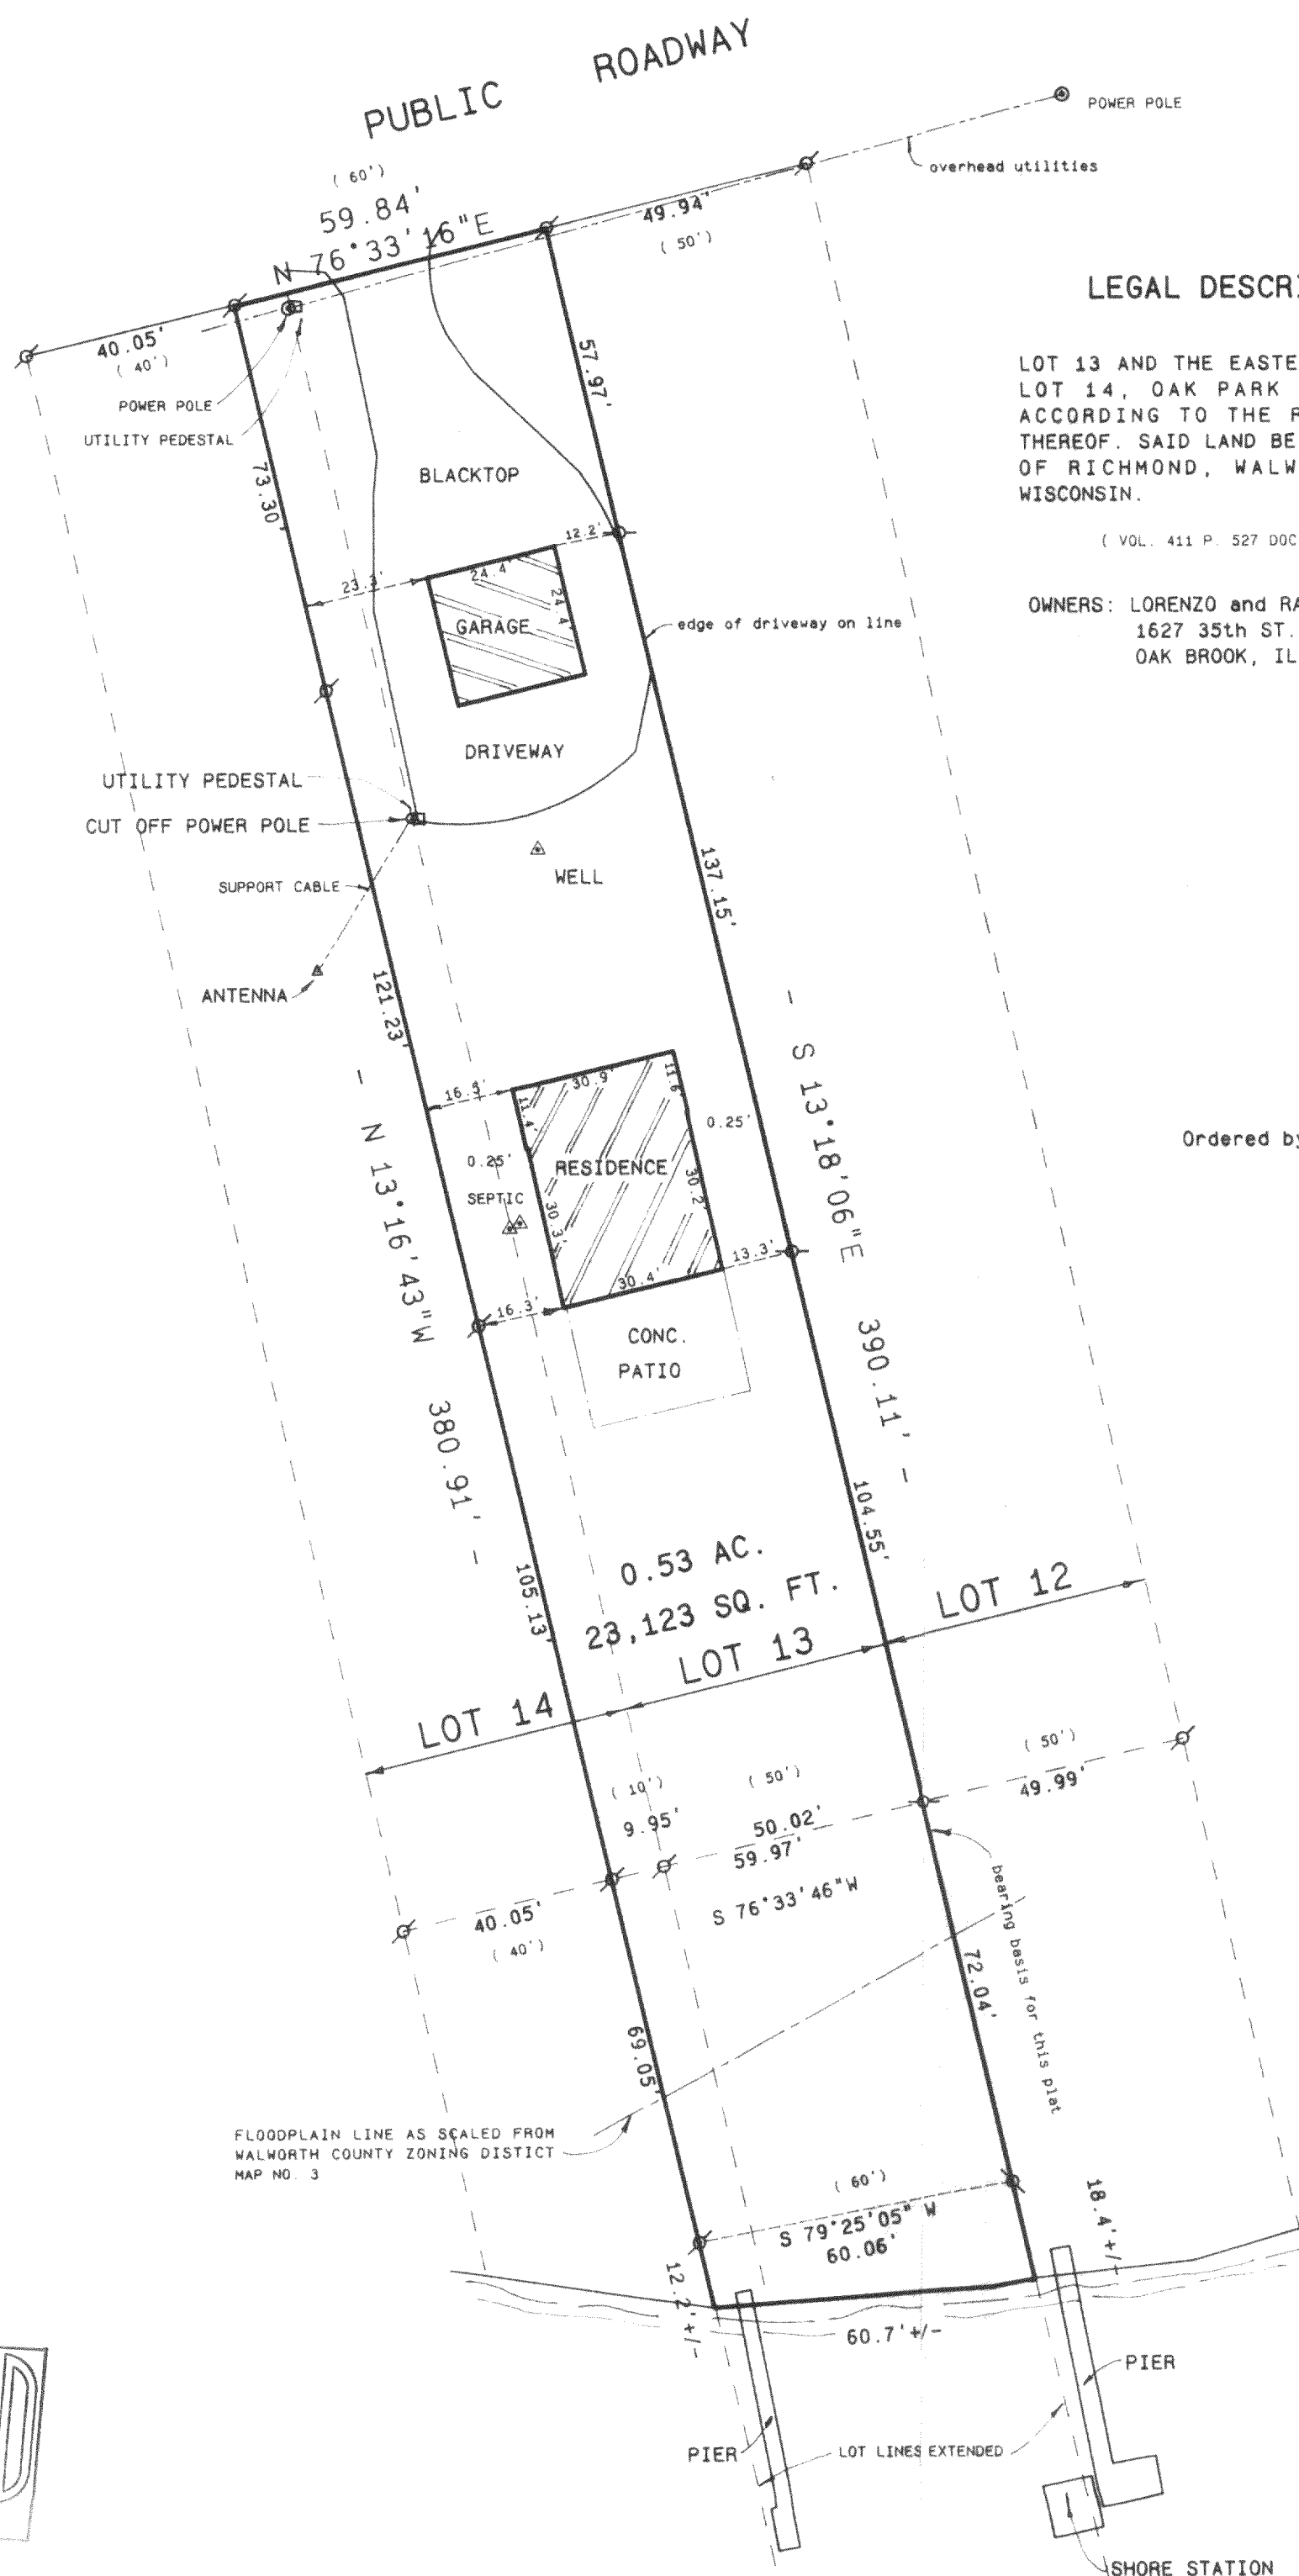


LEGAL DESCRIPTION:

LOT 13 AND THE EASTERLY 10 FEET OF
LOT 14, OAK PARK SUBDIVISION,
ACCORDING TO THE RECORDED PLAT
THEREOF. SAID LAND BEING IN THE TOWN
OF RICHMOND, WALWORTH COUNTY,
WISCONSIN.

(VOL. 411 P. 527 DOC. NO. 152587)


OWNERS: LORENZO and RACHEL BARBA
1627 35th ST.
OAK BROOK, IL. 60523

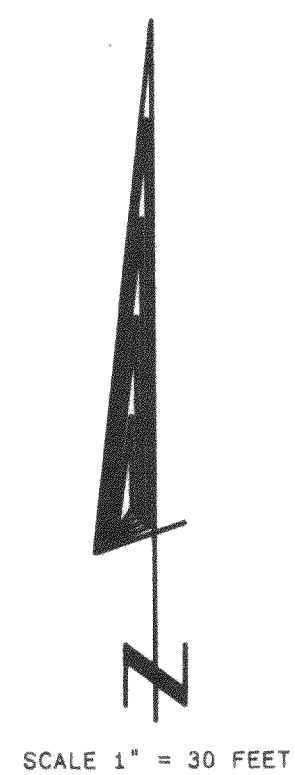

Ordered by: Attorney Robert C. Leibsle
Godfrey, Leibsle, Conover, Blackburn & Howarth, S.C.
11 North Wisconsin Street
Elkhorn, Wisconsin 53121

Legend

- FOUND IRON PIPE
- FOUND IRON ROD
- FOUND BRASS CAPPED MONUMENT
- ✱ FOUND CONCRETE MONUMENT
- + CHISEL CUT IN CONCRETE
- SET IRON ROD, 24" LONG, WEIGHING 1.5 LBS./LINEAL FT., 3/4" DIA.
- SET IRON ROD, 30" LONG, WEIGHING 4.5 LBS./LINEAL FT., 1-11/16" DIA.
- (xx) RECORDED AS DIMENSION
- - - EXISTING FENCE

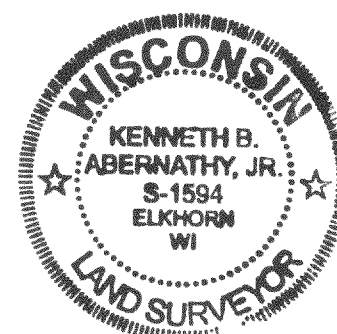


SCALE: 1" = 30 FEET

I hereby certify that the above described property has been surveyed
by me or under my direction and that the above map is a true
representation thereof and shows the size and location of the property,
its exterior boundaries, the location of all visible structures and
dimensions of all principal buildings thereon, boundary fences, apparent
easements, roadways and visible encroachments, if any.
This survey is made for the use of the present owners of the property,
and also those who purchase, mortgage, or guarantee the title thereto
within one year from date hereof.

Kenneth B. Abernathy, Jr.

KENNETH B. ABERNATHY, JR.
WISCONSIN REGISTERED LAND SURVEYOR,
S-1594

Date: SEPT. 11, 2001 Job No. 01.905

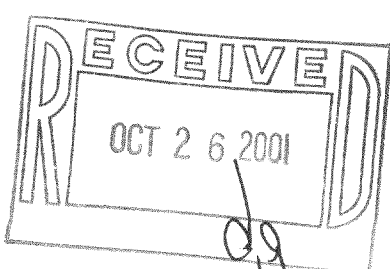

TURTLE LAKE

315-755