


ABELL
SURVEYING & MAPPING

1140 SEQUOIA STREET • DELAVAN, WISCONSIN 53115
262-728-6737

SHORE WOOD TERRACE

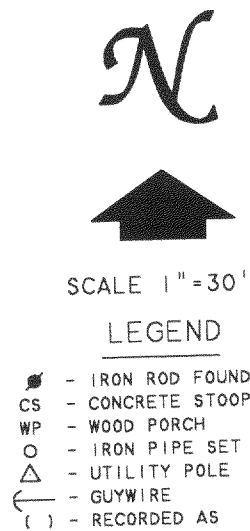

BLOCK

LOT 8

LANDSCAPE AREA ON LOT 8
EXTENDS 1.3'-2.1' ONTO
LOT 7

LOT 7

HOUSE

WOOD DECK

LOT 6

FLAGPOLE

WELL

LOT 5

LOT 4

LOT 3

LOT 2

PLAT OF SURVEY OF

LOTS 3-7, BLOCK "B", CRYSTAL BOWL SUBDIVISION,
LOCATED IN T3N, R1E, WALWORTH COUNTY, WISCONSIN,
CONTAINING 0.71 ACRES.

ORDERED BY: ROGER BEHRENS
2825 BELMONT AVE.
CHICAGO, IL 60618


I HEREBY CERTIFY THAT I HAVE SURVEYED THE ABOVE DESCRIBED PROPERTY AND THAT THE ABOVE MAP IS A TRUE REPRESENTATION THEREOF AND SHOWS THE SIZE AND LOCATION OF THE PROPERTY, ITS EXTERIOR BOUNDARIES, THE LOCATION OF ALL VISIBLE STRUCTURES AND DIMENSIONS OF ALL PRINCIPAL BUILDINGS THEREON, BOUNDARY FENCES, APPARENT EASEMENTS, ROADWAYS AND VISIBLE ENCROACHMENTS, IF ANY, TO THE BEST OF MY KNOWLEDGE AND BELIEF.

THIS SURVEY IS MADE FOR THE USE OF THE PRESENT OWNERS OF THE PROPERTY, AND ALSO THOSE WHO PURCHASE, MORTGAGE, OR GUARANTEE THE TITLE THERETO WITHIN ONE (1) YEAR FROM DATE HEREON.

David F. Abell
DAVID F. ABELL
WISCONSIN REGISTERED LAND SURVEYOR, S-1596

April 23, 2002
DATE
NOTE: THIS IS NOT A CERTIFIED COPY UNLESS SEALED.

JOB NUMBER - 02043

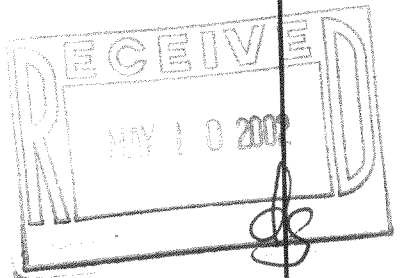

COUNTY TRUNK HIGHWAY "P"

CCR-17
CCR-18

315-768