




CSA - 88A CSA - 88B CSA - 88C CSA - 88D
CSA - 88E CSA - 88F CSA - 88G CSA - 88H
CSA - 88I CSA - 88J CSA - 88K CSA - 88L
CSA - 88M CSA - 88N CSA - 88O CSA - 88P
CSA - 88Q CSA - 88R CSA - 88S CSA - 88T
CSA - 88U CSA - 88V CSA - 88W CSA - 88X
CSA - 88Y CSA - 88Z

Plat of Survey

Lots 1 through 6 and 22 through 28 of Block 6, Lots 1 through 7 of Block 7 and a portion of vacated Linden Road,

all in Skansen Swedish Tribune-News First Addition, located in the Southwest 1/4 of Section 9, Town 3 North, Range 15 East, Town of Richmond, Walworth County, Wisconsin.

Surveyed for: **Robert Steinert**
755 North Pratt Street • Lot 184
Whitewater, Wisconsin. 53190

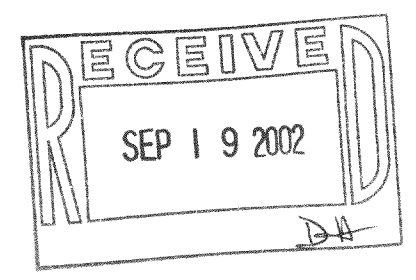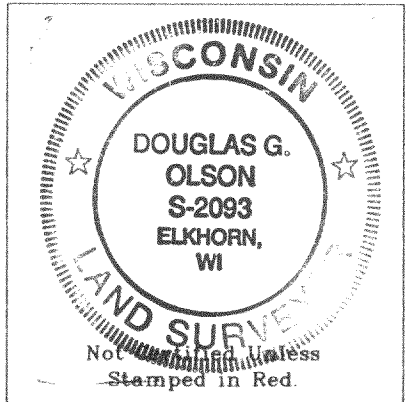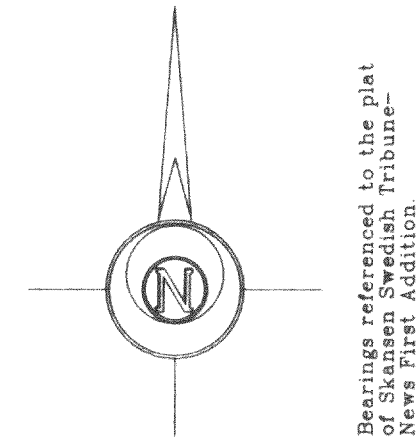


- Notes: 1) This survey plat is not certified unless signed and sealed in red ink.
- 2) This survey is subject to Wisconsin lien laws. This Plat of Survey is the notice of intent to file lien. Lien waiver required.

Copyright © 2001 by Jensen & Olson Land Surveying, LLC.


All rights reserved. No part of this survey plat may be reproduced or transmitted in any form by any means - graphic, electronic, or mechanical, including photocopying, tracing, or information storage and retrieval systems - without permission in writing from Douglas G. Olson, Jensen & Olson Land Surveying, LLC.

I, Douglas G. Olson, Wisconsin Registered Land Surveyor, do hereby certify that this survey was performed by me or under my direction in full compliance with the owner's/agent's instructions and Chapter A-E 7 of the Wisconsin Administrative Code "Minimum Standards for Property Surveys"; and that this map is an accurate representation thereof to the best of my knowledge and belief.

Douglas G. Olson
Wisconsin Registered Land Surveyor - 2093

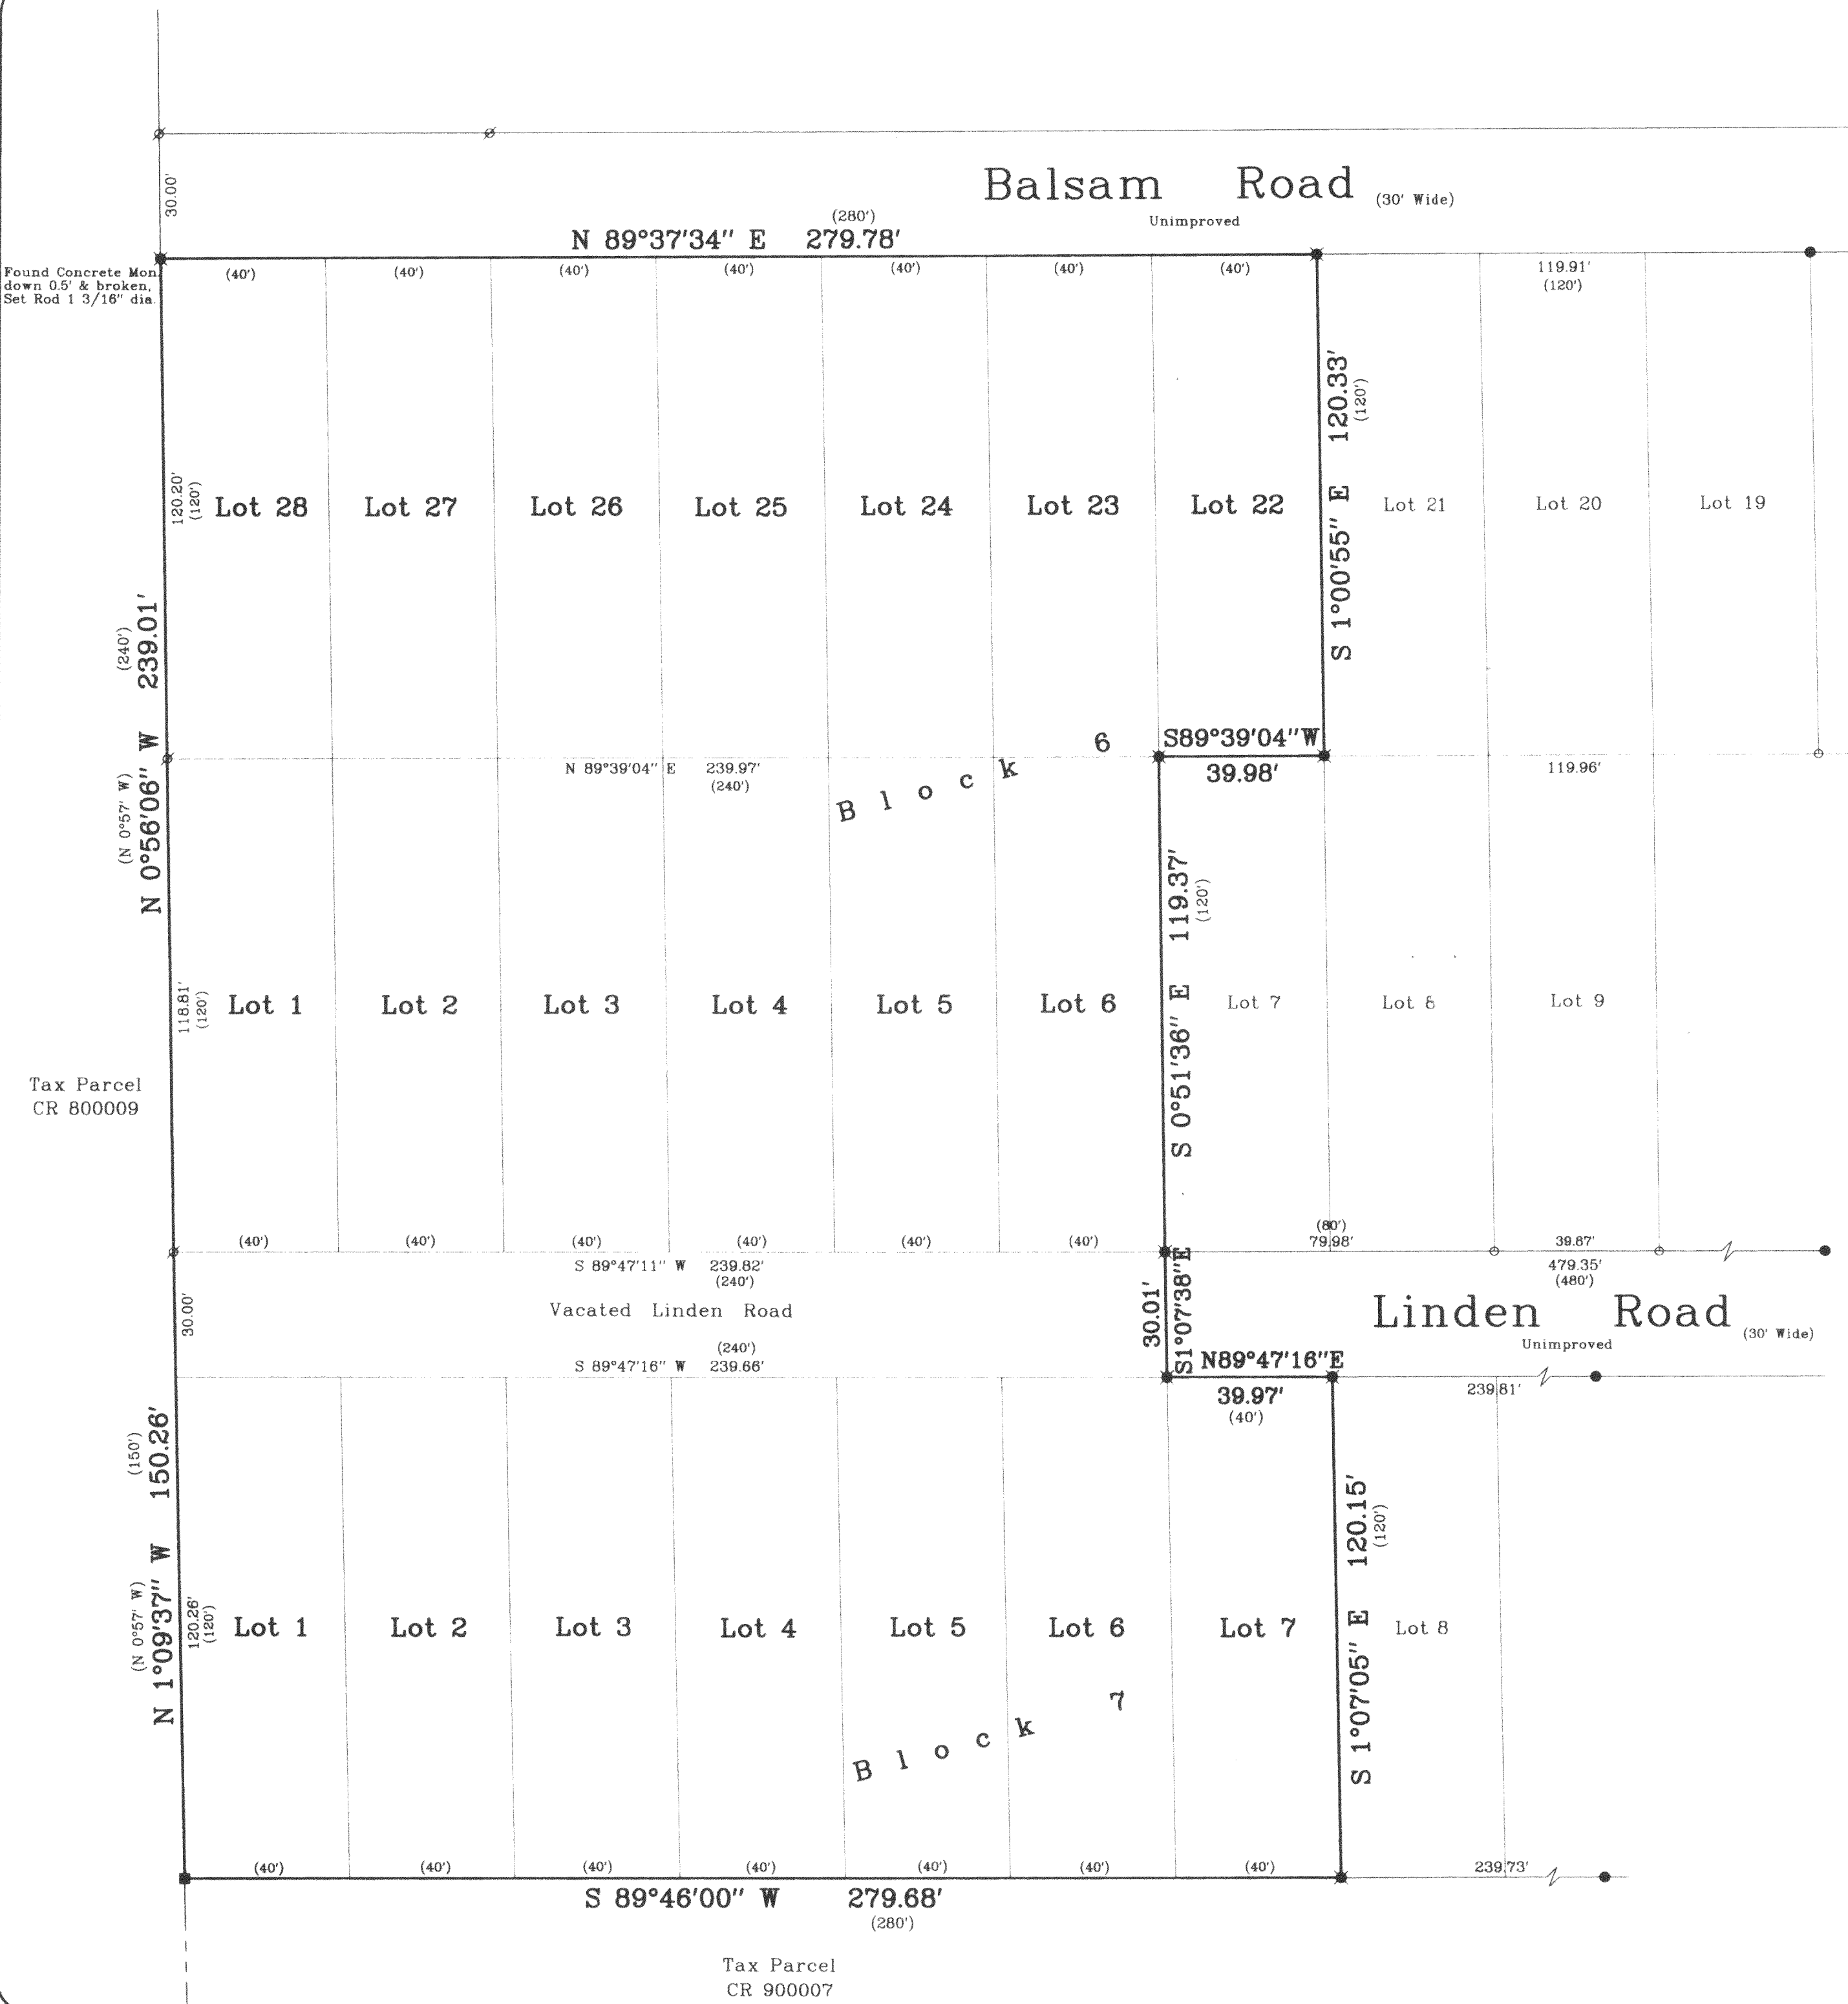

Survey Date: April 24, 2001.
Revisions:

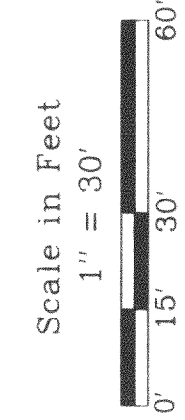

Jensen & Olson Land Surveying, LLC
45 South Wisconsin Street P.O. Box 322
Elkhorn, Wisconsin 53121
Telephone (262) 723-3434
Facsimile (262) 723-8044

Legend
Found Concrete Monument
Found Iron Pipe
Found Iron Rod
Found Posey Pin
Set Iron Rod 3/4" dia.
Recorded Information

Sheet 1 of 1 Sheets
Job Reference Number
2001.050
2001.050